PARENT PARCEL: 06-24-140-000-005, 06-24-150-000-001

CHILD PARCEL: XX-XX-XXX-XXX-XXX

STARTING POINT: INTERSECTION OFC/L OF LESNICK CT. AND WEST LINE OF O.L.151

16-03555-D

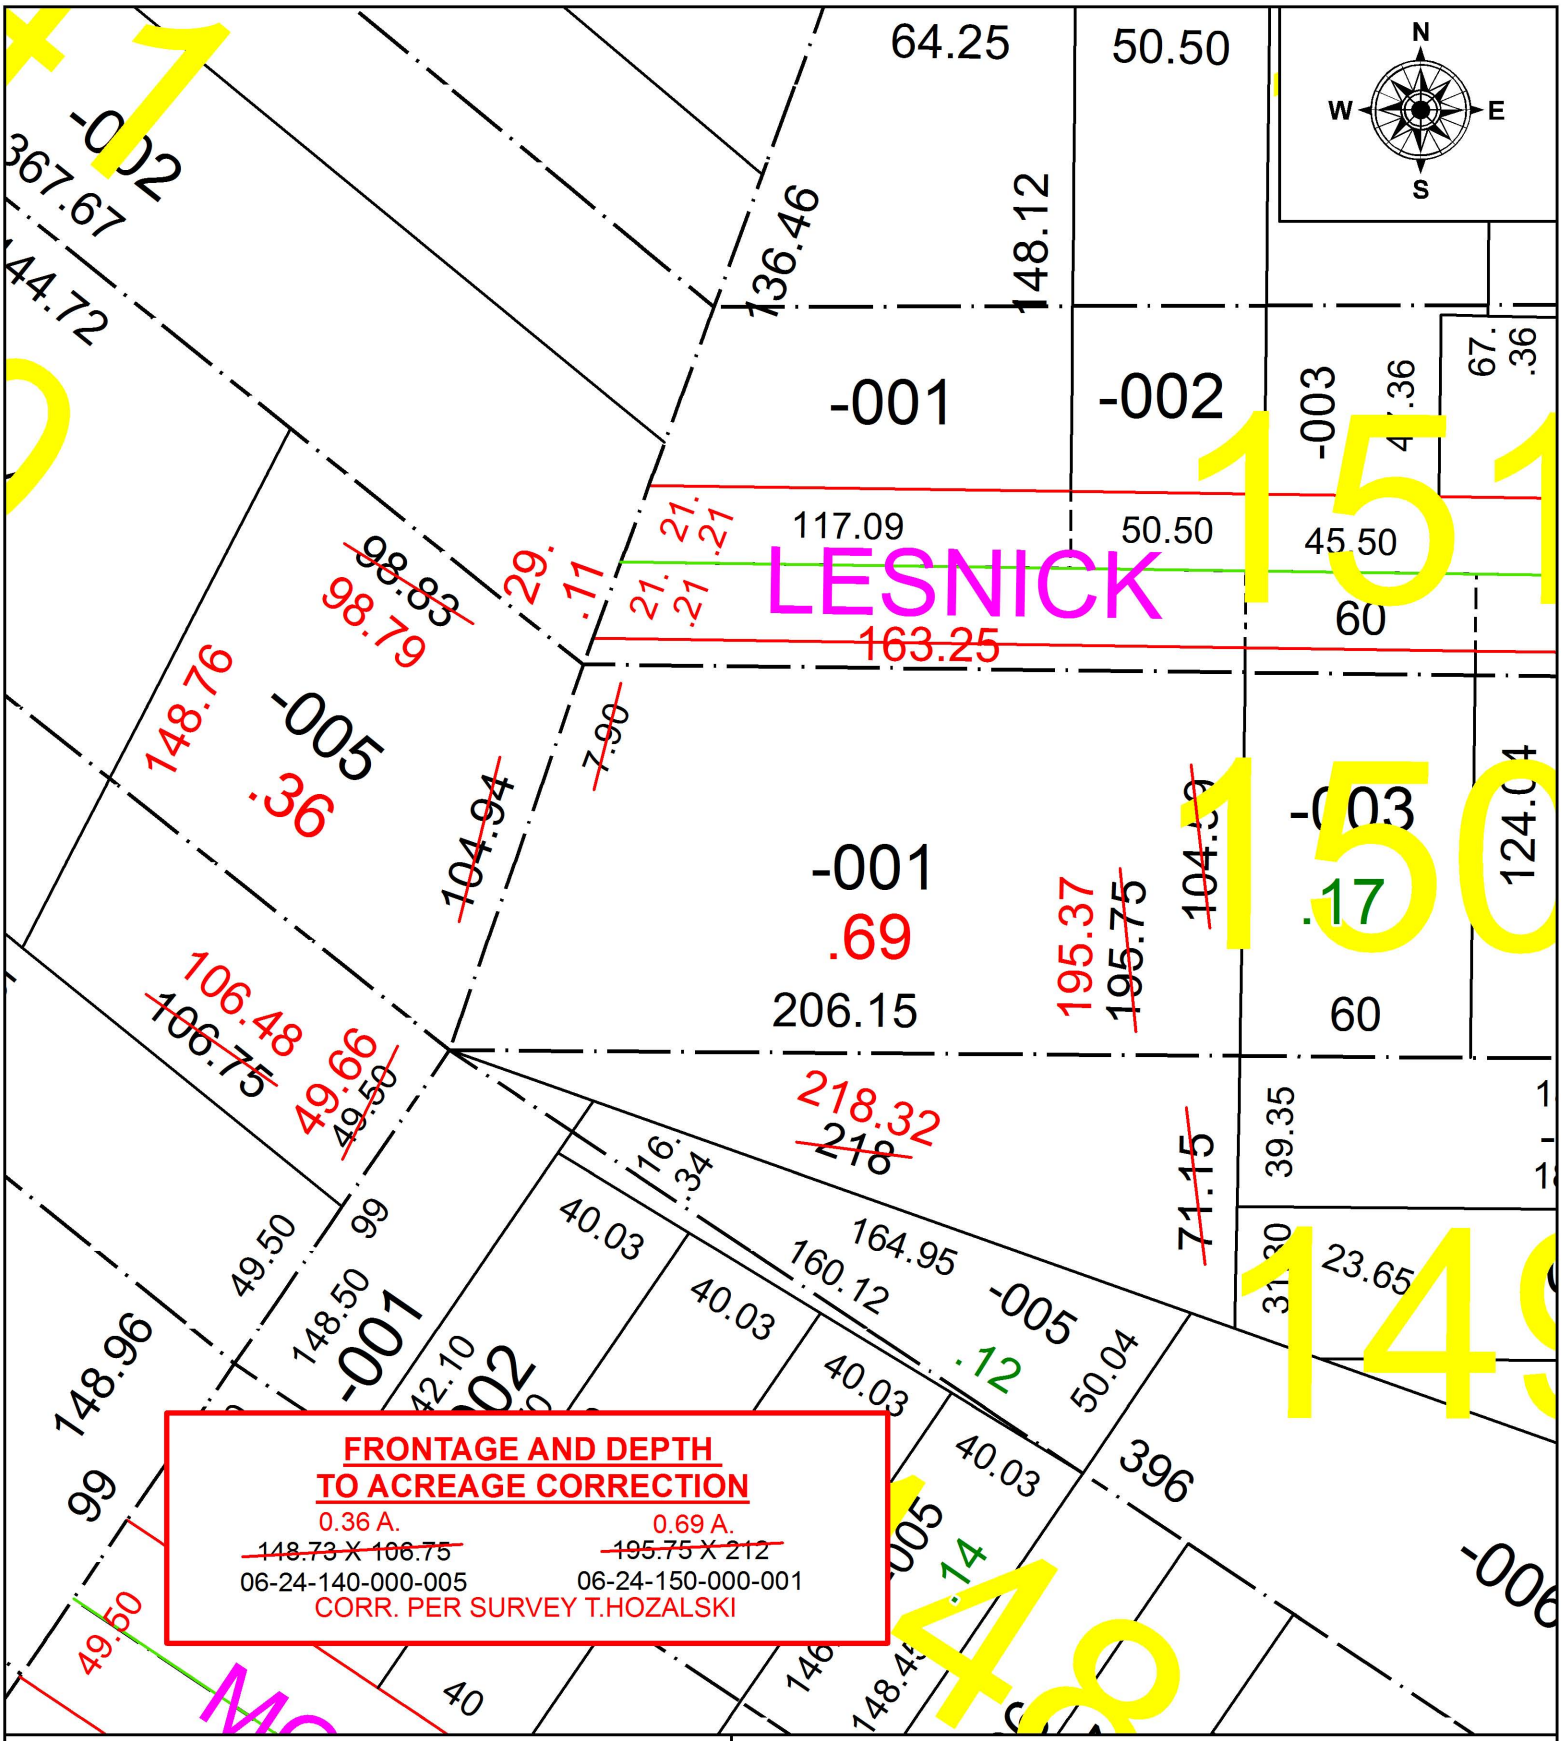

FRONTAGE AND DEPTH TO ACREAGE CORRECTION

0.36 A.	0.69 A.
~~148.73 X 106.75~~	~~195.75 X 212~~
06-24-140-000-005	06-24-150-000-001

CORR. PER SURVEY T.HOZALSKI

SPLITS/DEEDS PROCESSED

LORAIN COUNTY TAX MAP DEPARTMENT
226 MIDDLE AVE. ELYRIA, OH

SURVEYED BY: TIMOTHY D. HOZALSKI
CLOSURE: 1: 140,256
MAP PAGE(S): 6-100
APPOVED BY: RRM **DATE:** 11-16-16
SCALE: 1" = 50 **PRIOR INSTRUMENT:** 20030919091