PARENT PARCEL: 04-00-006-101-005, -006, -007

CHILD PARCEL: 04-00-006-101-007, -087

STARTING POINT: INTERSECTION OF C/L OF LAKE RD. AND WEST LINE OF SECTION 6

16-03556-D

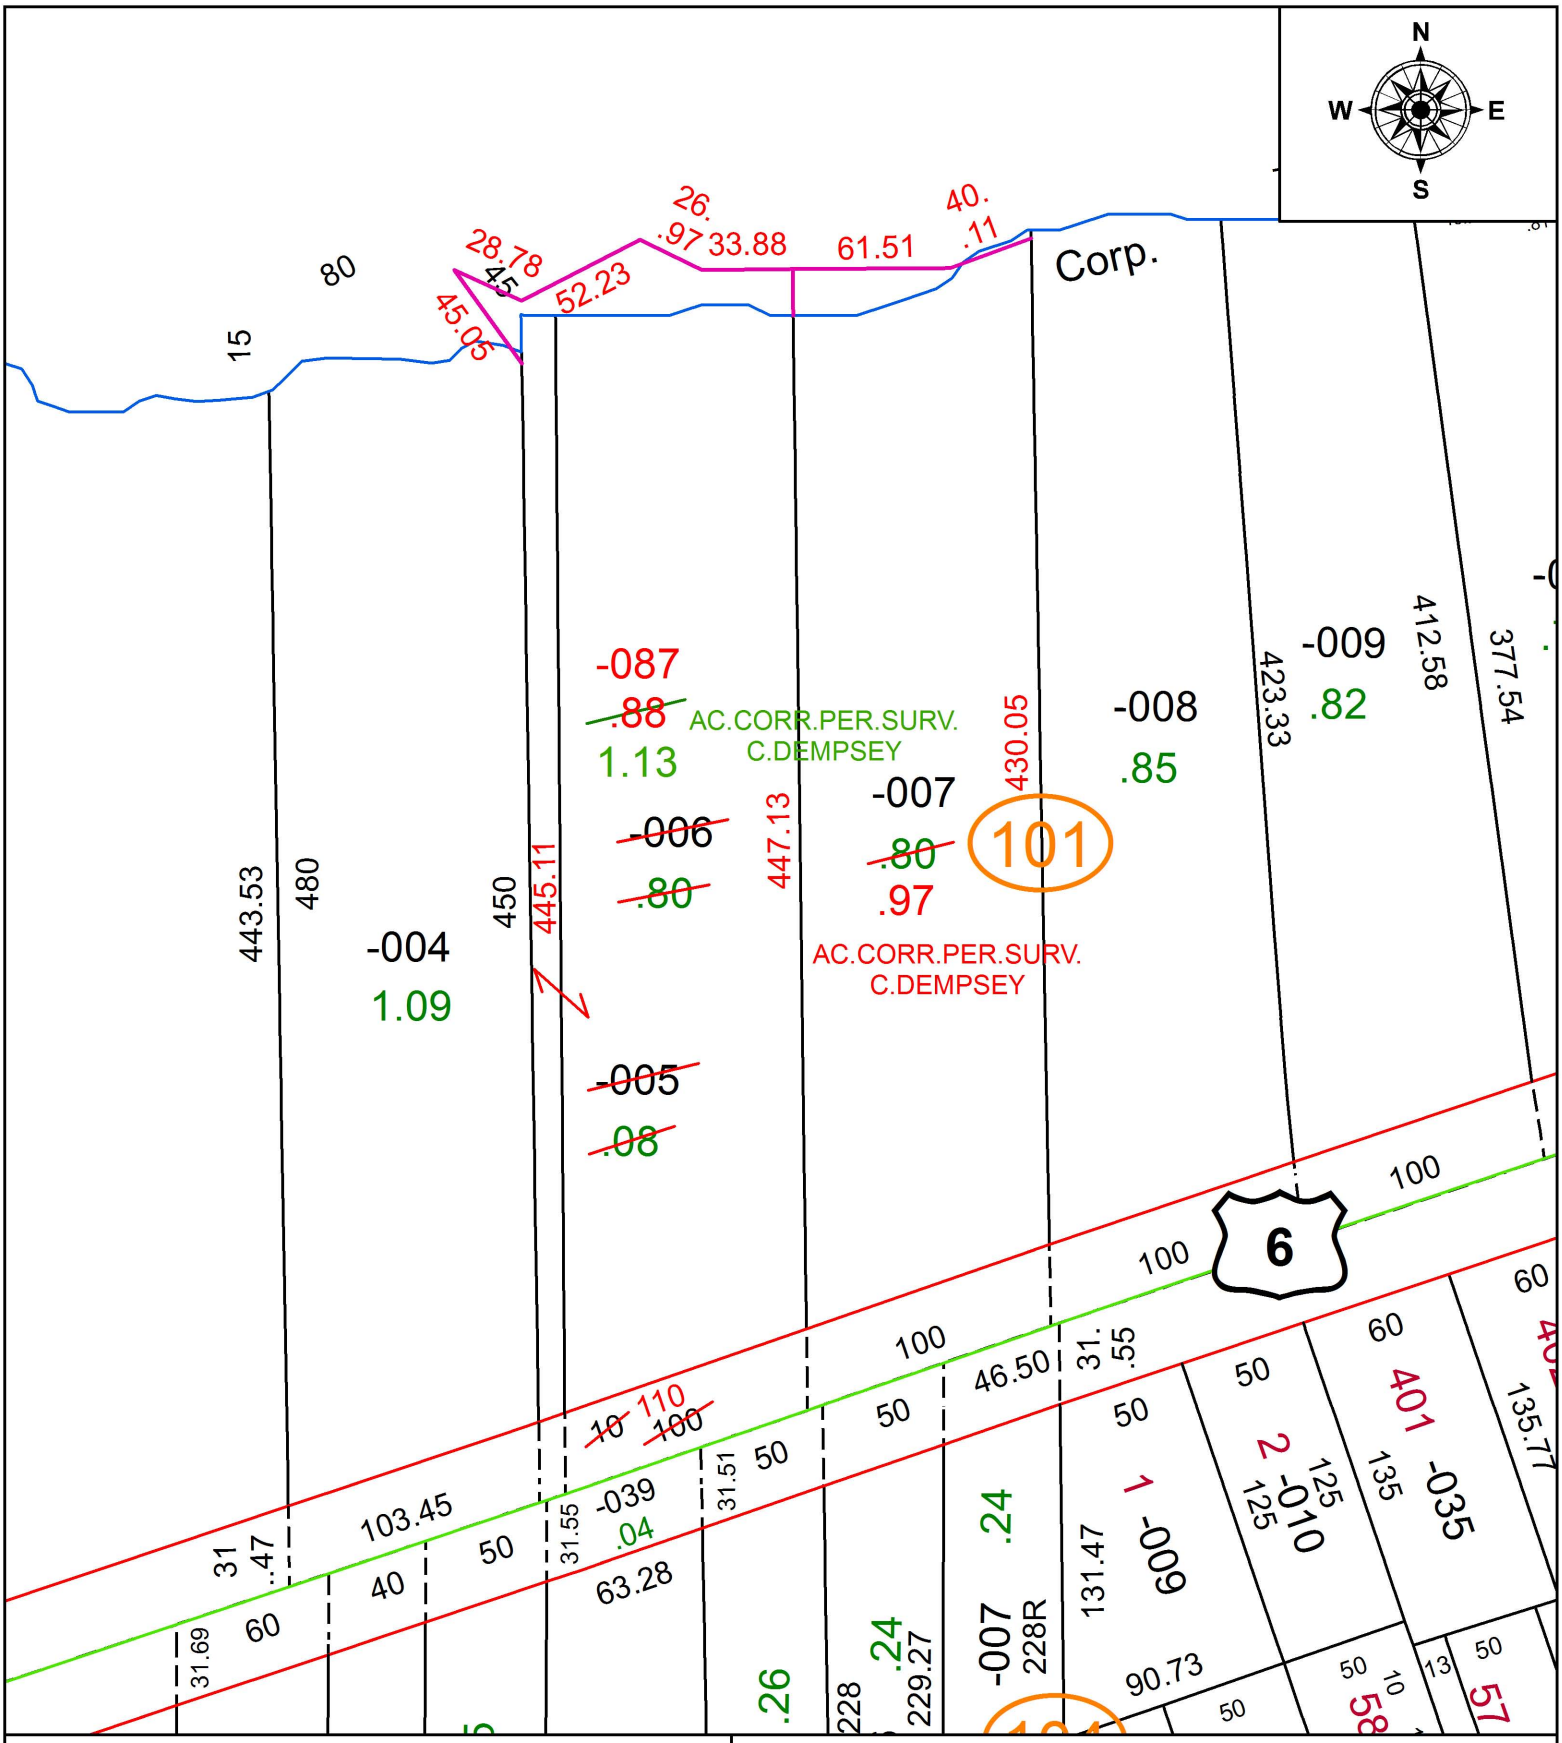

SPLITS/DEEDS PROCESSED

LORAIN COUNTY TAX MAP DEPARTMENT
226 MIDDLE AVE. ELYRIA, OH

SURVEYED BY: CHRISTOPHER J. DEMPSEY
CLOSURE: 1: 282,557
MAP PAGE(S): 4-00-006
APPOVED BY: RRM **DATE:** 11-18-16
SCALE: 1" = 75 **PRIOR INSTRUMENT:** 20140514881