PARENT PARCEL: 05-00-006-000-245
CHILD PARCEL: 05-00-006-000-246,-247
STARTING POINT: INTERSECTION OF SOUTH LINE OF MIDDLE RIDGE RD. AND WEST LINE OF TOWER LN.

16-03557

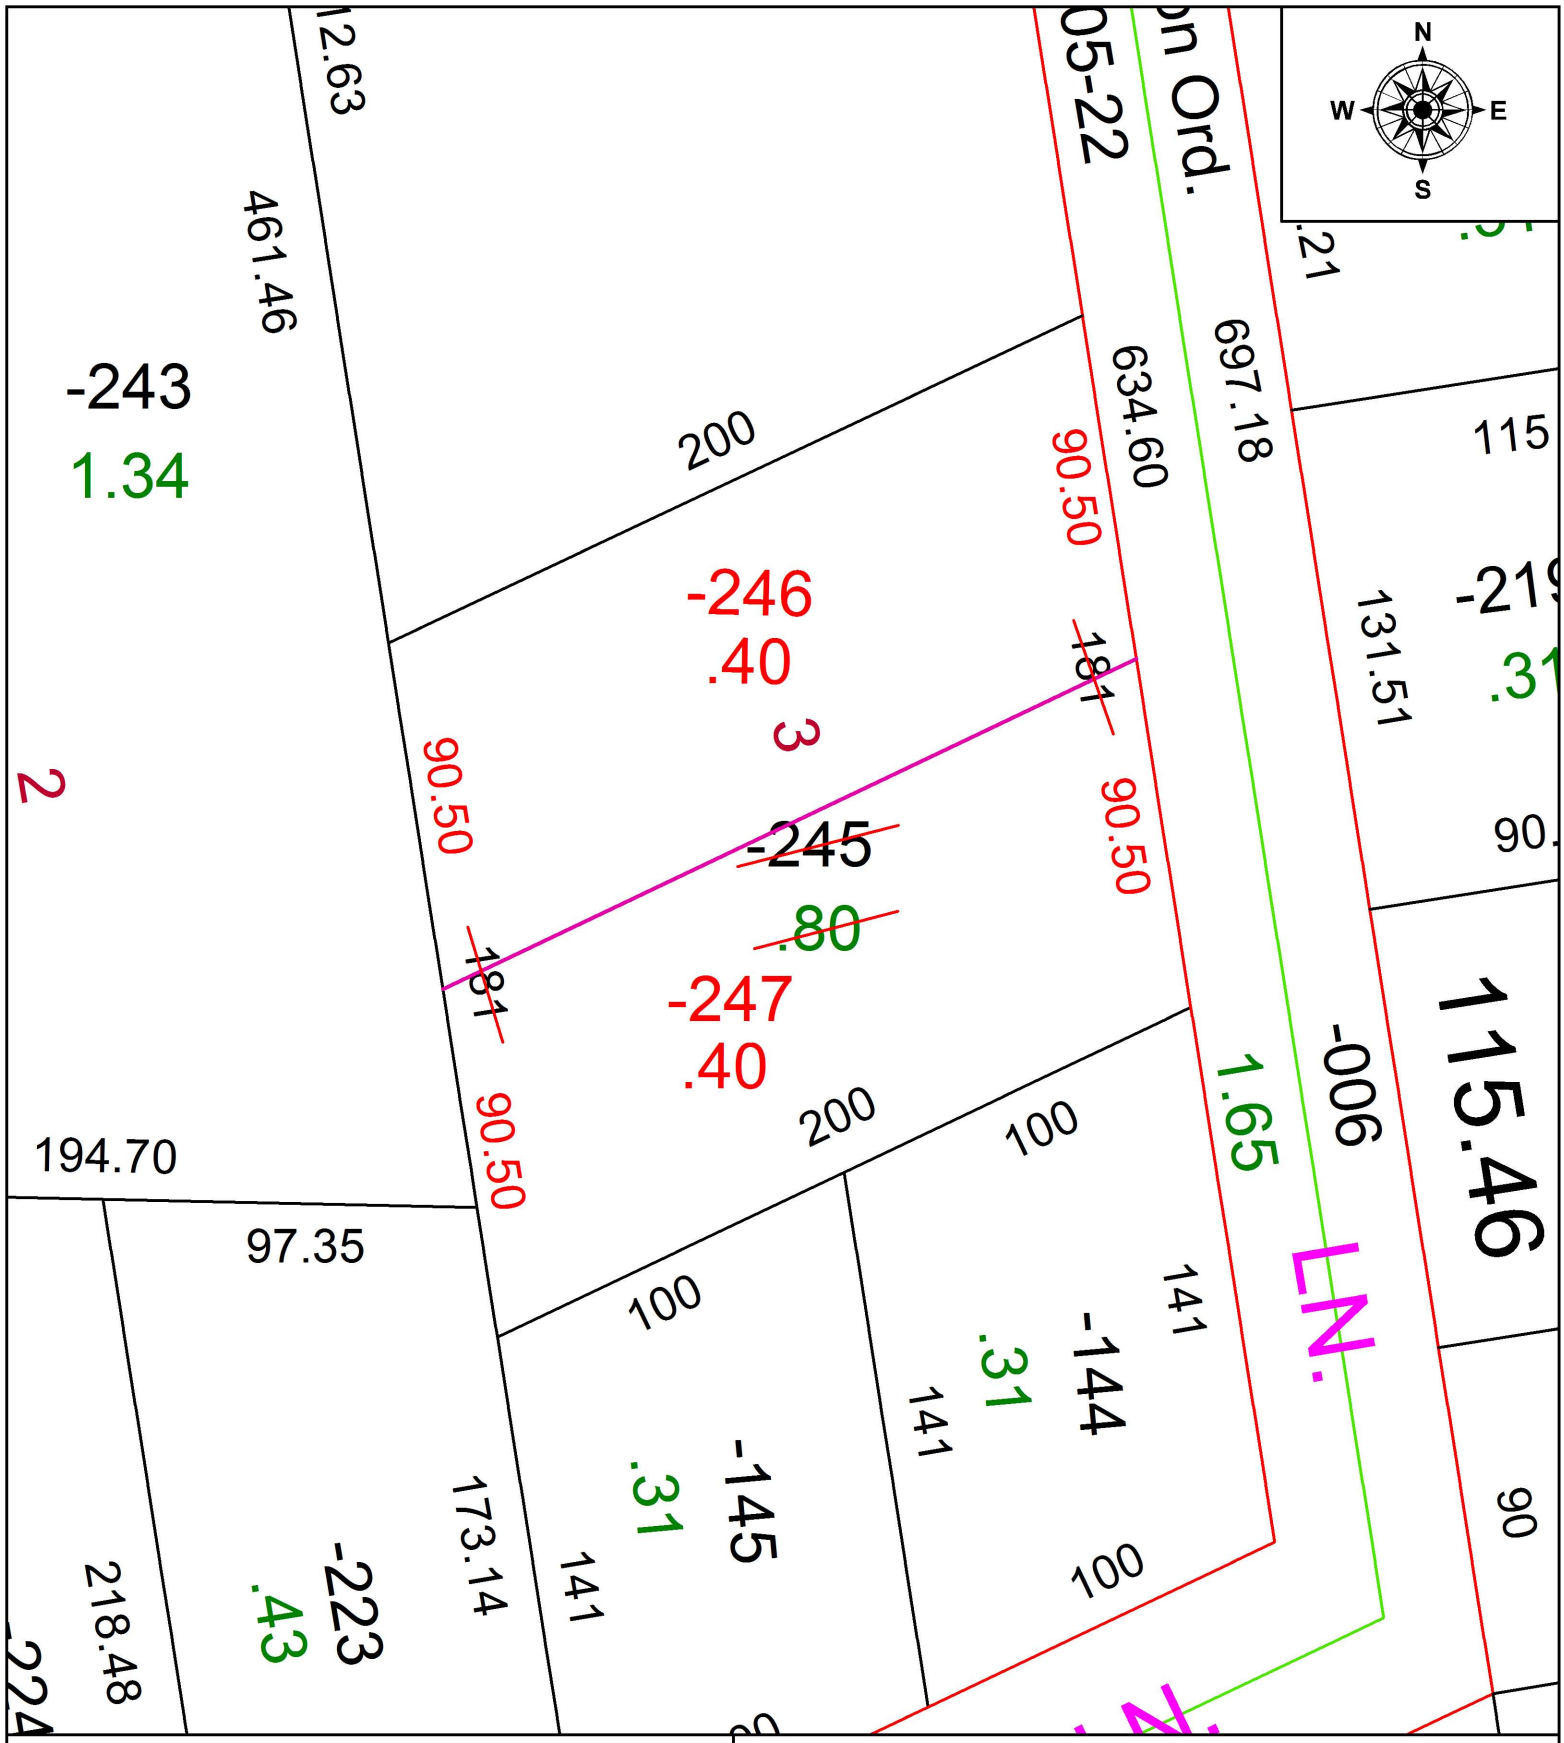

SPLITS/DEEDS PROCESSED
LORAIN COUNTY TAX MAP DEPARTMENT
226 MIDDLE AVE. ELYRIA, OH

SURVEYED BY: TIMOTHY D. HOZALSKI
CLOSURE: 1: 2,147,483,648
MAP PAGE(S): 5-00-006
APPOVED BY: RRM **DATE:** 8-19-16
SCALE: 1" = 50 **PRIOR INSTRUMENT:** 20160592554