PARENT PARCEL: 03-00-112-103-010
CHILD PARCEL: 03-00-111-103-012, 03-00-112-103-015
STARTING POINT: SOUTHWEST CORNER OF SUBLOT 23

16-03559-U

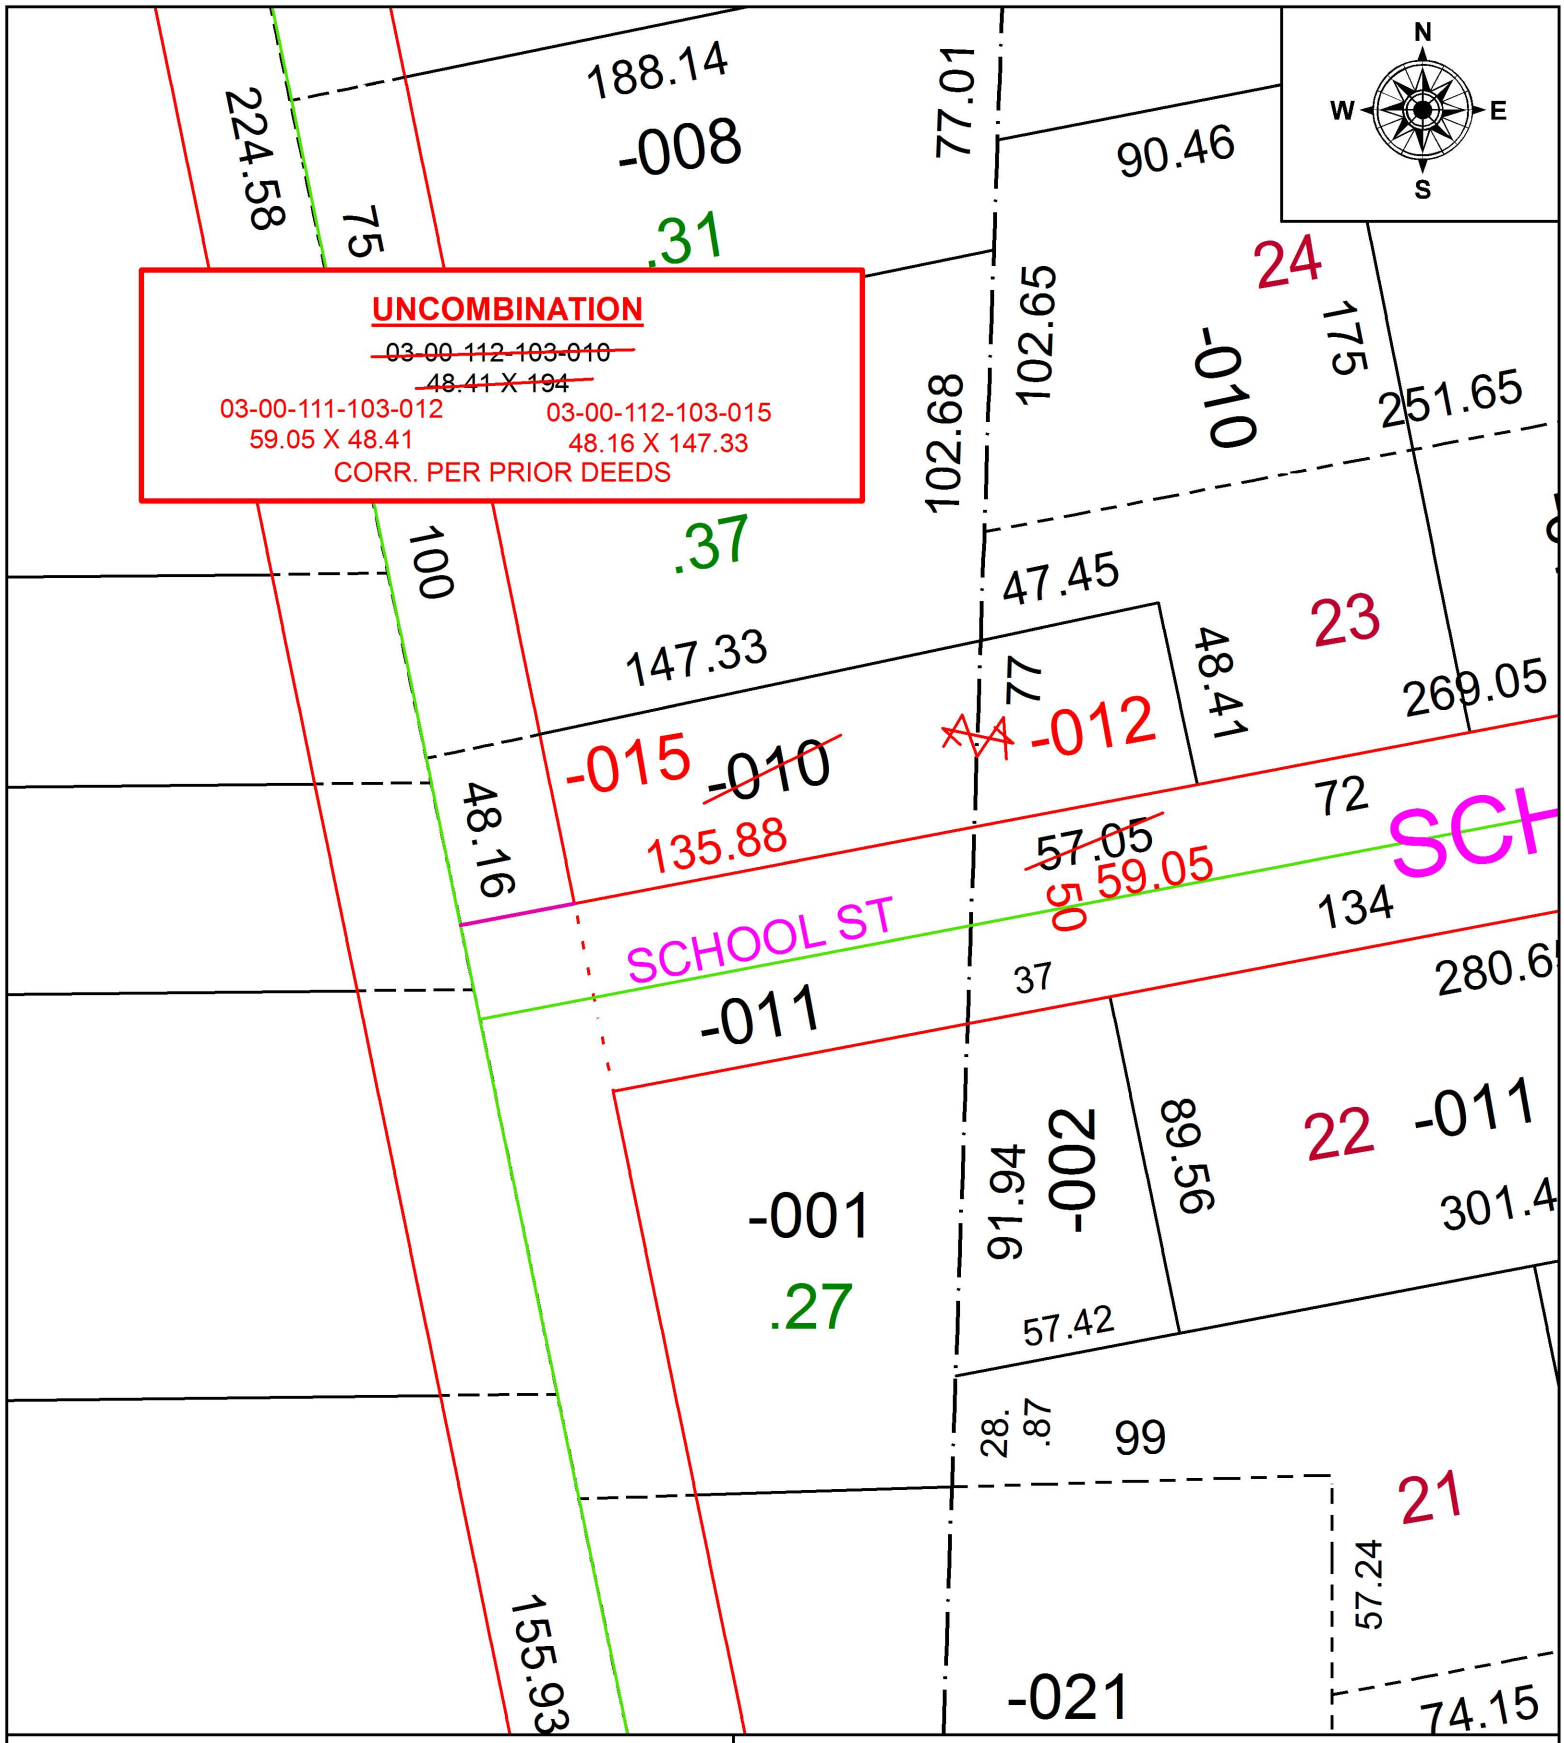

SPLITS/DEEDS PROCESSED
LORAIN COUNTY TAX MAP DEPARTMENT
226 MIDDLE AVE. ELYRIA, OH

SURVEYED BY: N/A
CLOSURE: N/A
MAP PAGE(S): 3-00-112
APPOVED BY: RRM **DATE:** 11-22-16
SCALE: 1" = 50 **PRIOR INSTRUMENT:** 20160581790