PARENT PARCEL: 04-00-003-101-509
CHILD PARCEL: 04-00-003-101-577 THRU -582
STARTING POINT: CENTERLINE OF MURIWOOD RD & SHEFFIELD-FRENCH CREEK RD

16-03560

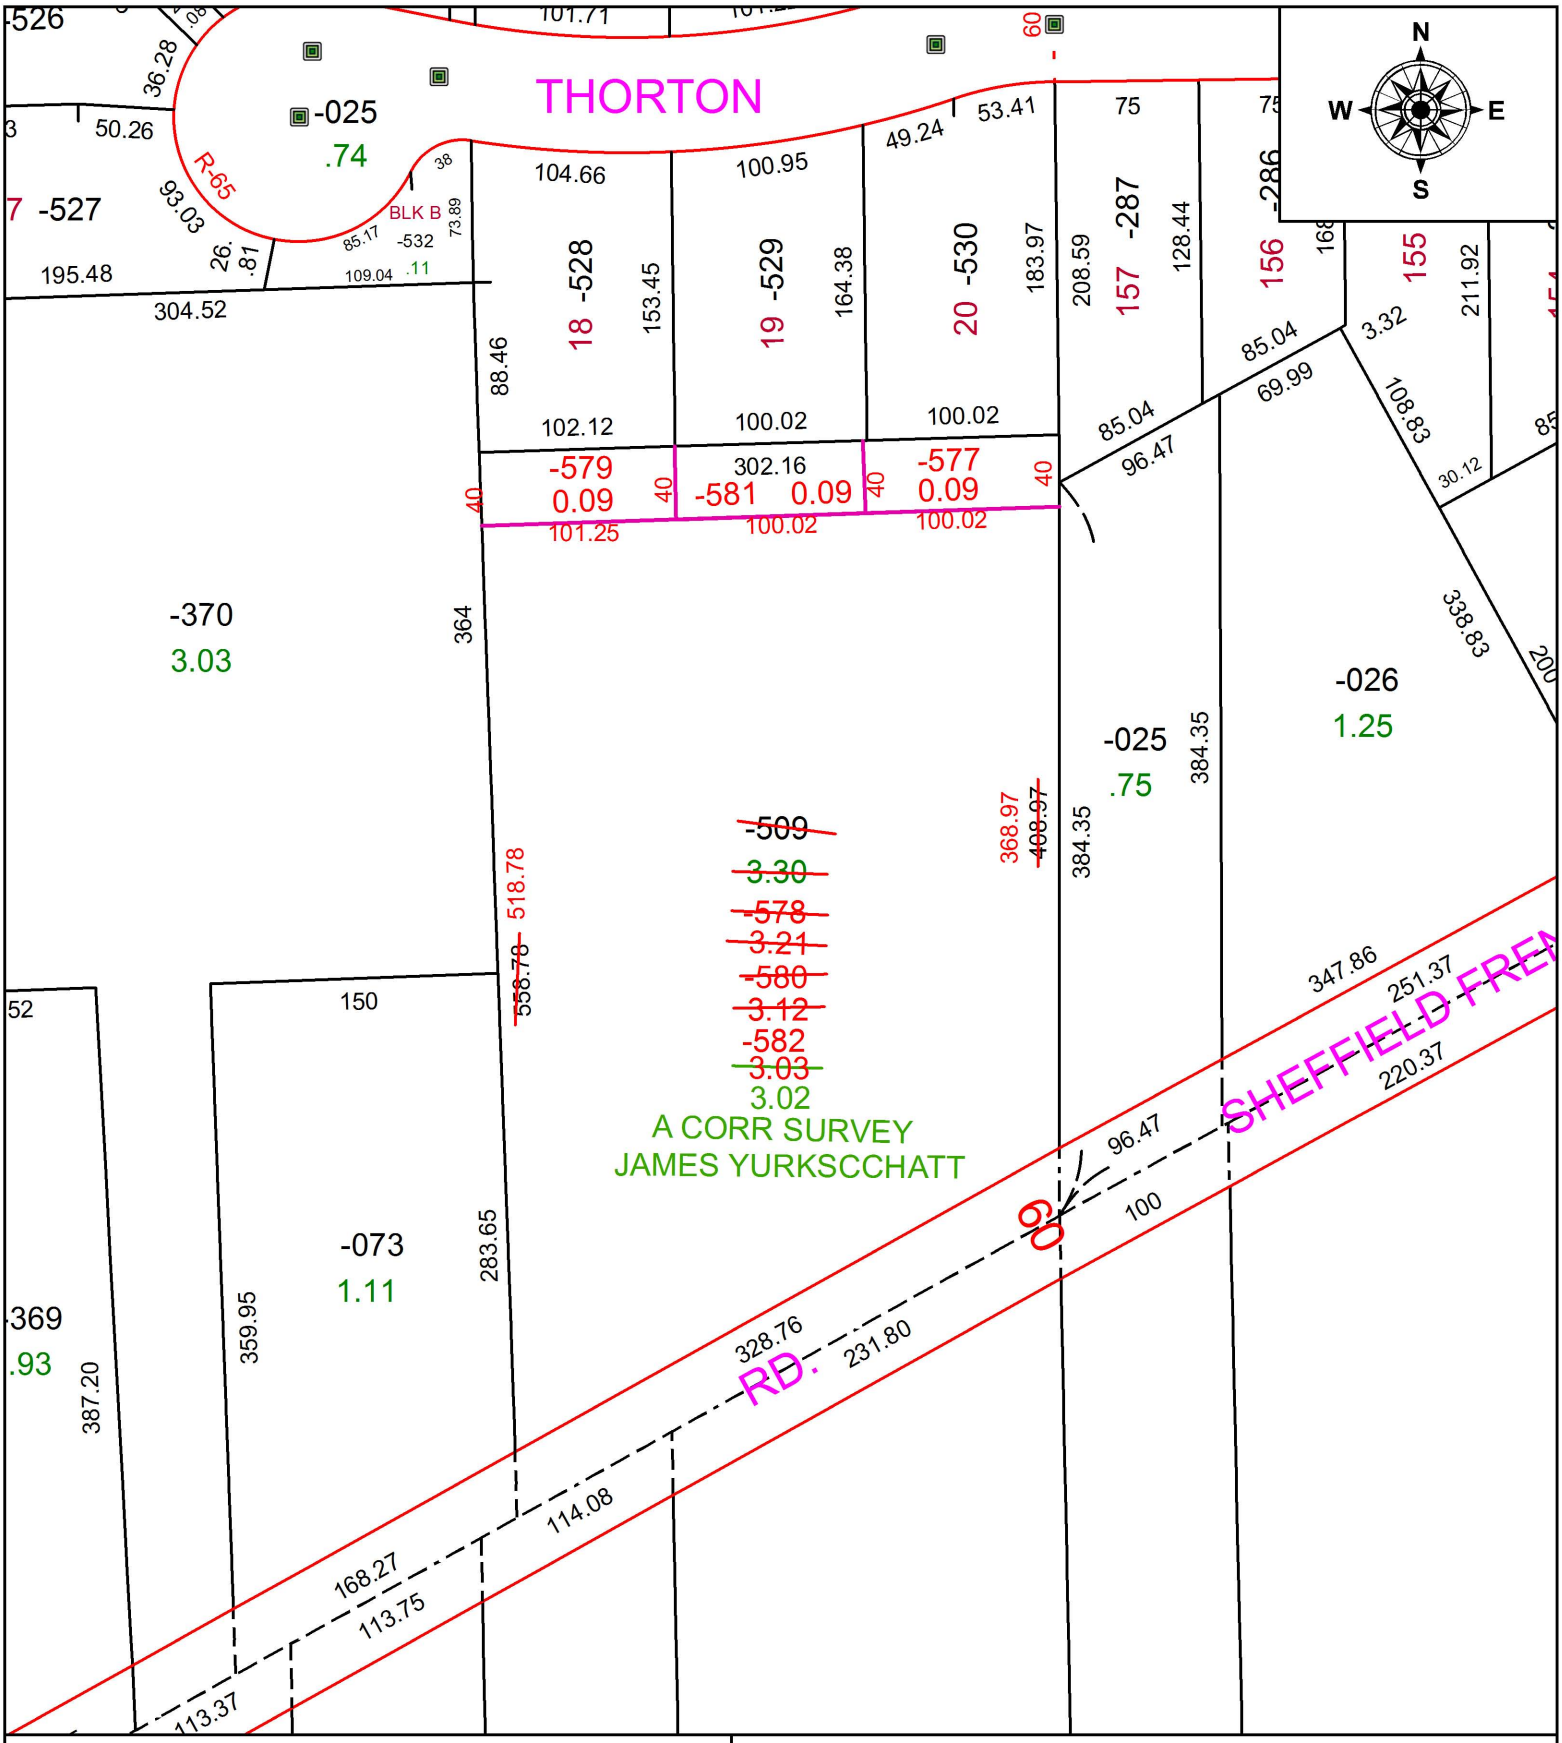

SPLITS/DEEDS PROCESSED
LORAIN COUNTY TAX MAP DEPARTMENT
226 MIDDLE AVE. ELYRIA, OH

SURVEYED BY: JAMES YURKSCHATT
CLOSURE: 1:177575
MAP PAGE(S): 04-00-003
APPOVED BY: JAH **DATE:** 8/24/2016
SCALE: 1 in = 100 ft **PRIOR INSTRUMENT:** 20120423990