PARENT PARCEL: 03-00-049-101-027
CHILD PARCEL: XX-XX-XXX-XXX-XXX
STARTING POINT: INTERSECTION OF C/L OF E.ERIE AVE AND C/L OF MONTANA AVE.

16-03562-A

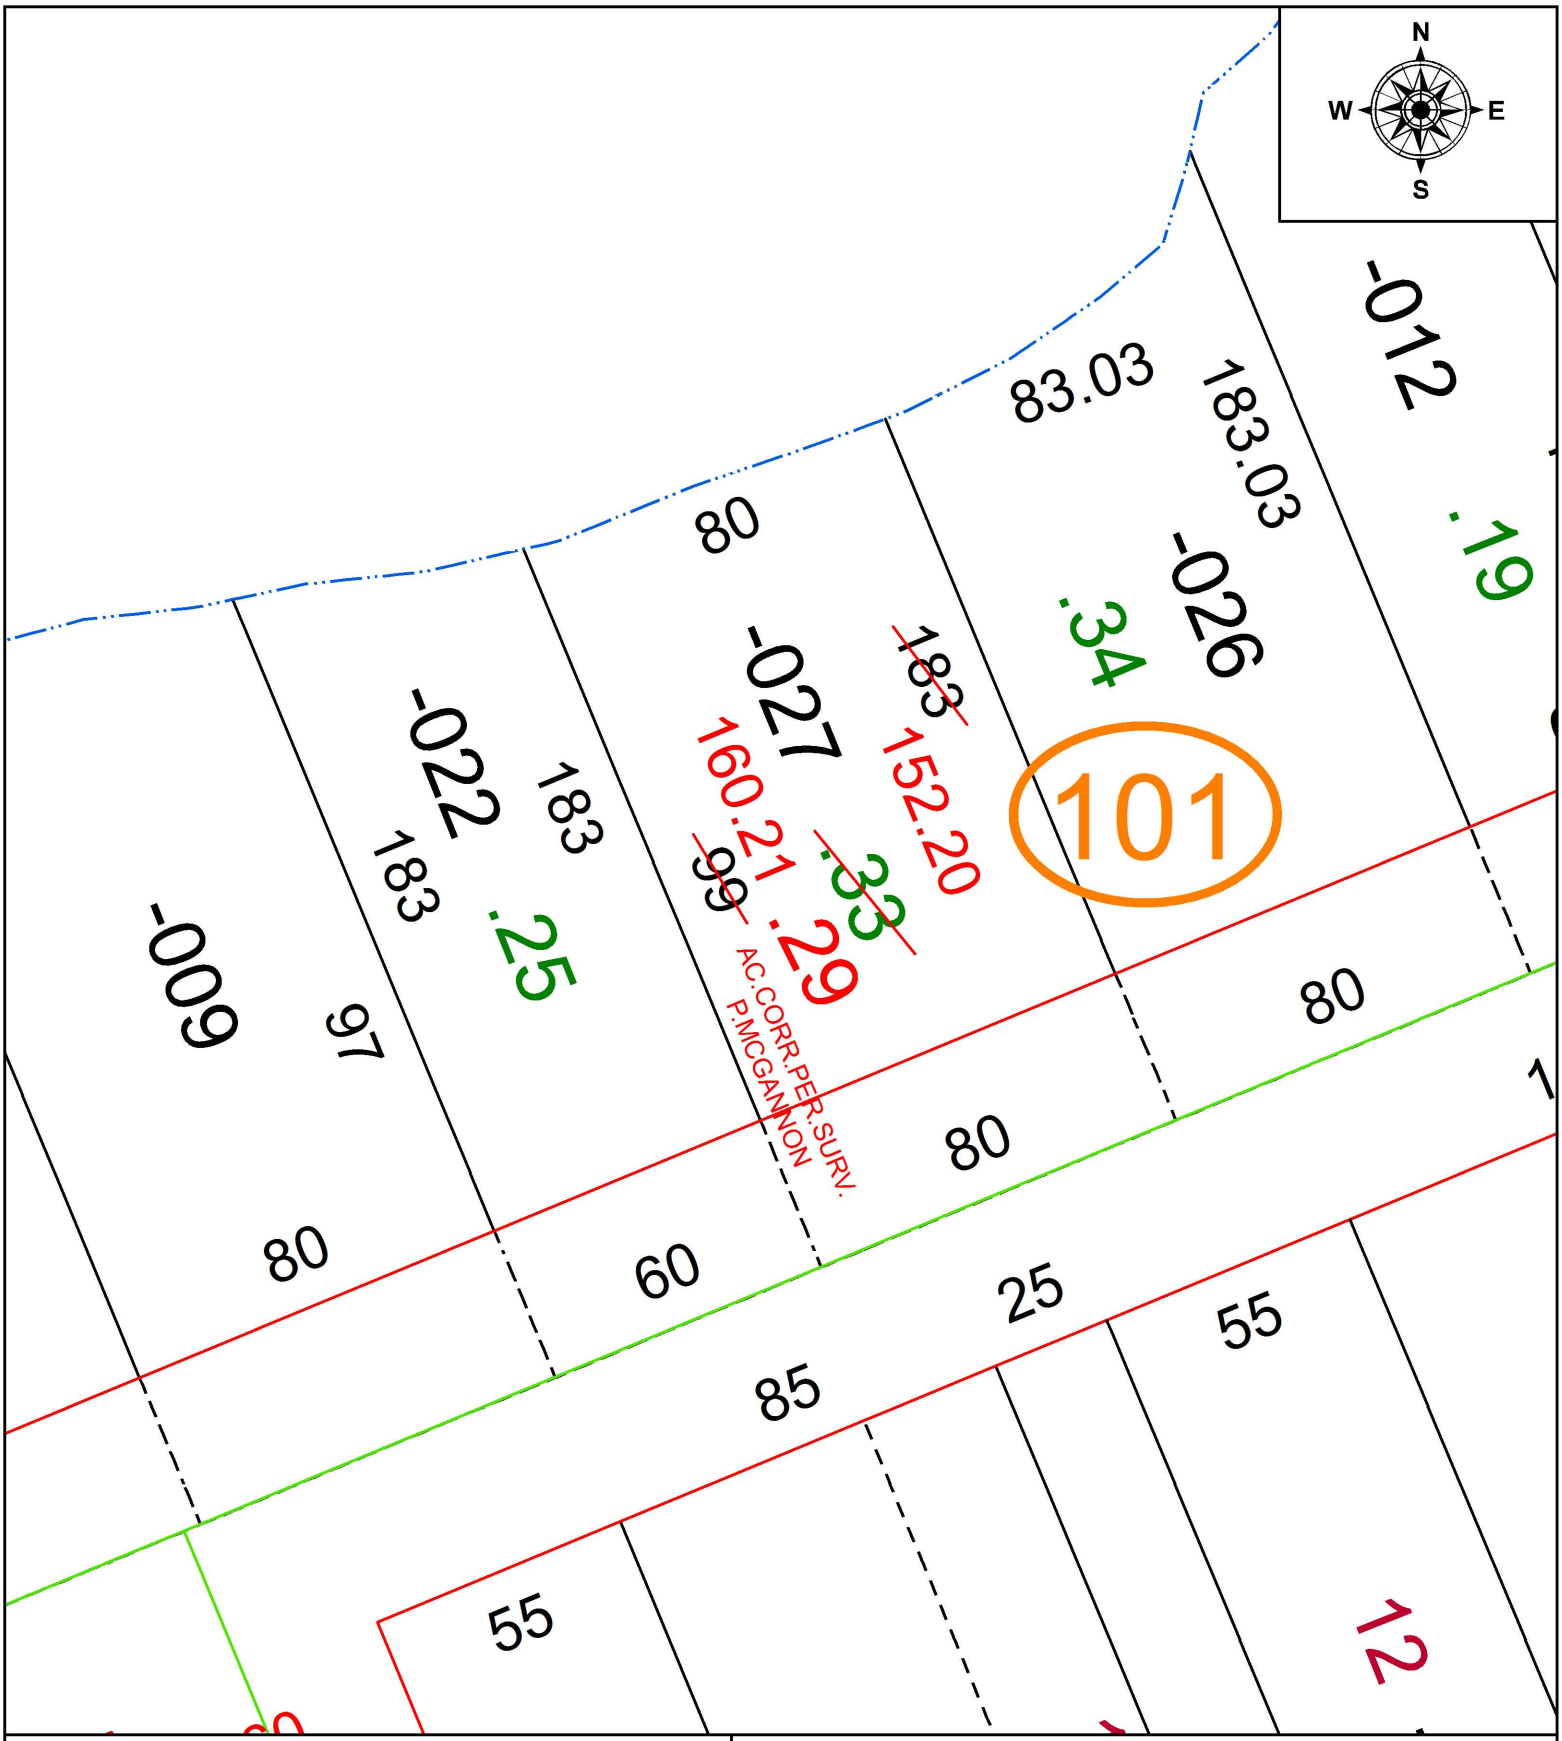

SPLITS/DEEDS PROCESSED
LORAIN COUNTY TAX MAP DEPARTMENT
226 MIDDLE AVE. ELYRIA, OH

SURVEYED BY: PATRICK A. MCGANNON
CLOSURE: N/A
MAP PAGE(S): 3-00-049
APPOVED BY: RRM **DATE:** 12-5-16
SCALE: 1" = 40 **PRIOR INSTRUMENT:** 20110384672