PARENT PARCEL: 03-00-107-104-037, -038

CHILD PARCEL: 03-00-107-104-046 thru -048

STARTING POINT: INTERSECTION OF C/L OF DUNTON RD. AND C/L OF ELYRIA AVE.

16-03562

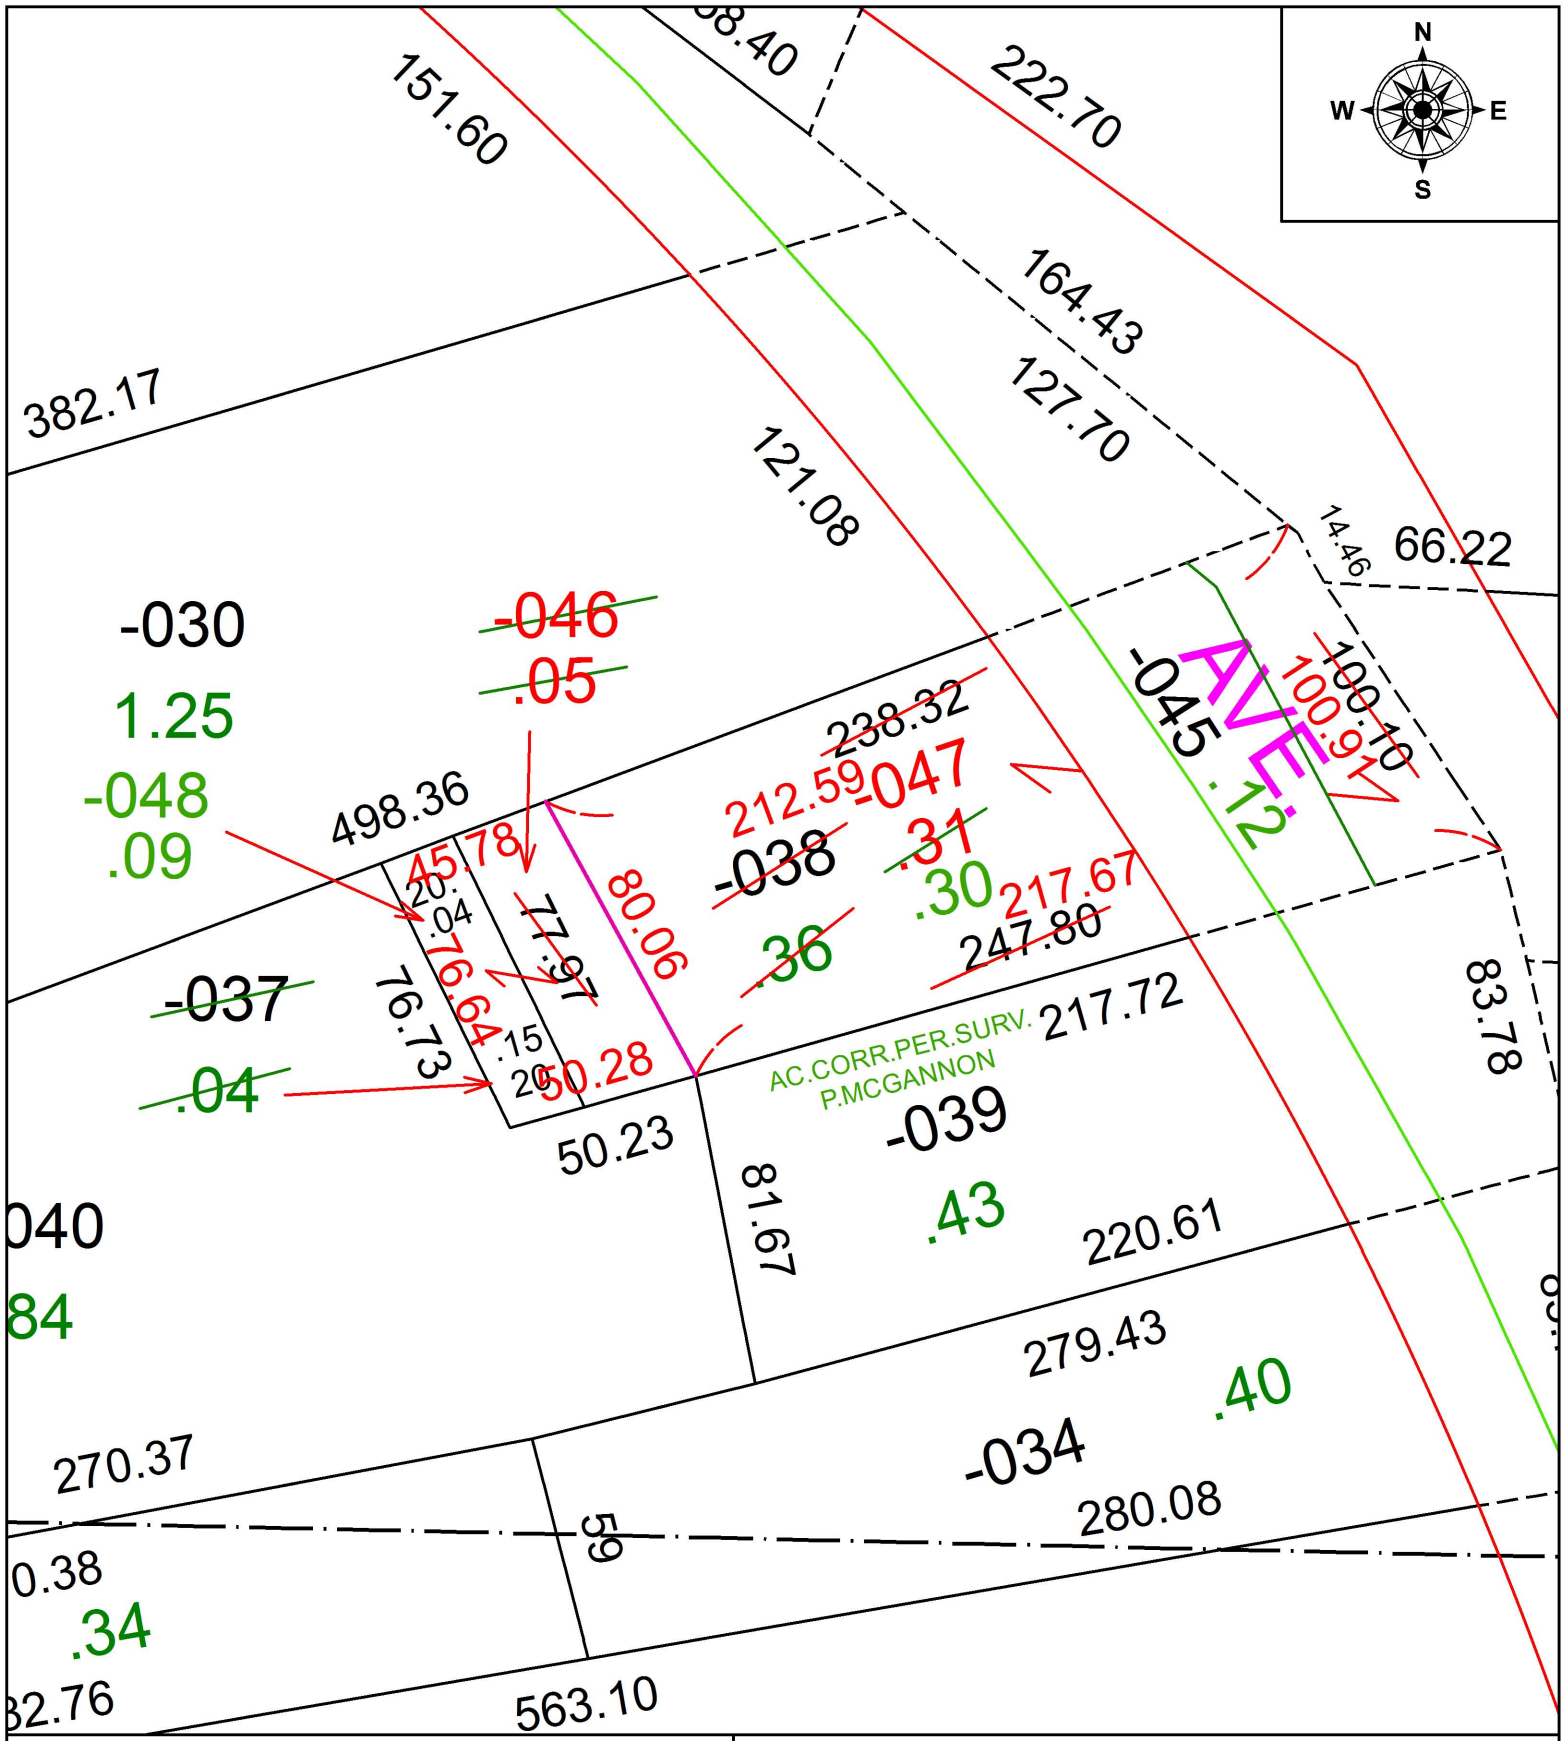

SPLITS/DEEDS PROCESSED

LORAIN COUNTY TAX MAP DEPARTMENT
226 MIDDLE AVE. ELYRIA, OH

SURVEYED BY: PATRICK A. MCGANNON
CLOSURE: 1: 90,398
MAP PAGE(S): 3-00-107
APPOVED BY: RRM **DATE:** 8-30-16
SCALE: 1" = 50 **PRIOR INSTRUMENT:** 20060150748