**PARENT PARCEL:** 14-00-087-000-004, -008
**CHILD PARCEL:** 14-00-087-000-029
**STARTING POINT:** INTERSECTION OF C/L OF S.R.303 AND C/L OF PITTS RD.

16-03566

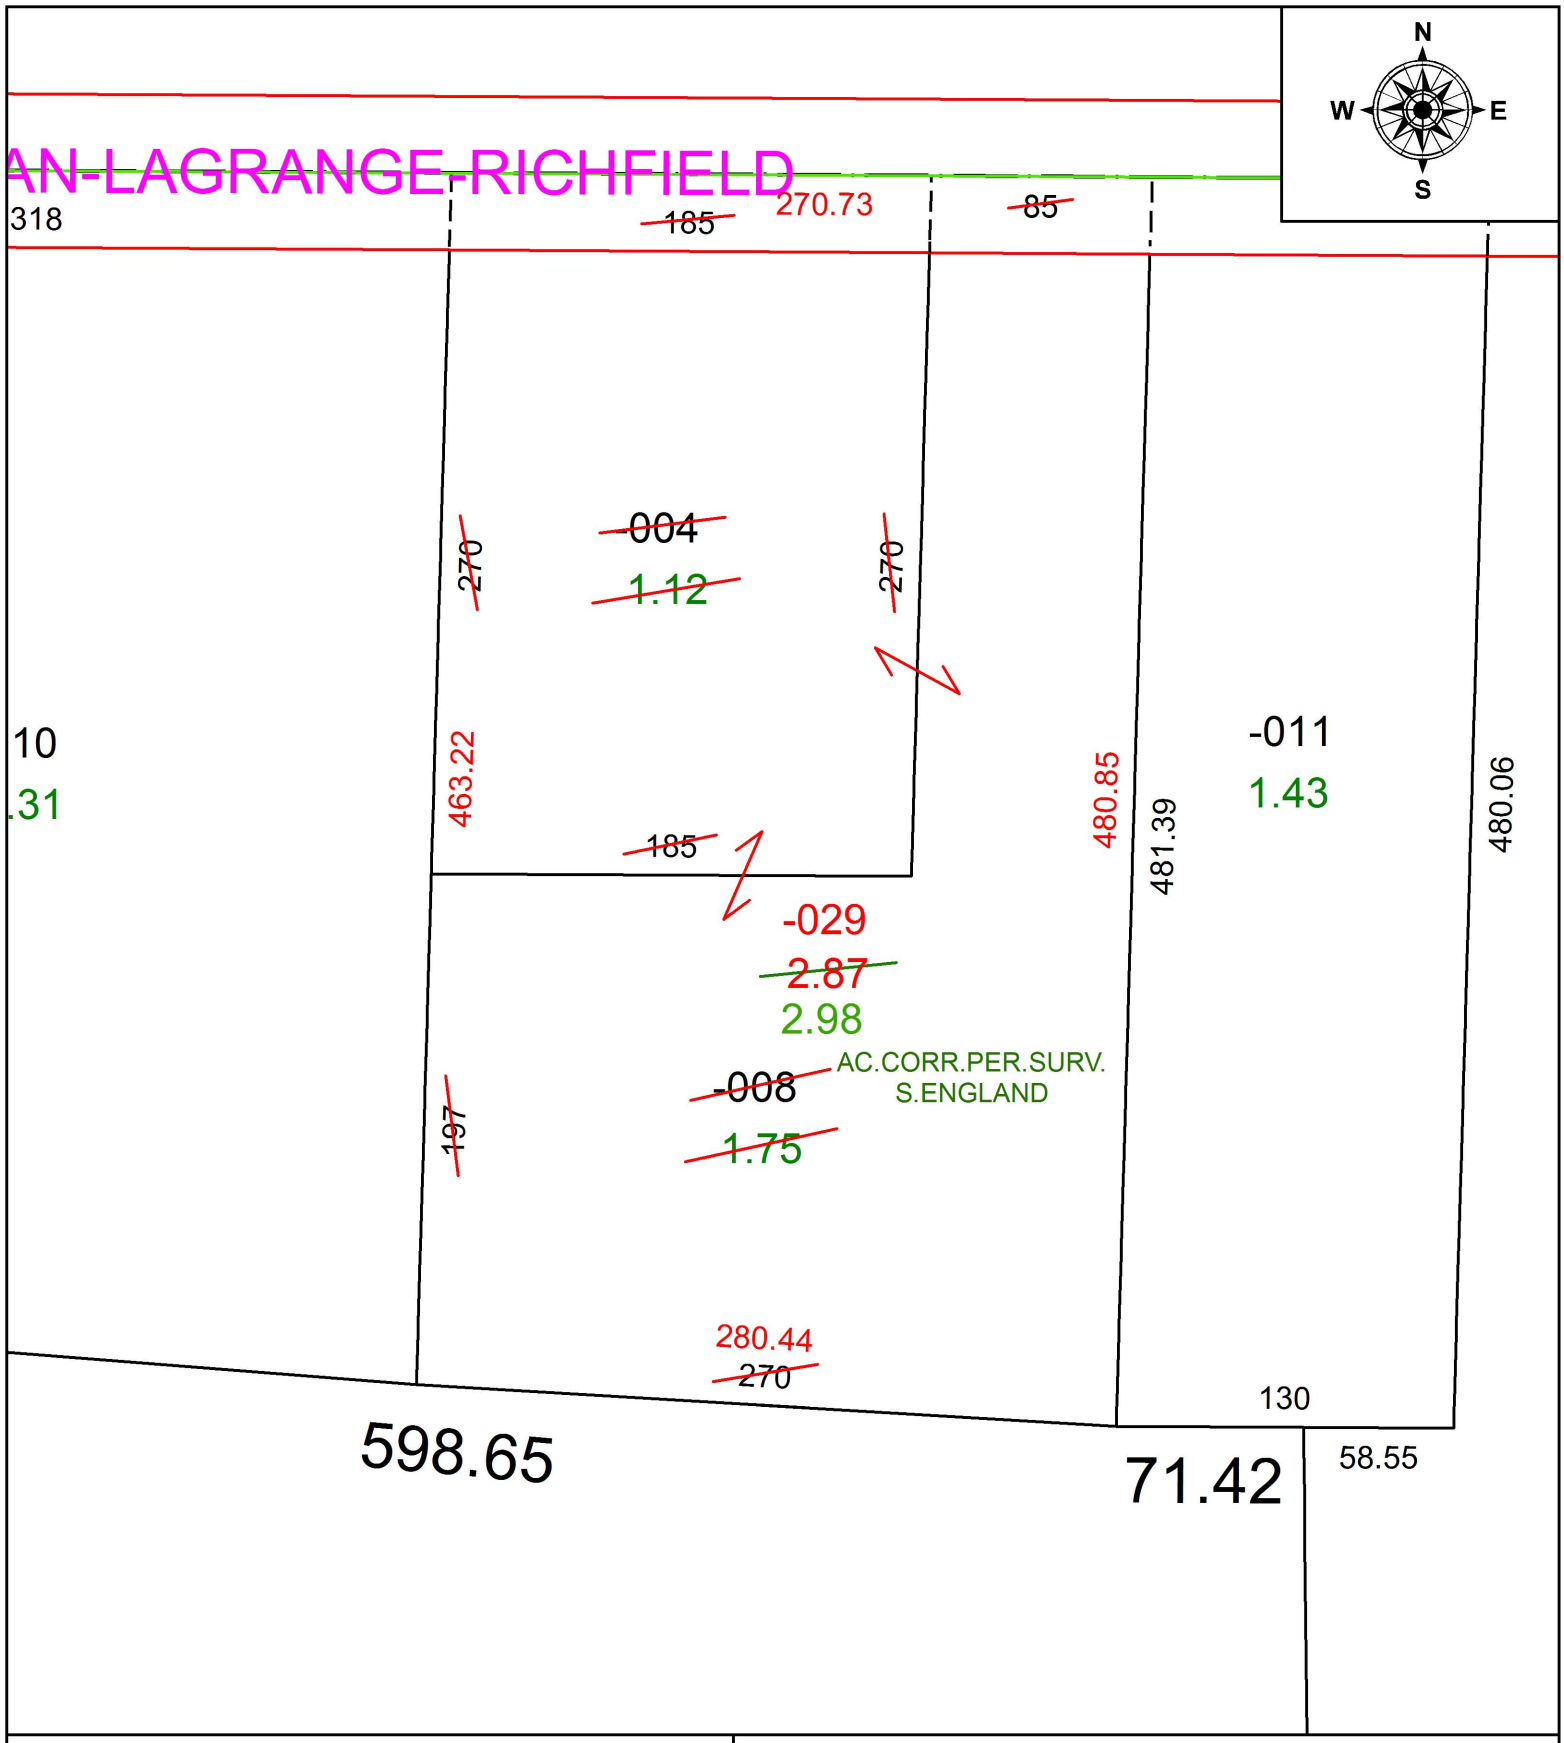


**SPLITS/DEEDS PROCESSED**
LORAIN COUNTY TAX MAP DEPARTMENT
226 MIDDLE AVE. ELYRIA, OH

**SURVEYED BY:** SCOTT A. ENGLAND
**CLOSURE:** 1: 300,997
**MAP PAGE(S):** 14-F
**APPOVED BY:** RRM **DATE:** 9-12-16
**SCALE:** 1" = 75 **PRIOR INSTRUMENT:** 20160576955