PARENT PARCEL: 07-00-006-102-159, -197, -199

CHILD PARCEL: 07-00-006-102-197, -201, -202, -203

STARTING POINT: NORTHWEST CORNER OF BLOCK C IN WOODS OF STRADFORD

16-03567

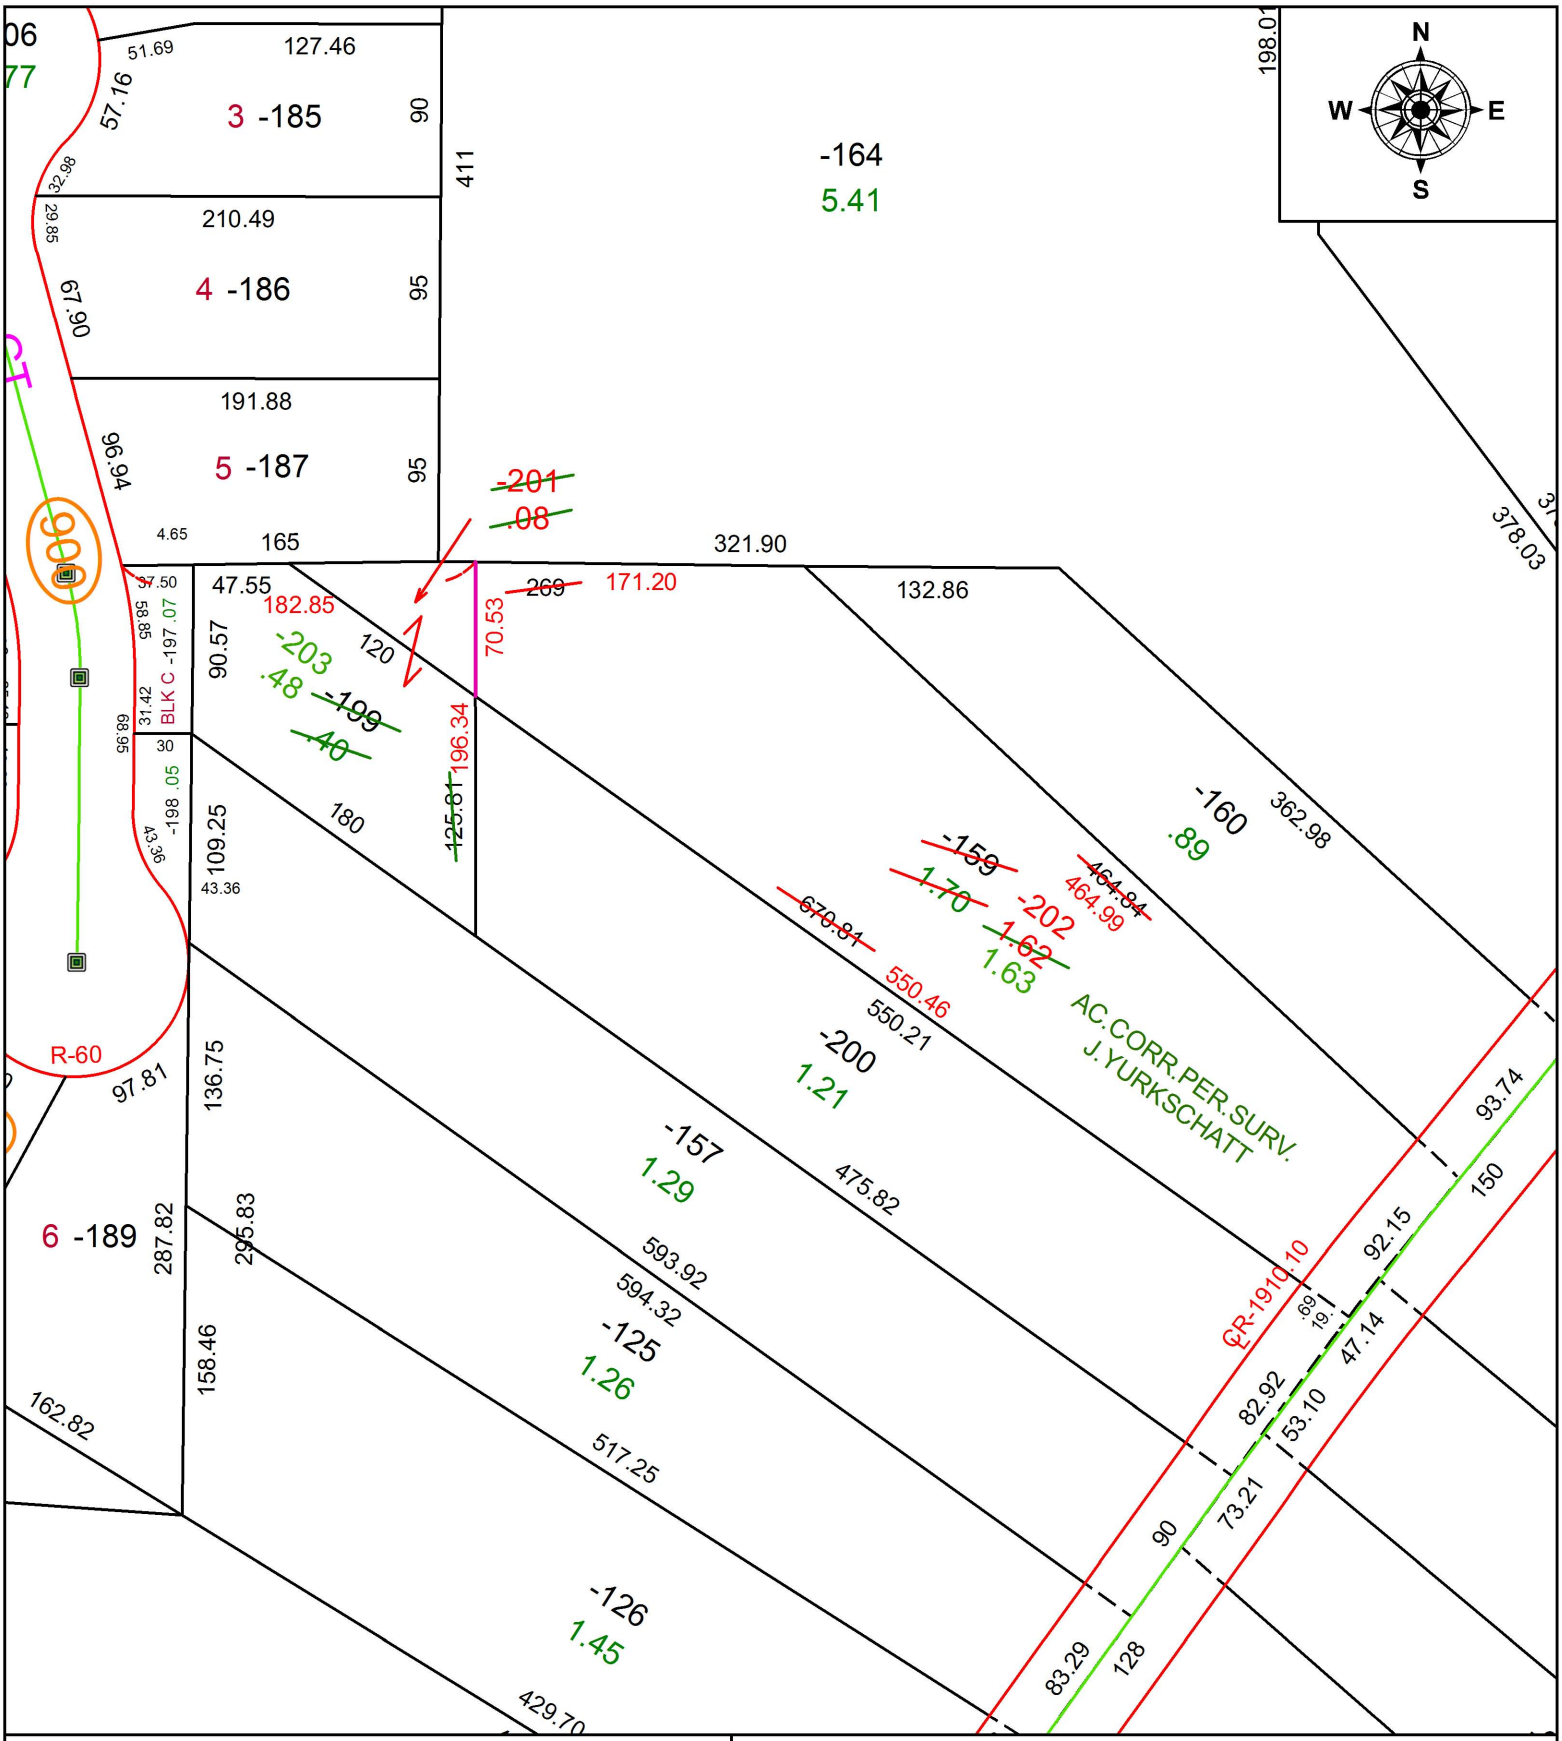

SPLITS/DEEDS PROCESSED

LORAIN COUNTY TAX MAP DEPARTMENT
226 MIDDLE AVE. ELYRIA, OH

SURVEYED BY: JAMES P. YURKSCHATT
CLOSURE: 1: 69,989
MAP PAGE(S): 7-00-006
APPOVED BY: RRM **DATE:** 9-14-16
SCALE: 1" = 100 **PRIOR INSTRUMENT:** OR 56/834