PARENT PARCEL: 10-00-015-114-016, -035

CHILD PARCEL: 10-00-015-114-048

STARTING POINT: INTERSECTION OF C/L OF ESTHER DR. AND C/L OF ROBSON RD.

16-03570

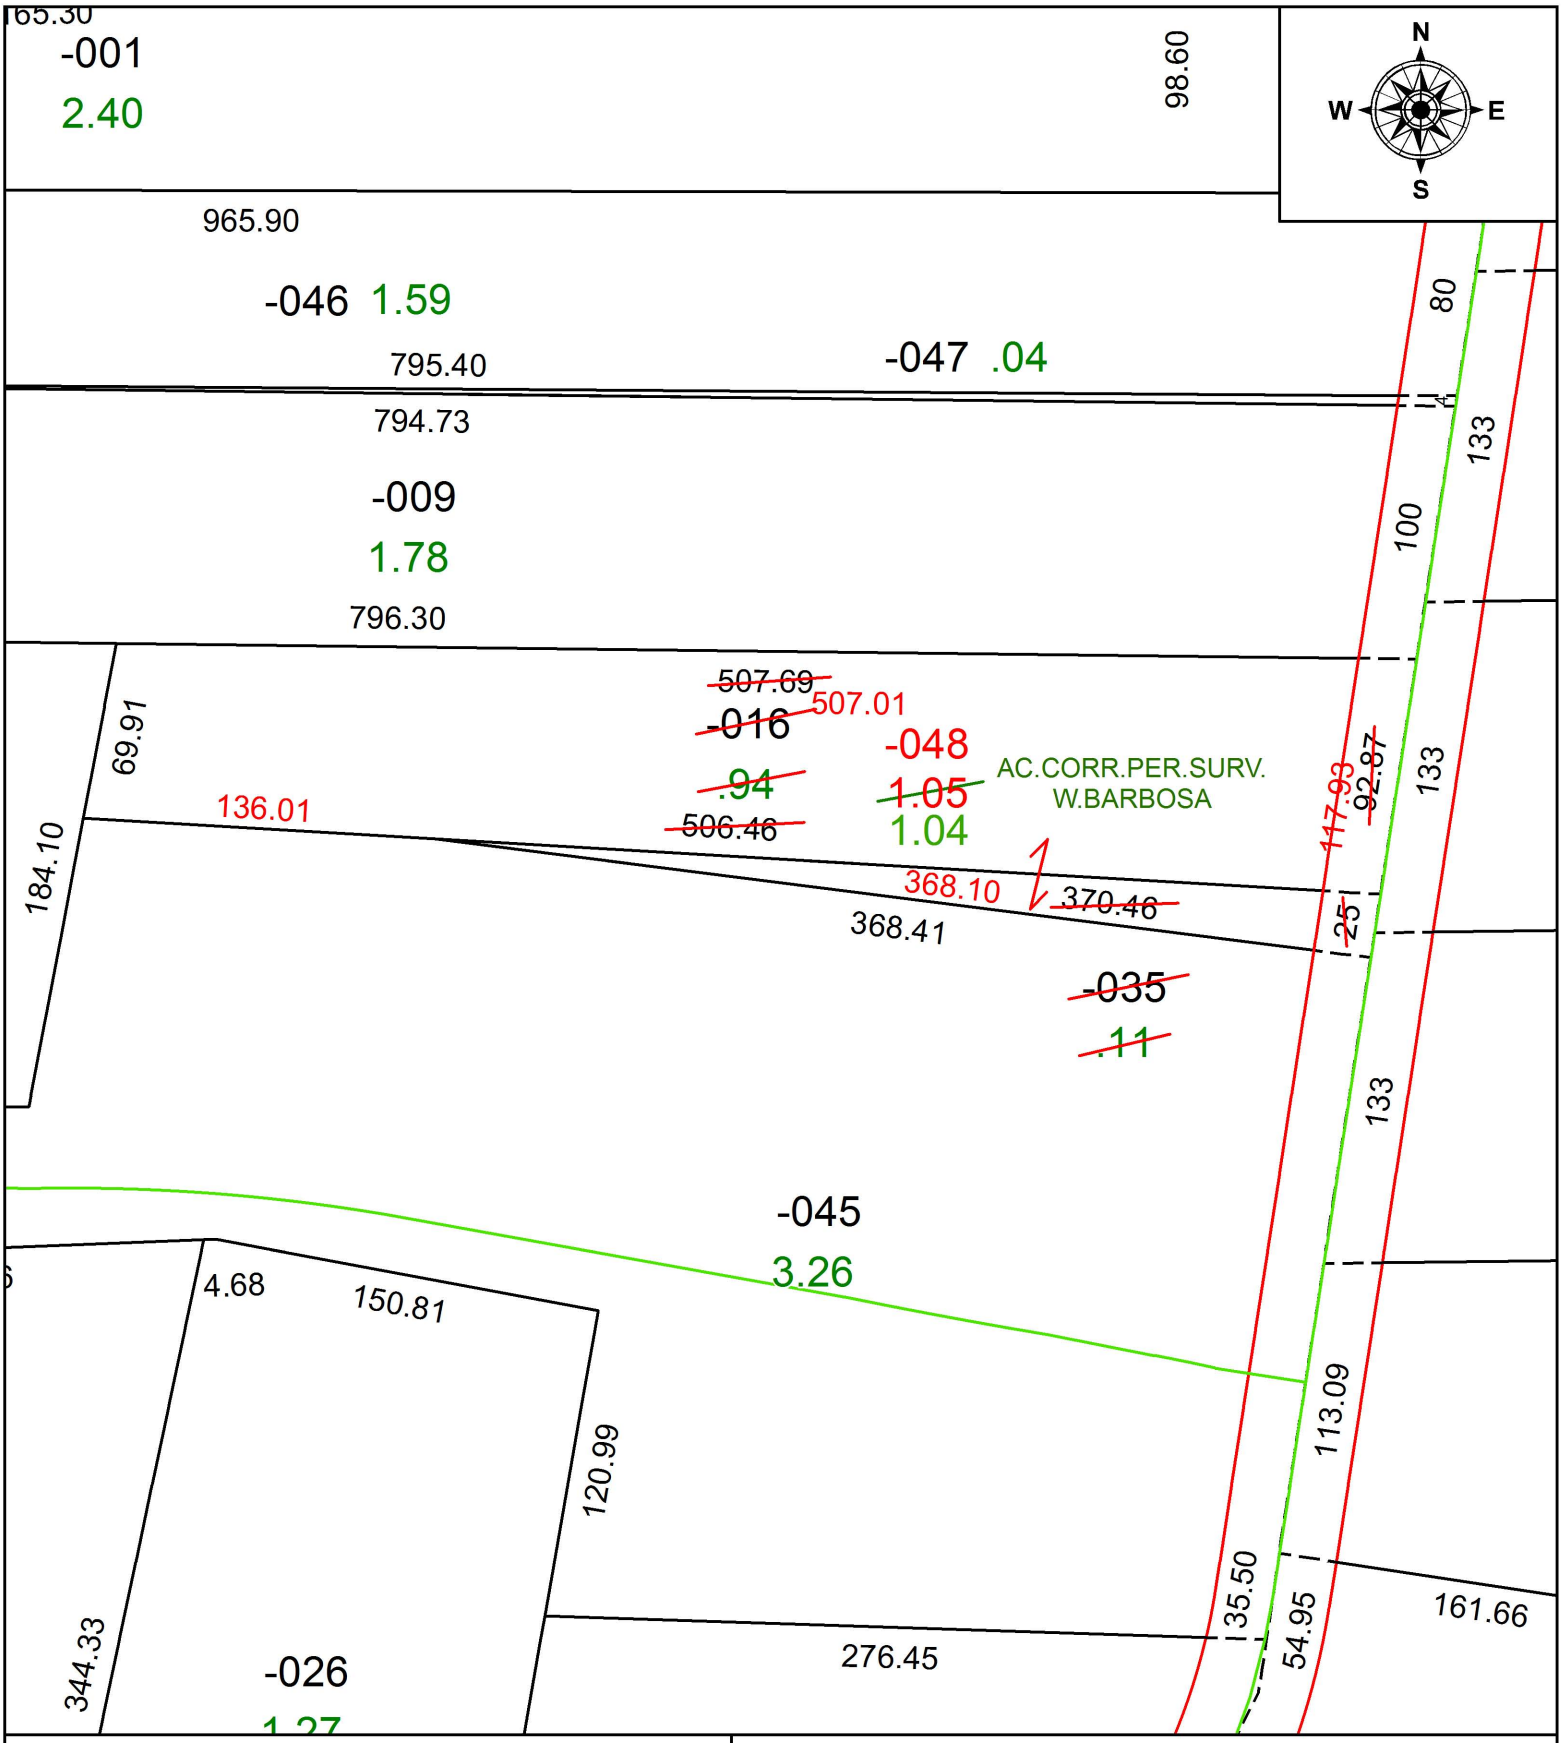

SPLITS/DEEDS PROCESSED

LORAIN COUNTY TAX MAP DEPARTMENT
226 MIDDLE AVE. ELYRIA, OH

SURVEYED BY: WILFREDO BARBOSA
CLOSURE: 1: 166,444
MAP PAGE(S): 10-00-015
APPOVED BY: RRM **DATE:** 9-23-16
SCALE: 1" = 75 **PRIOR INSTRUMENT:** 20150570910