PARENT PARCEL: 02-02-005-108-028
CHILD PARCEL: XX-XX-XXX-XXX-XXX
STARTING POINT: INTERSECTION OF WEST LINE OF OBERLIN AVE AND C/L OF WESTWOOD DR.

16-03575-A

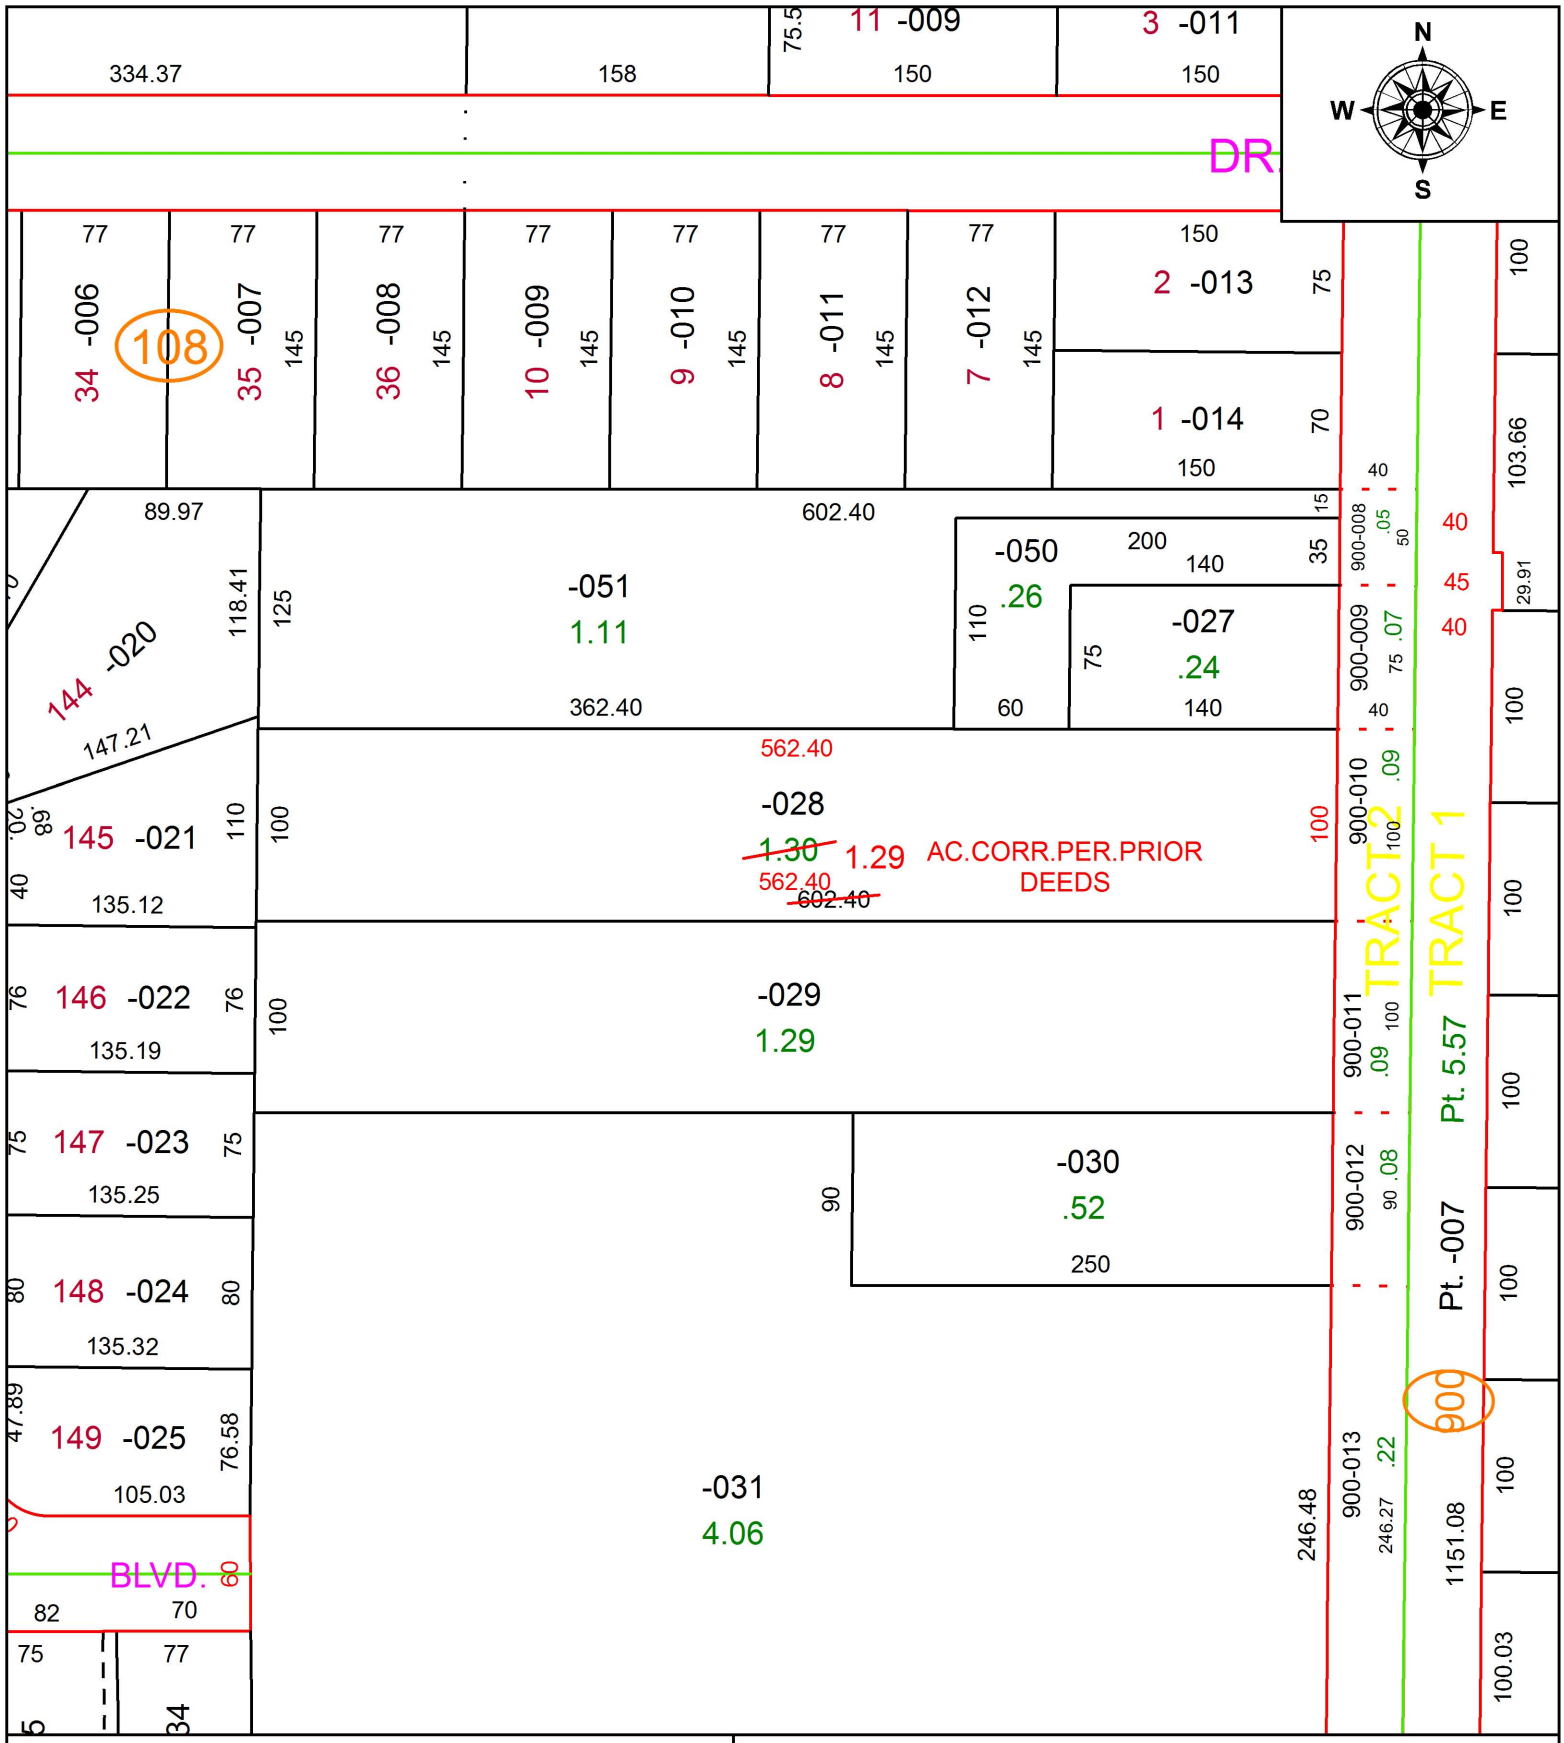

SPLITS/DEEDS PROCESSED
LORAIN COUNTY TAX MAP DEPARTMENT
226 MIDDLE AVE. ELYRIA, OH

SURVEYED BY: N/A
CLOSURE: 1: 2147483648
MAP PAGE(S): 2-02-005
APPOVED BY: RRM **DATE:** 4-18-17
SCALE: 1" = 100 **PRIOR INSTRUMENT:** 20040995446