PARENT PARCEL: 18-00-022-106-001

CHILD PARCEL: ACREAGE & MAP CORRECTION

STARTING POINT: 1" I.P. MON. BOX FD., CL OF SOUTH MAIN ST. (S.R. 58) & CL OF HERRICK AVE. (S.R. 18)

16-03581-D

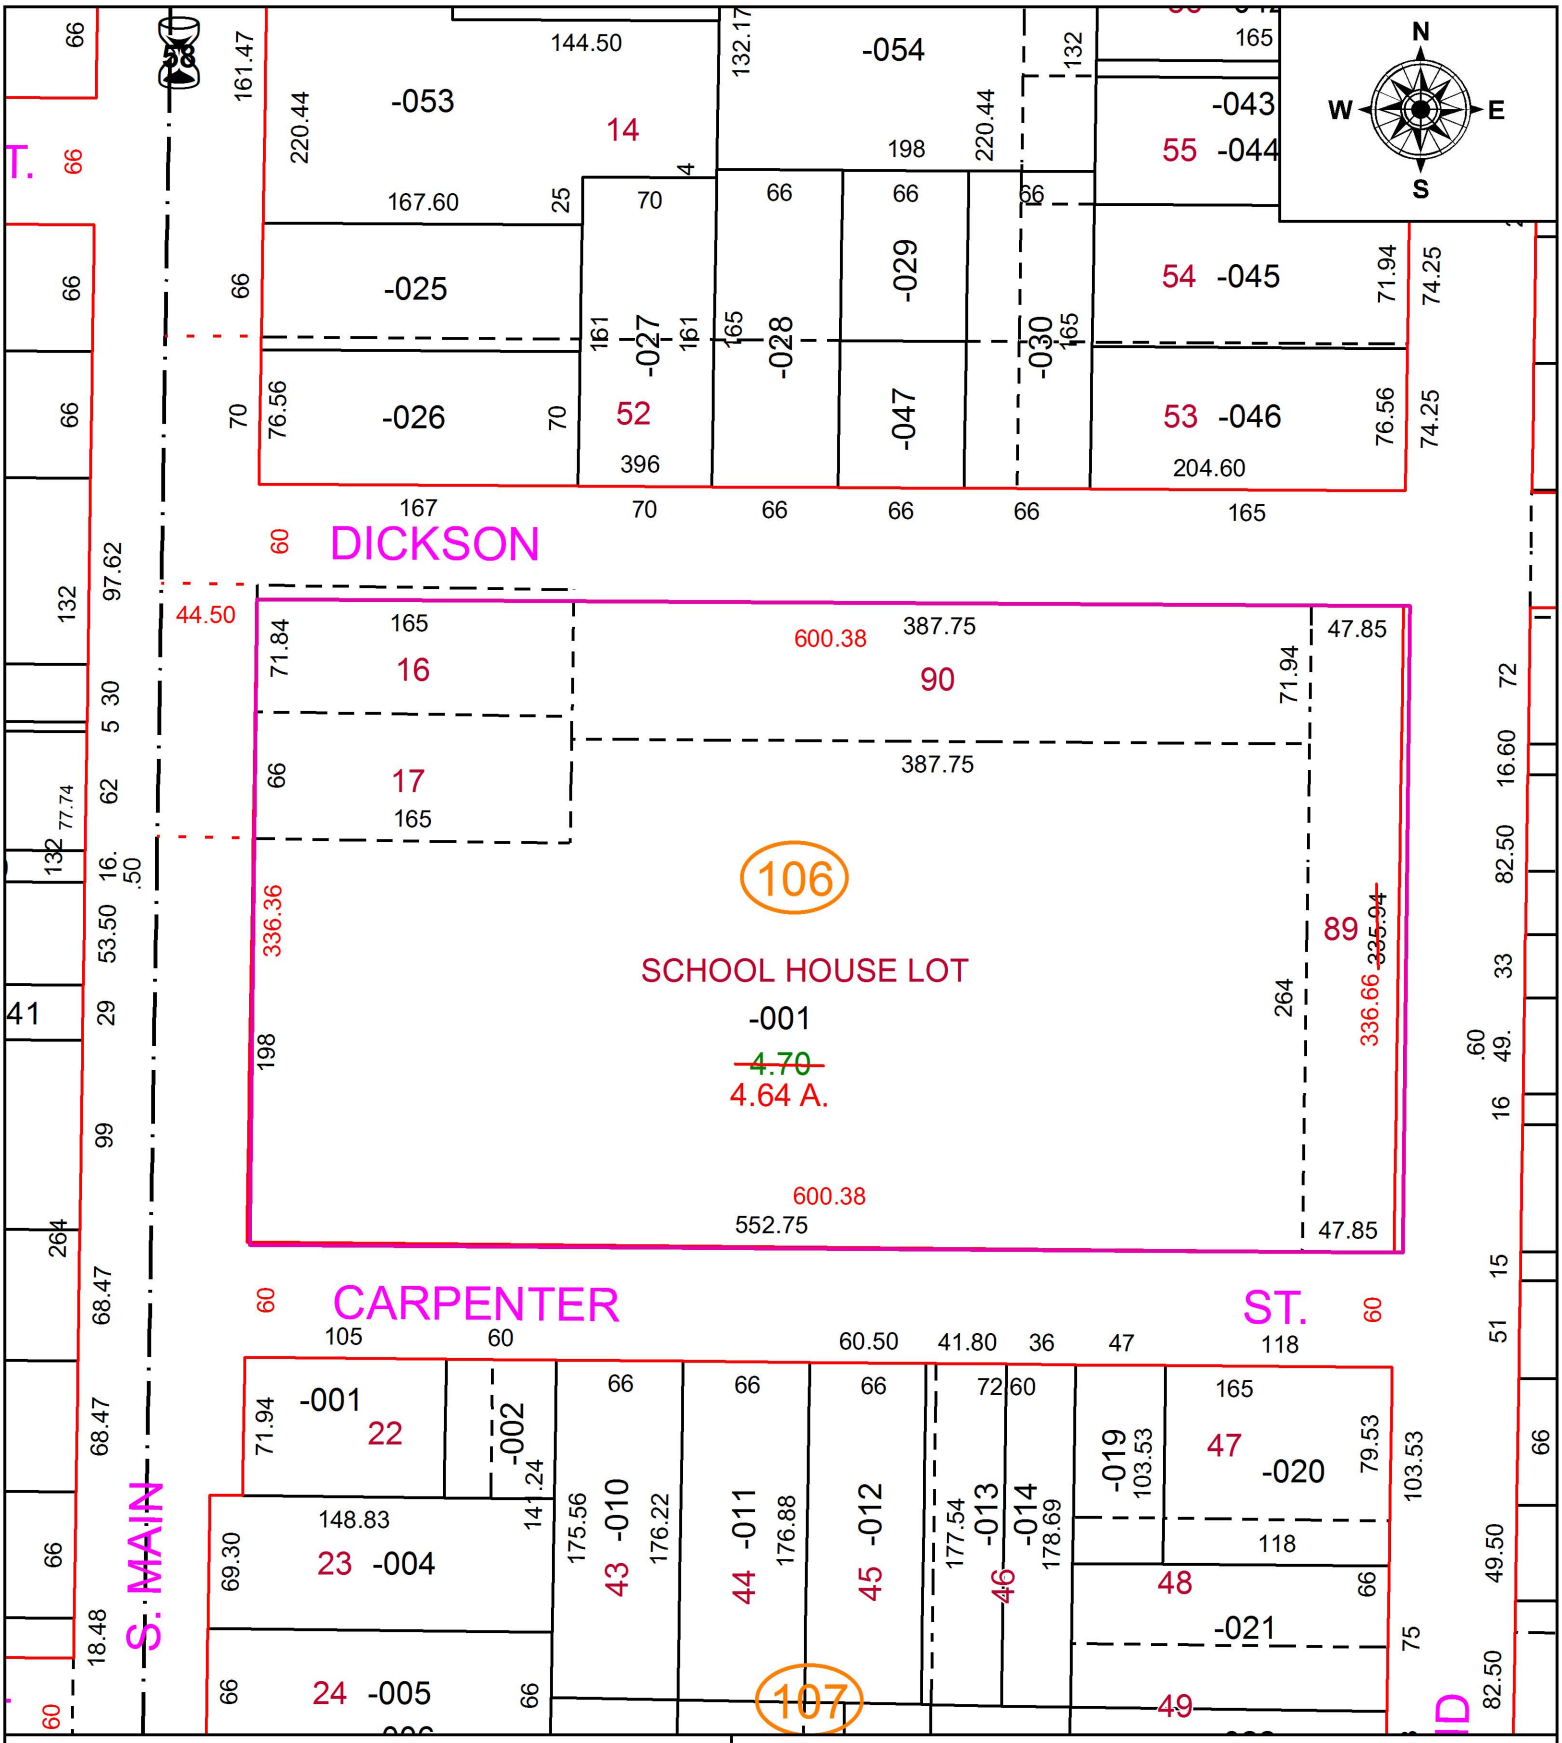

SPLITS/DEEDS PROCESSED

LORAIN COUNTY TAX MAP DEPARTMENT
226 MIDDLE AVE. ELYRIA, OH

SURVEYED BY: STEVEN D. CODER
CLOSURE: 1: 89,000
MAP PAGE(S): 18-00-022
APPOVED BY: TJS **DATE:** 1/23/17
SCALE: 1" = 100 **PRIOR INSTRUMENT:** DV 28/348