PARENT PARCEL: 05-00-021-102-018
CHILD PARCEL: MAP CORRECTION ONLY
STARTING POINT: S.E. CORNER OF BRECKENRIDGE SUBDIVISION PV. 24 PG. 99

17-03590-D

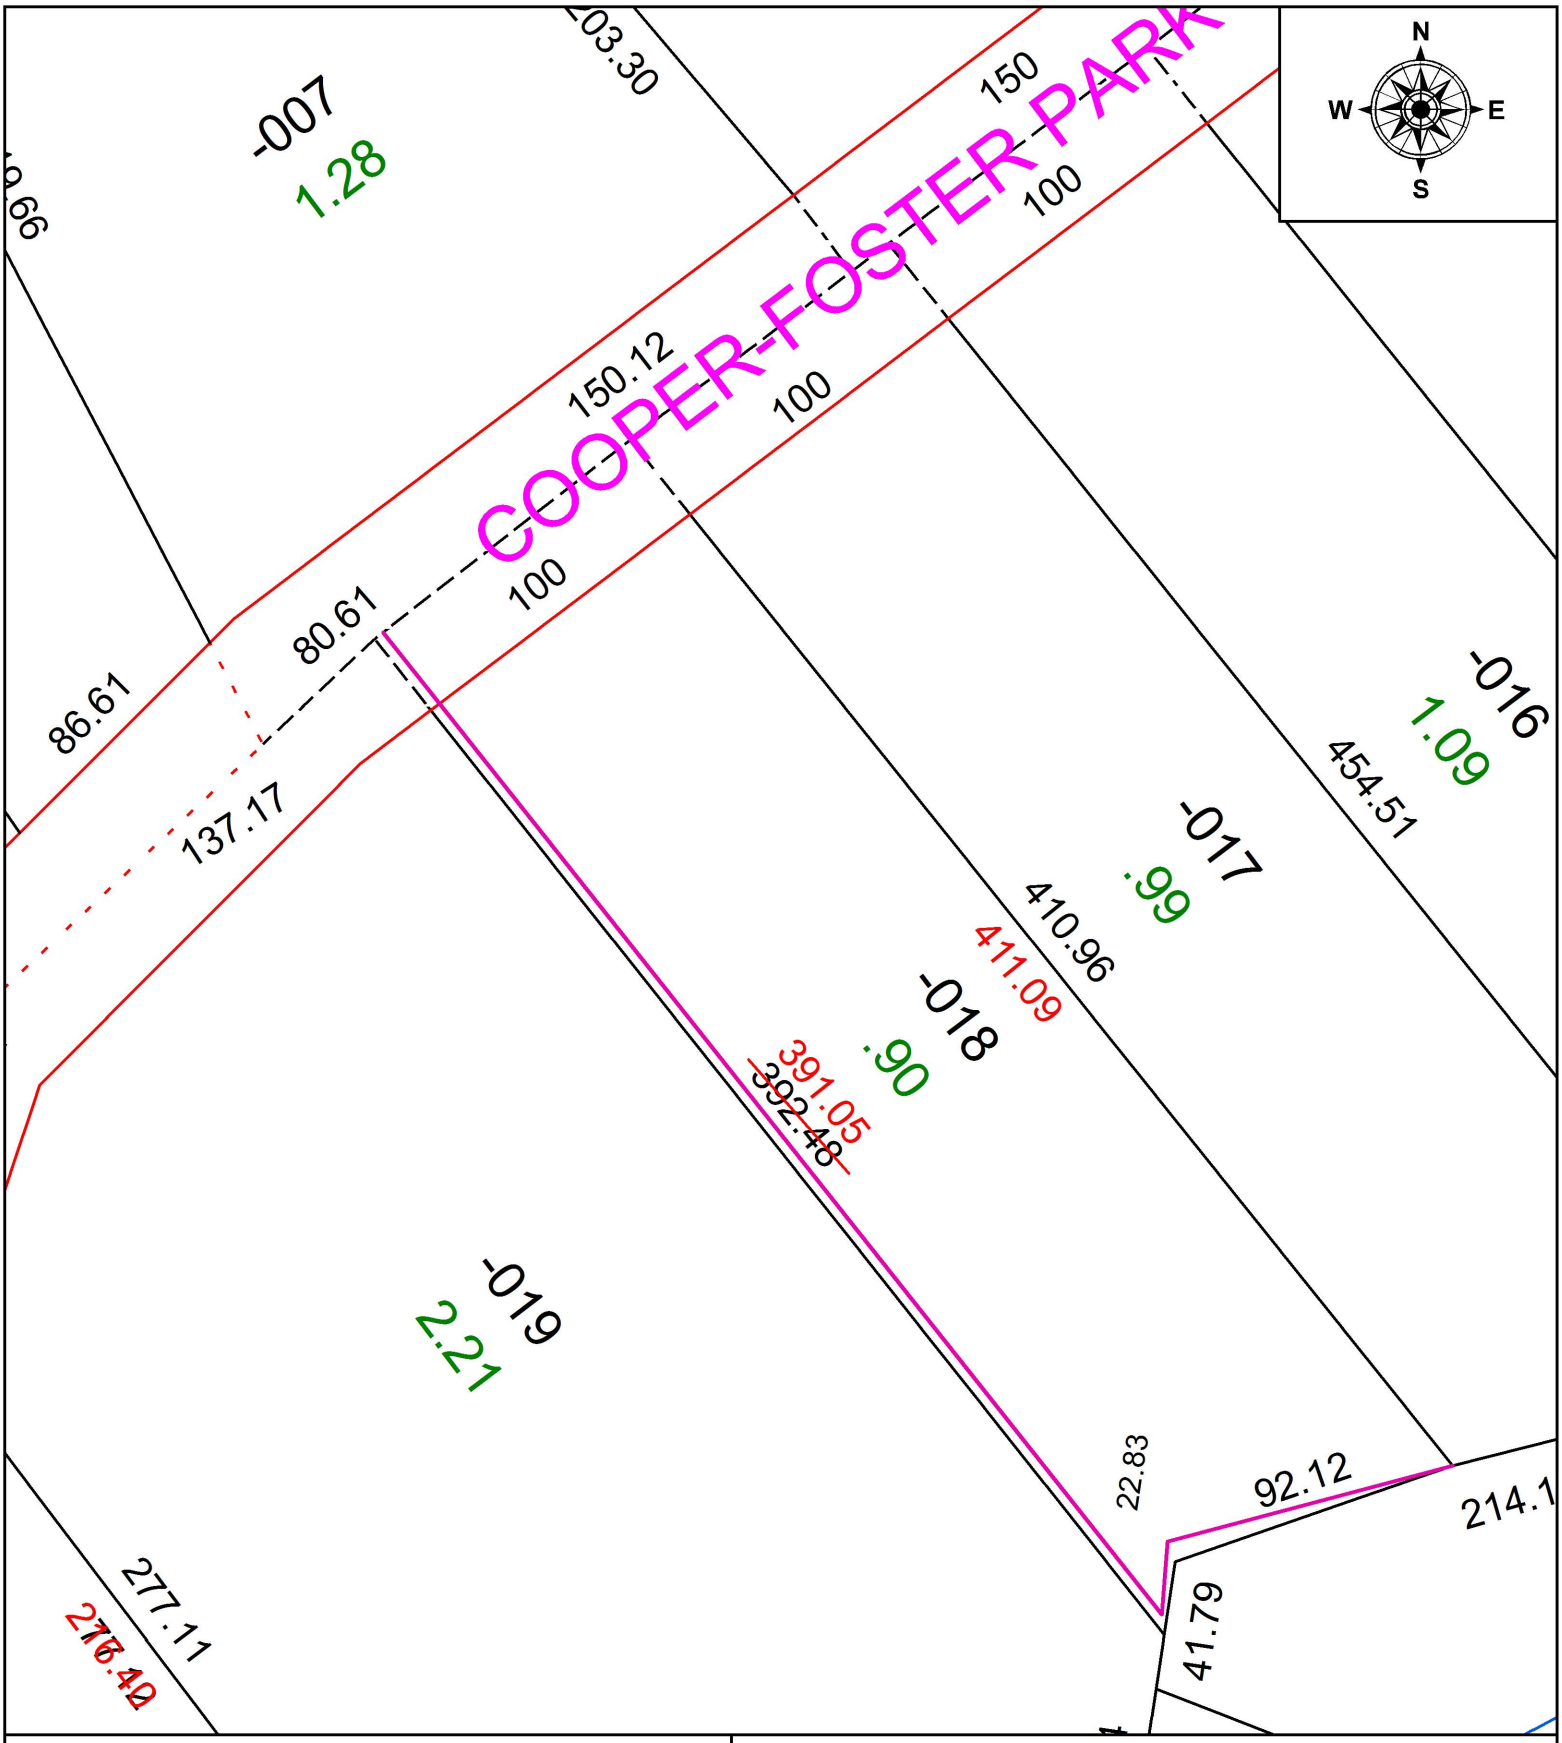

SPLITS/DEEDS PROCESSED
LORAIN COUNTY TAX MAP DEPARTMENT
226 MIDDLE AVE. ELYRIA, OH

SURVEYED BY: ROBERT A. DORNER
CLOSURE: 1: 48,000
MAP PAGE(S): 05-00-021
APPOVED BY: TJS **DATE:** 1/11/17
SCALE: 1" = 60' **PRIOR INSTRUMENT:** 2016-0602896