PARENT PARCEL: 12-00-044-000-022, -026
CHILD PARCEL: 12-00-044-000-074
STARTING POINT: INTERSECTION OF C/L OF CASTLEBAR CT. AND C/L OF COLUMBIA WEST RIVER RD.

16-03590

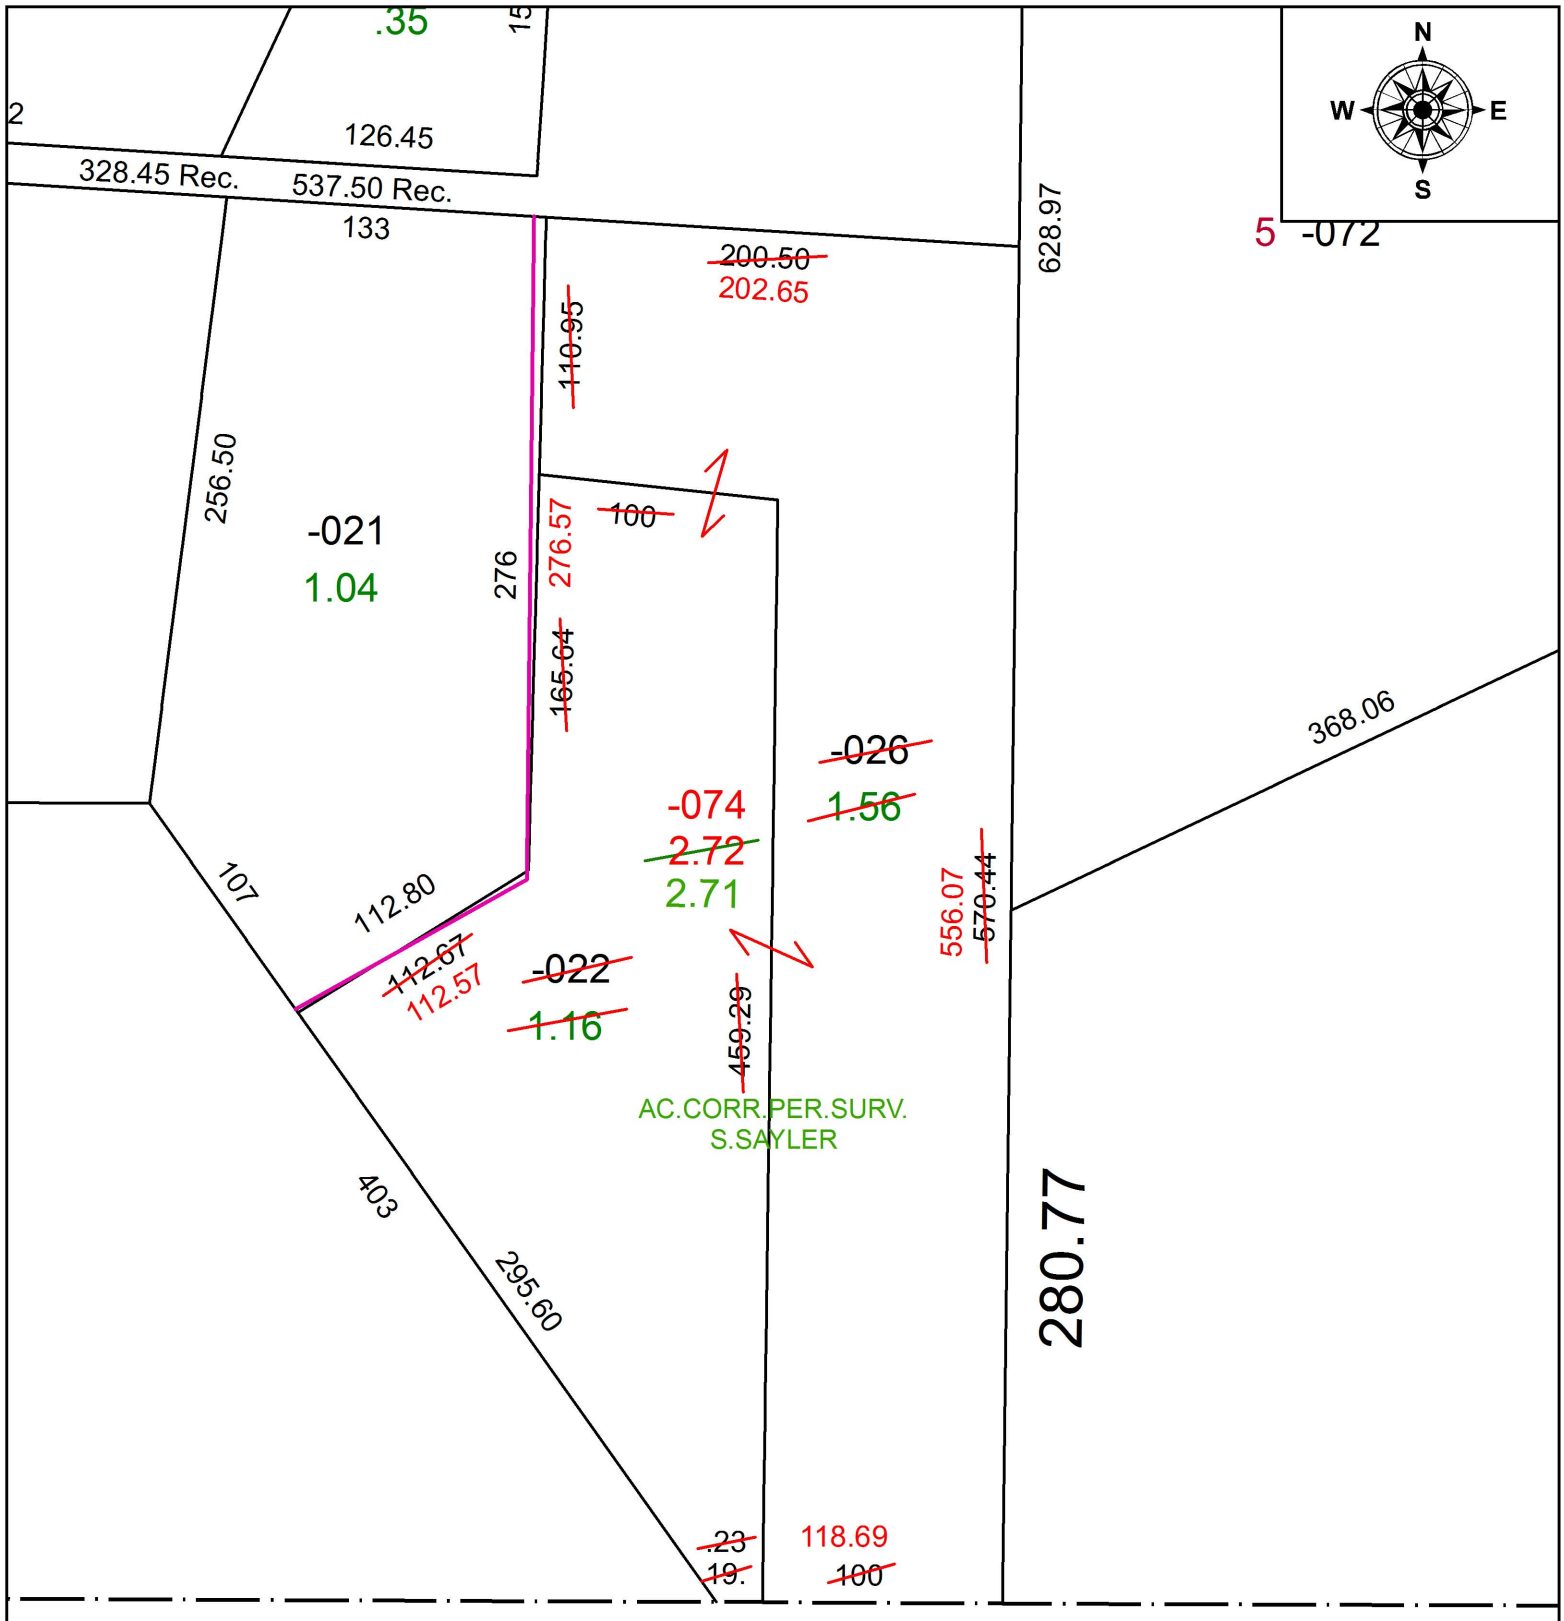

SPLITS/DEEDS PROCESSED
LORAIN COUNTY TAX MAP DEPARTMENT
226 MIDDLE AVE. ELYRIA, OH

SURVEYED BY: STUART W. SAYLER
CLOSURE: 1: 50,250
MAP PAGE(S): 12-00-044
APPOVED BY: RRM **DATE:** 10-26-16
SCALE: 1" = 80 **PRIOR INSTRUMENT:** 20120405255