**PARENT PARCEL:** 15-00-098-106-029, -047, -061, -062

**CHILD PARCEL:** 15-00-098-106-029, -061, -062, -066, -067

**STARTING POINT:** SOUTHEAST CORNER OF S/L 342

# 16-03591

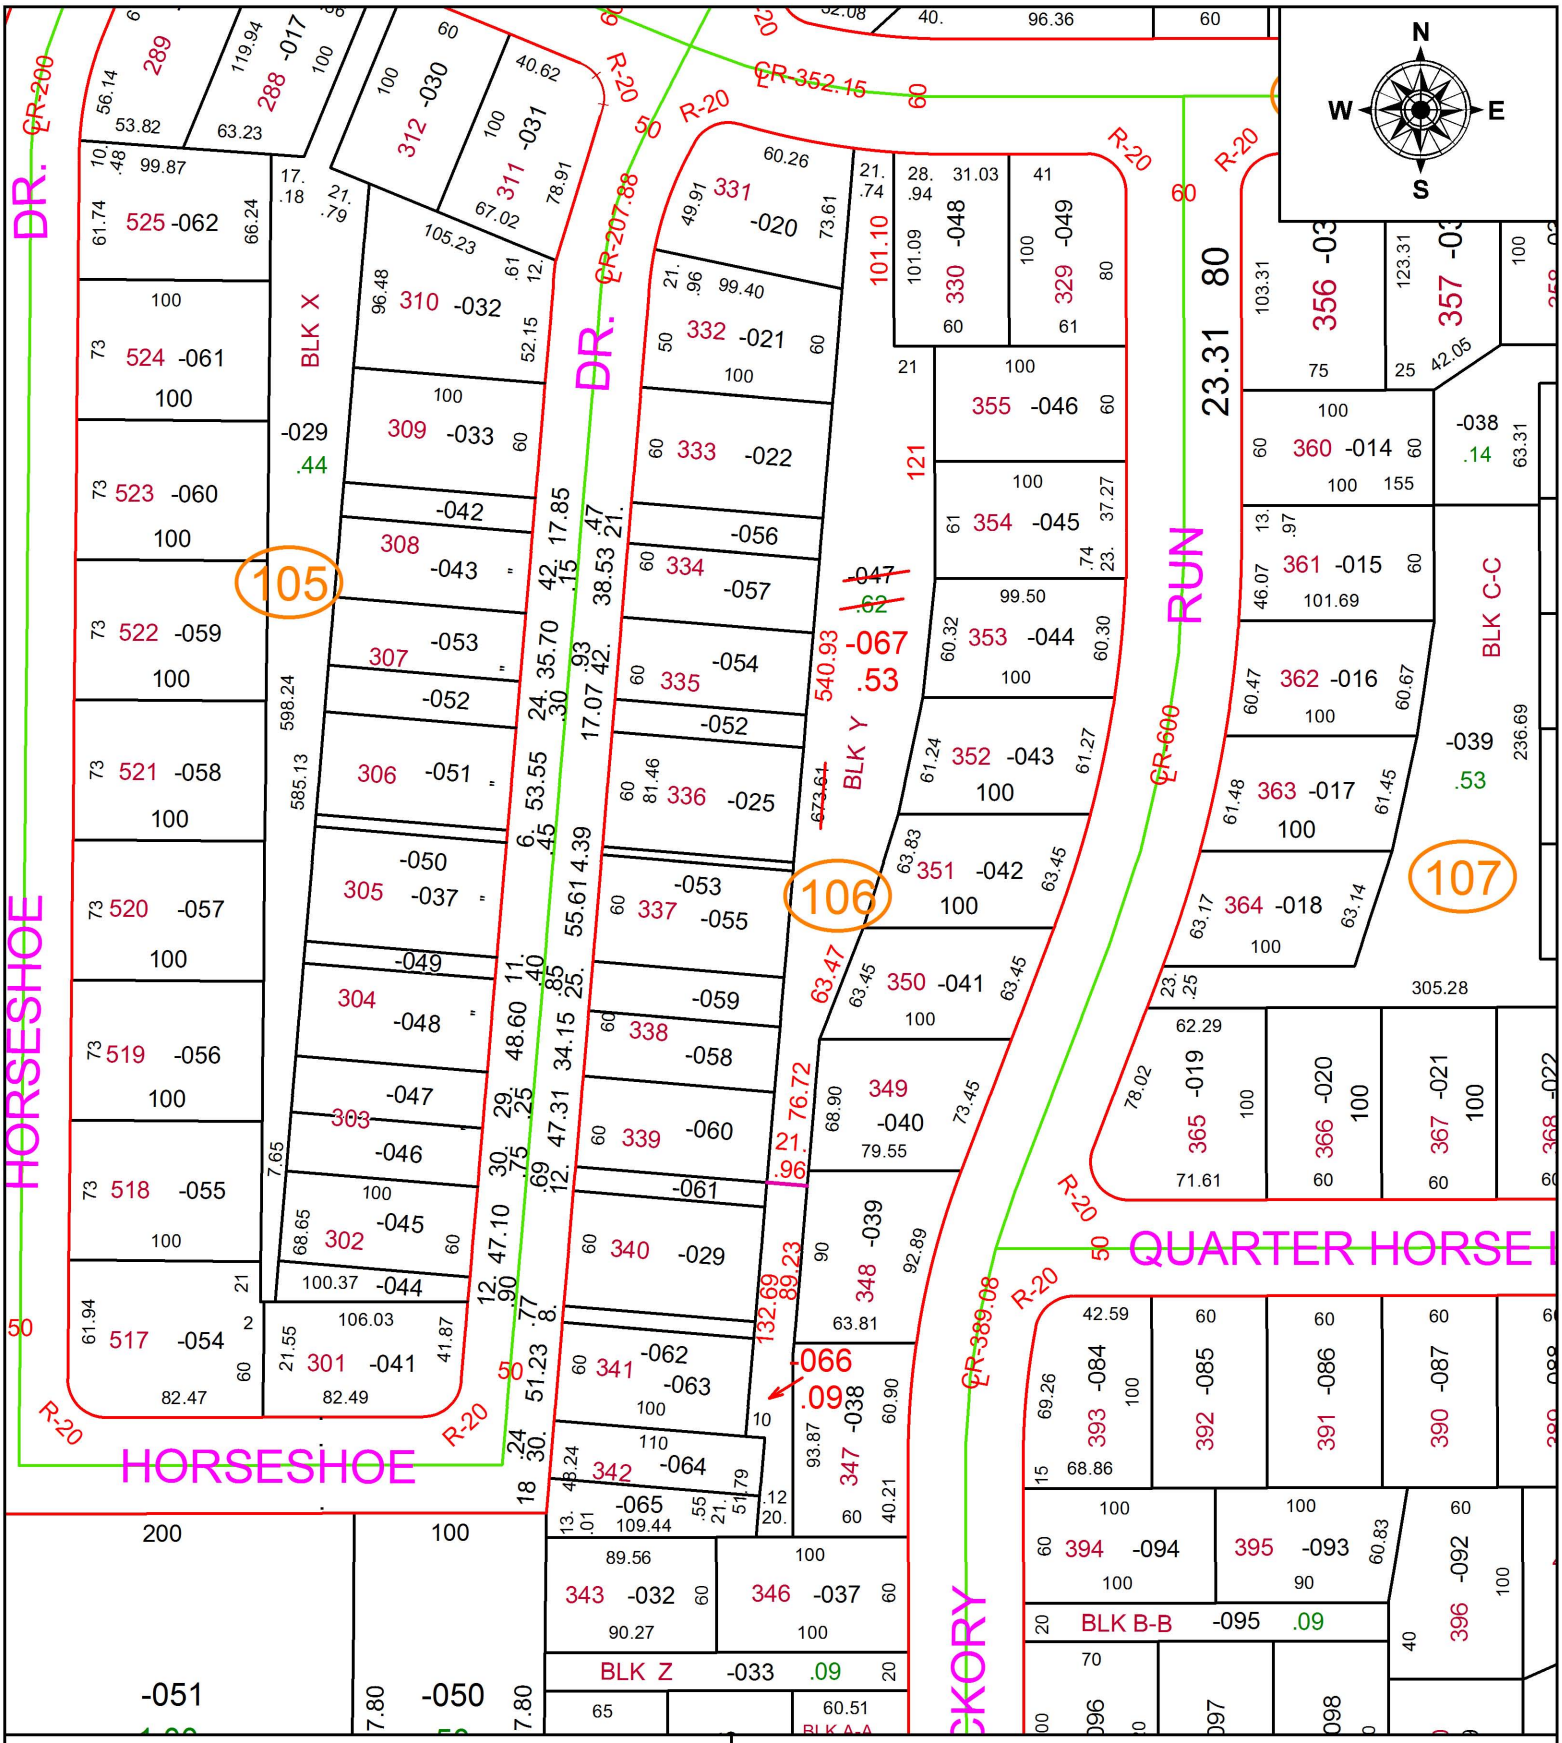


**SPLITS/DEEDS PROCESSED**

LORAIN COUNTY TAX MAP DEPARTMENT
226 MIDDLE AVE. ELYRIA, OH

**SURVEYED BY:** THOMAS A. SIMON
**CLOSURE:** 1: 96,802
**MAP PAGE(S):** 15-00-098
**APPOVED BY:** RRM **DATE:** 10-28-16
**SCALE:** 1" = 100 **PRIOR INSTRUMENT:** 20150554268