PARENT PARCEL: 02-02-017-114-003

CHILD PARCEL: 02-02-017-114-016 THRU -018

STARTING POINT: VAC. OF POLE AVE. BETWEEN THE SOUTH LINE OF W. 24TH ST. & THE SOUTH LINE OF 02-02-017-114-001

17-03594-V

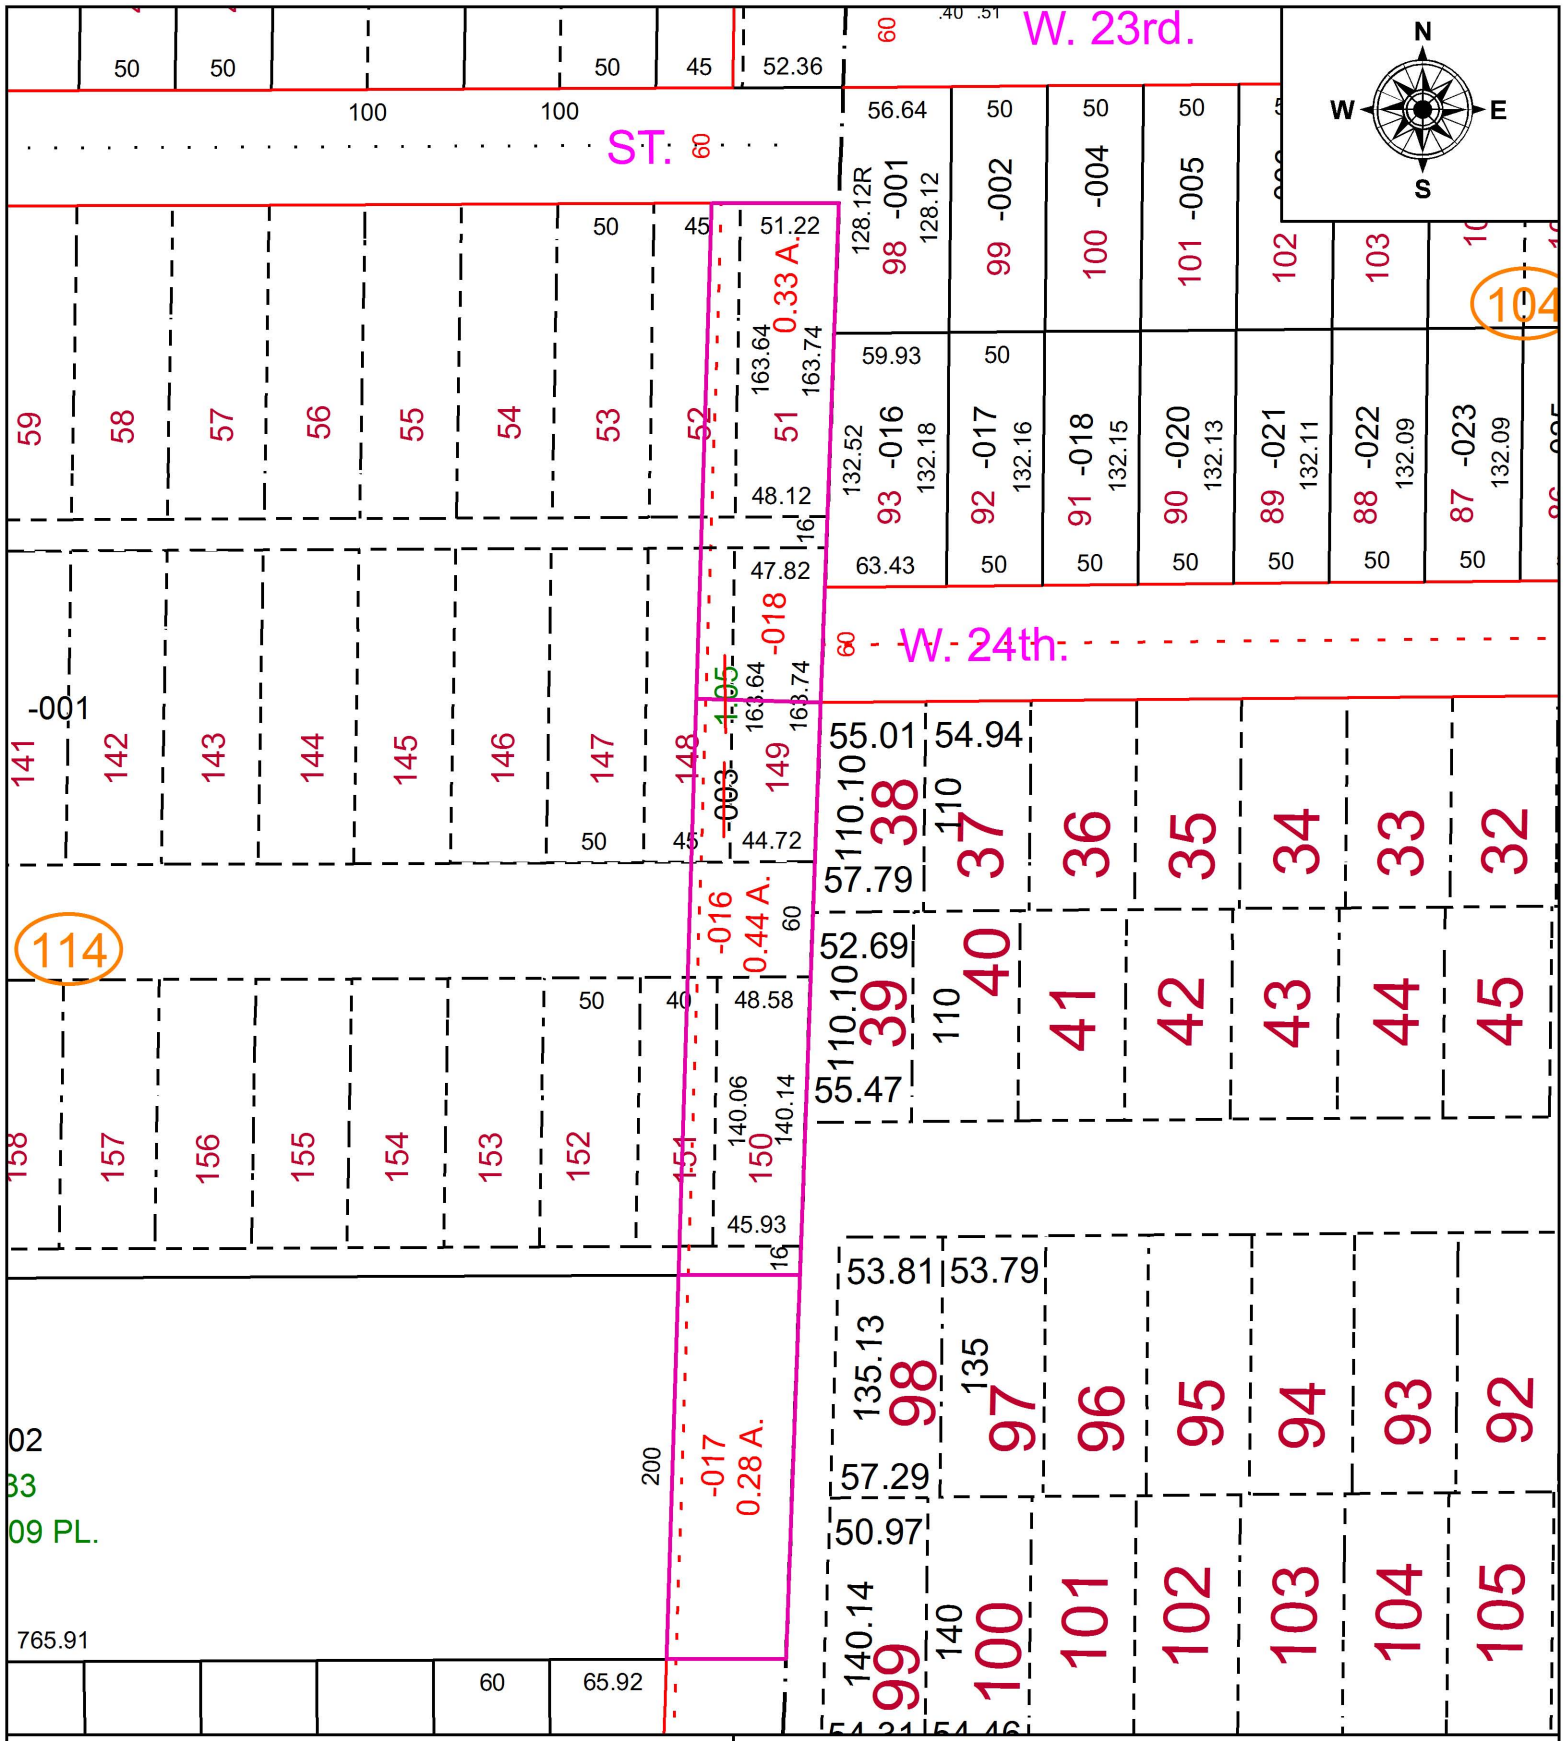

SPLITS/DEEDS PROCESSED

LORAIN COUNTY TAX MAP DEPARTMENT
226 MIDDLE AVE. ELYRIA, OH

SURVEYED BY: NA
CLOSURE: NA
MAP PAGE(S): 02-02-017
APPOVED BY: TJS **DATE:** 3/23/17
SCALE: 1" = 100' **PRIOR INSTRUMENT:** DV XXXX/XXXX