PARENT PARCEL: 09-00-084-101-080, -081
CHILD PARCEL: 09-00-084-101-099 THRU -101
STARTING POINT: INTERSECTION OF C/L OF PYLE SOUTH AMHERST RD. AND C/L OF W. LORAIN ST.

16-03595

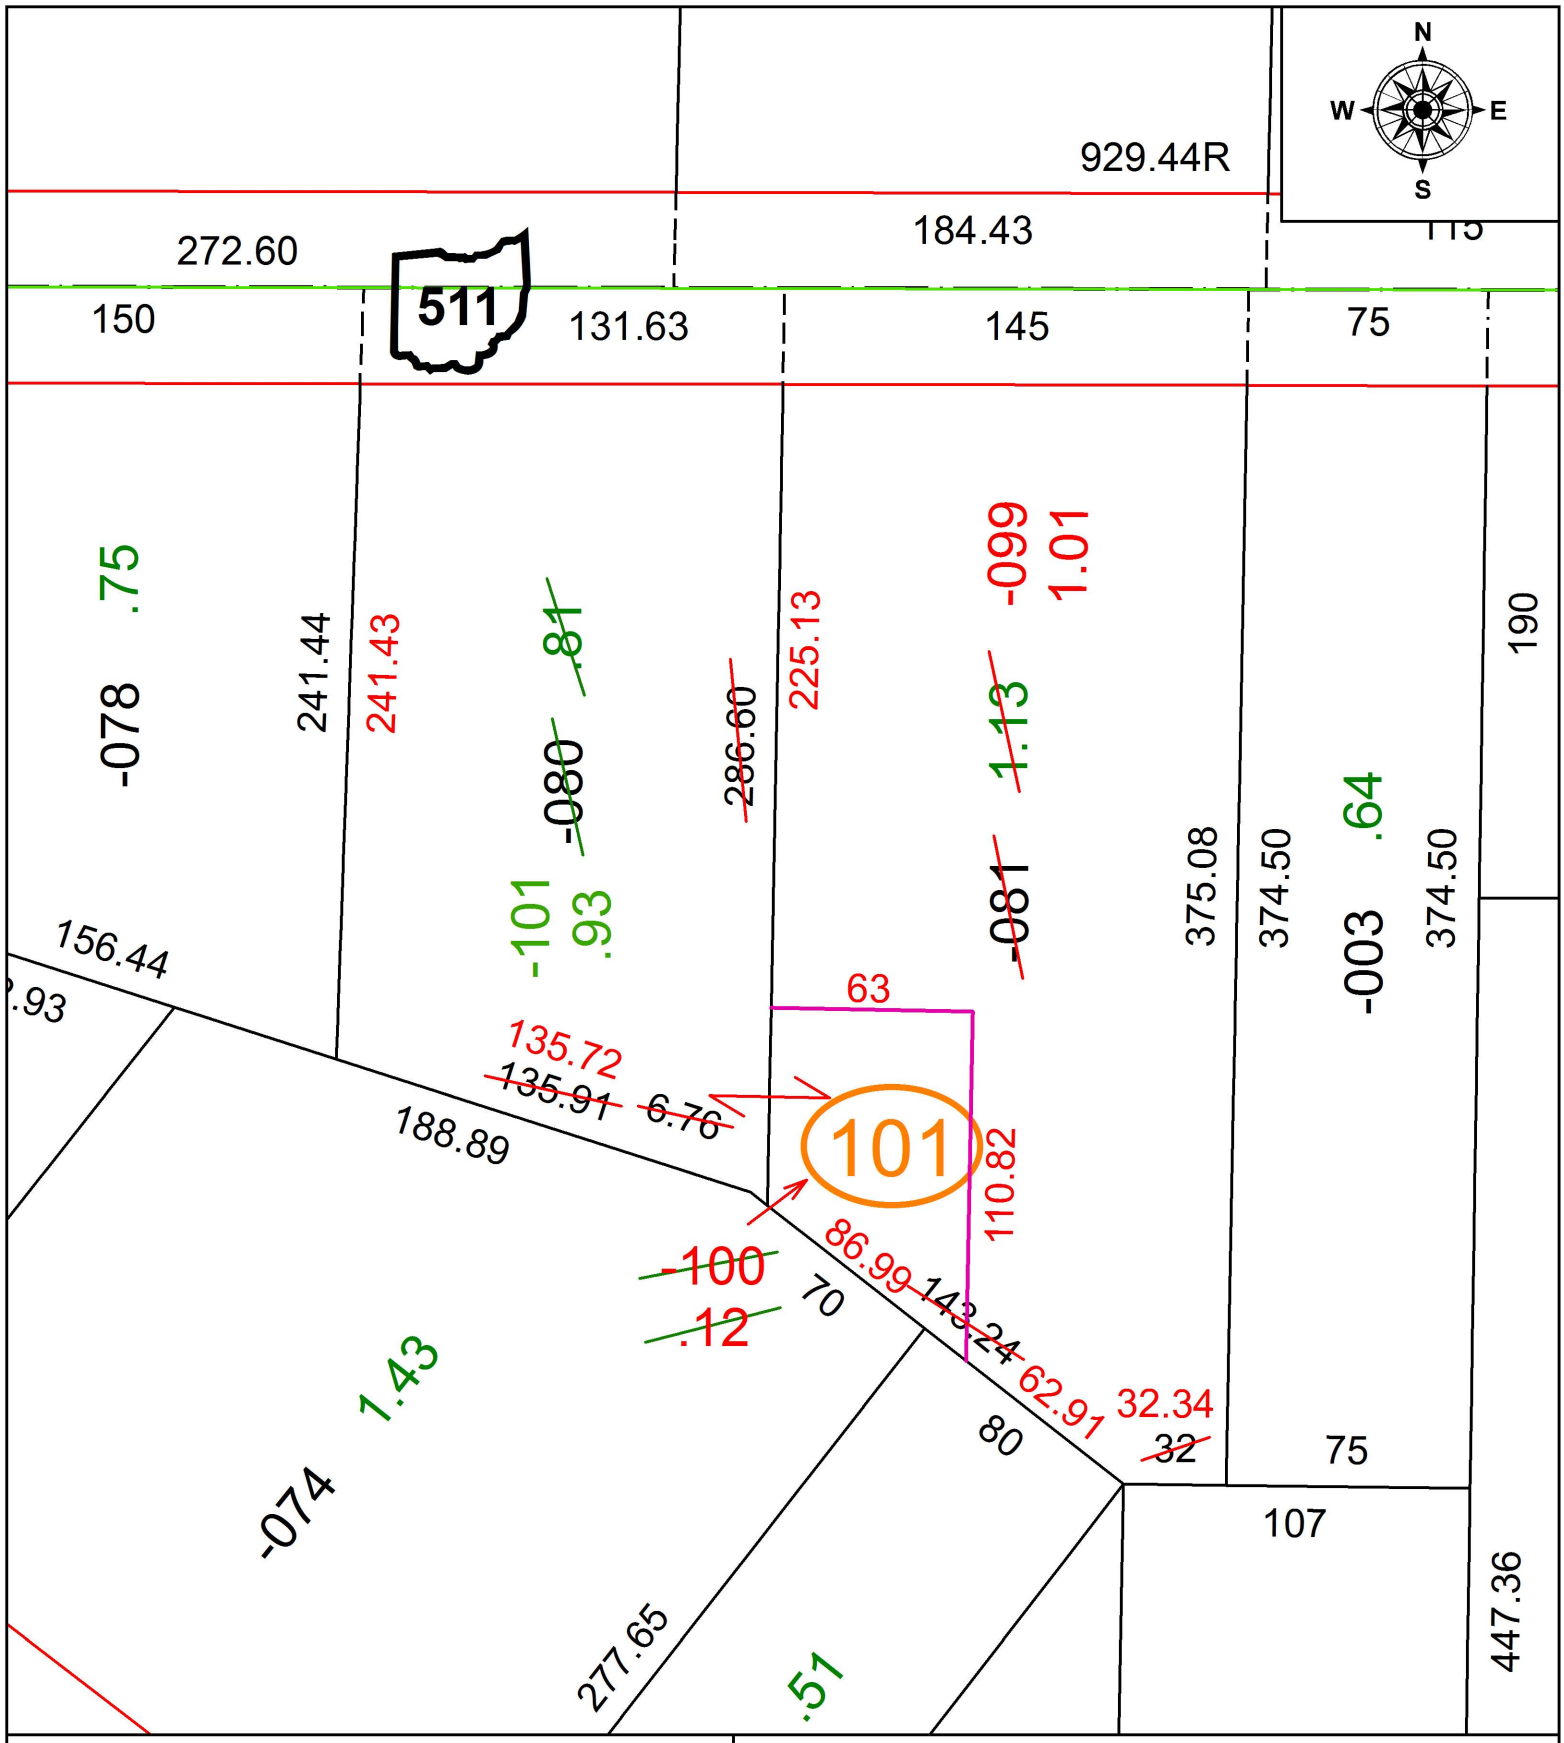

SPLITS/DEEDS PROCESSED
LORAIN COUNTY TAX MAP DEPARTMENT
226 MIDDLE AVE. ELYRIA, OH

SURVEYED BY: JAMES A. RESAR
CLOSURE: 1: 306,406
MAP PAGE(S): 9-00-084
APPOVED BY: RRM **DATE:** 11-3-16
SCALE: 1" = 60 **PRIOR INSTRUMENT:** 20140493526