PARENT PARCEL: 01-00-036-000-043, 01-00-045-000-039

CHILD PARCEL: 01-00-036-000-053, -054, 01-00-045-000-039

STARTING POINT: INTERSECTION OF C/L OF COOPER FOSTER PARK RD. AND C/L OF SUNNYSIDE RD.

16-03598

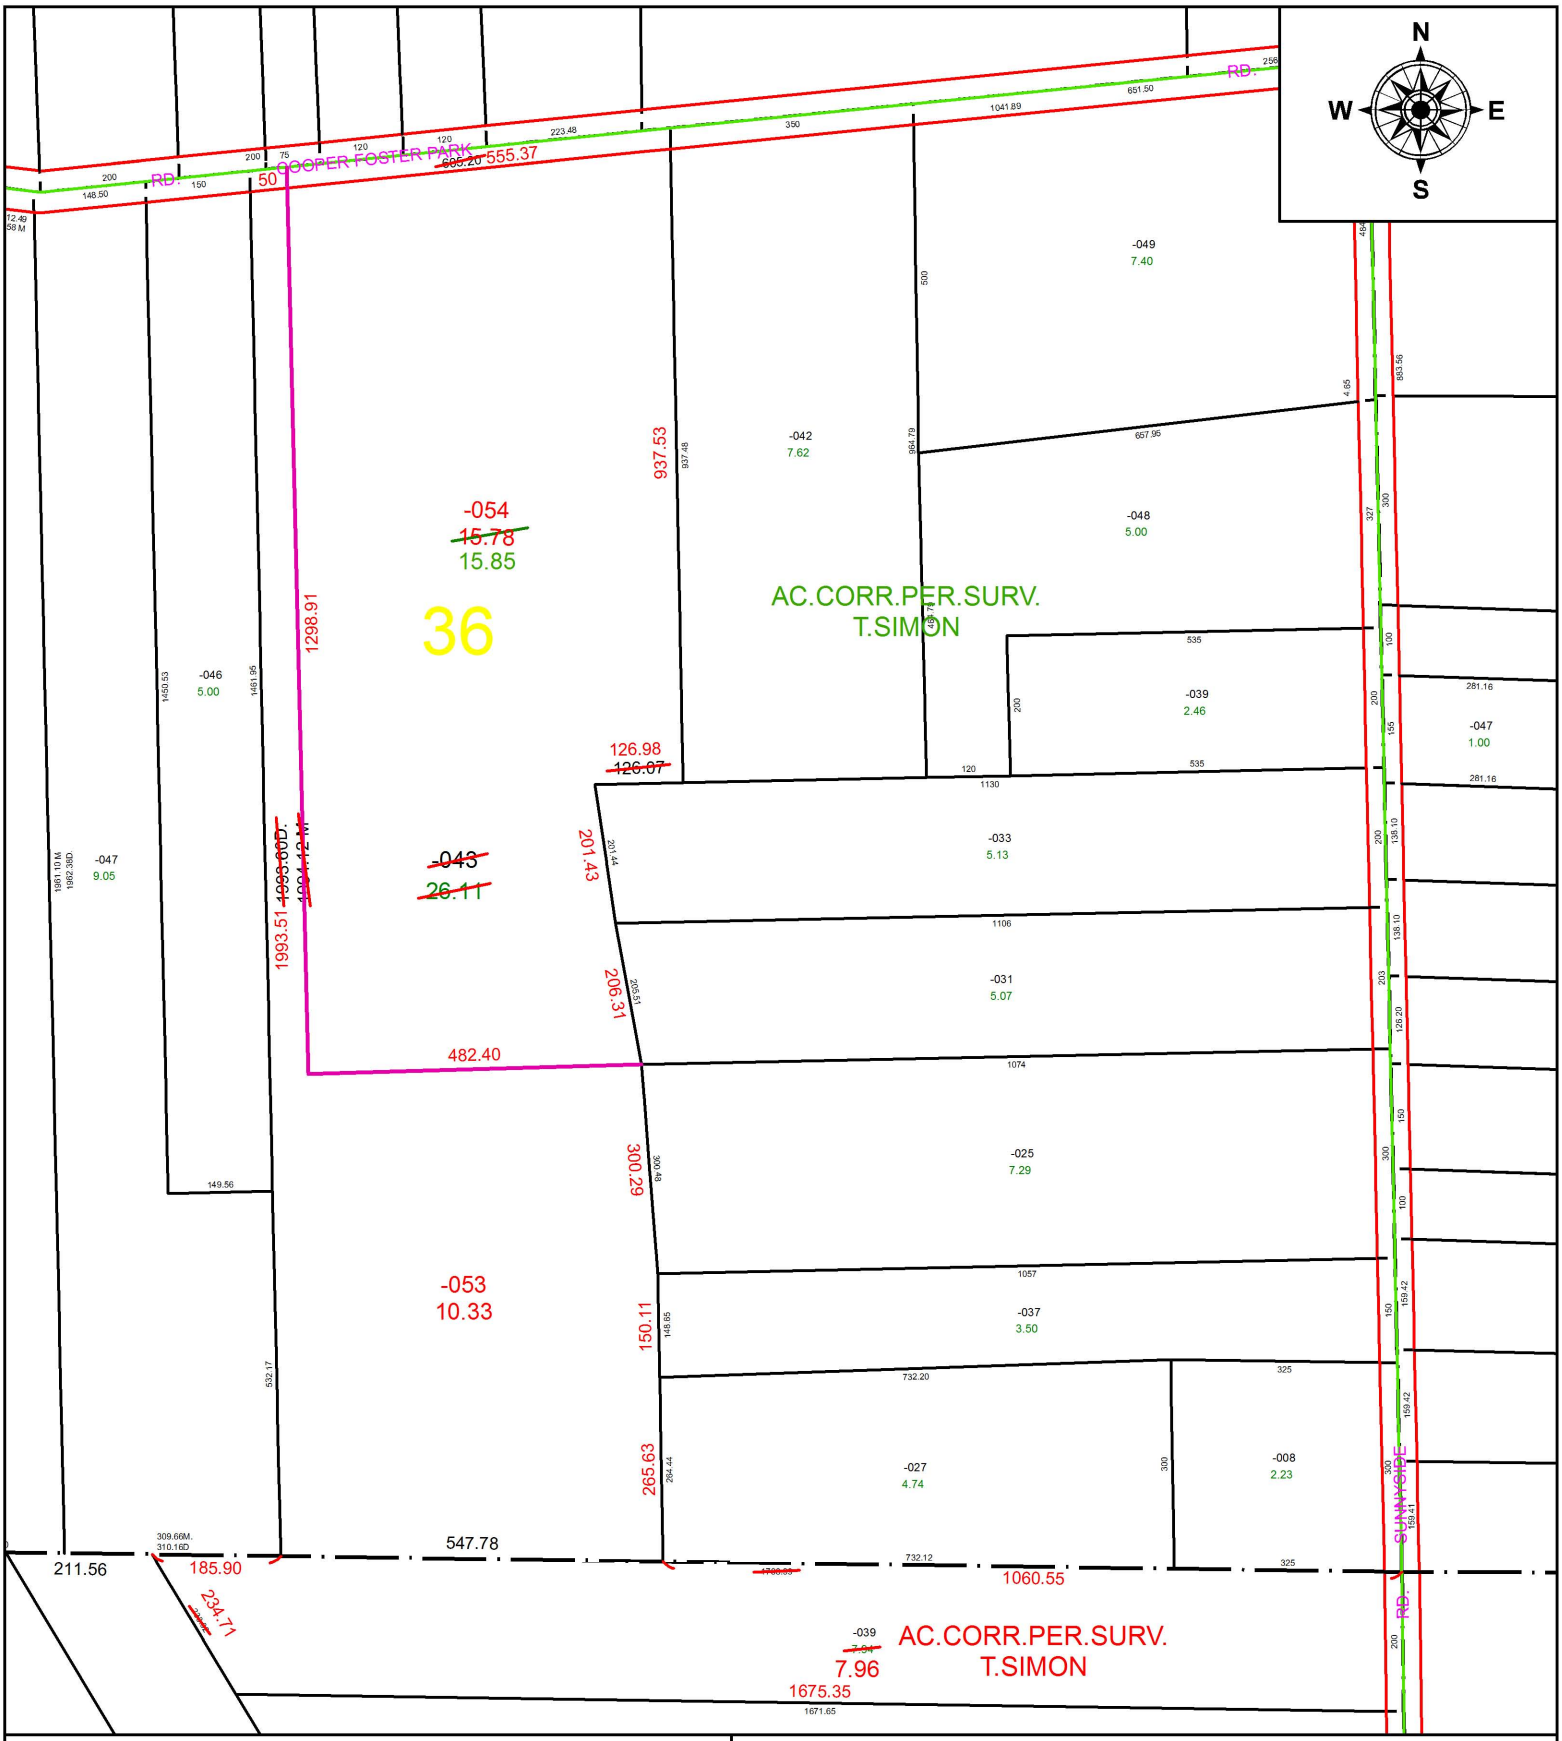

SPLITS/DEEDS PROCESSED

LORAIN COUNTY TAX MAP DEPARTMENT
226 MIDDLE AVE. ELYRIA, OH

SURVEYED BY: THOMAS A. SIMON
CLOSURE: 1: 763,516
MAP PAGE(S): 1-00-036
APPOVED BY: RRM **DATE:** 11-18-16
SCALE: 1" = 275 **PRIOR INSTRUMENT:** 2012040137