PARENT PARCEL: 04-00-018-101-014
CHILD PARCEL: 04-00-018-640-008 THRU -010
STARTING POINT: NORTHEAST CORNER OF INWOOD BEACH SUB. NO.1

16-03599

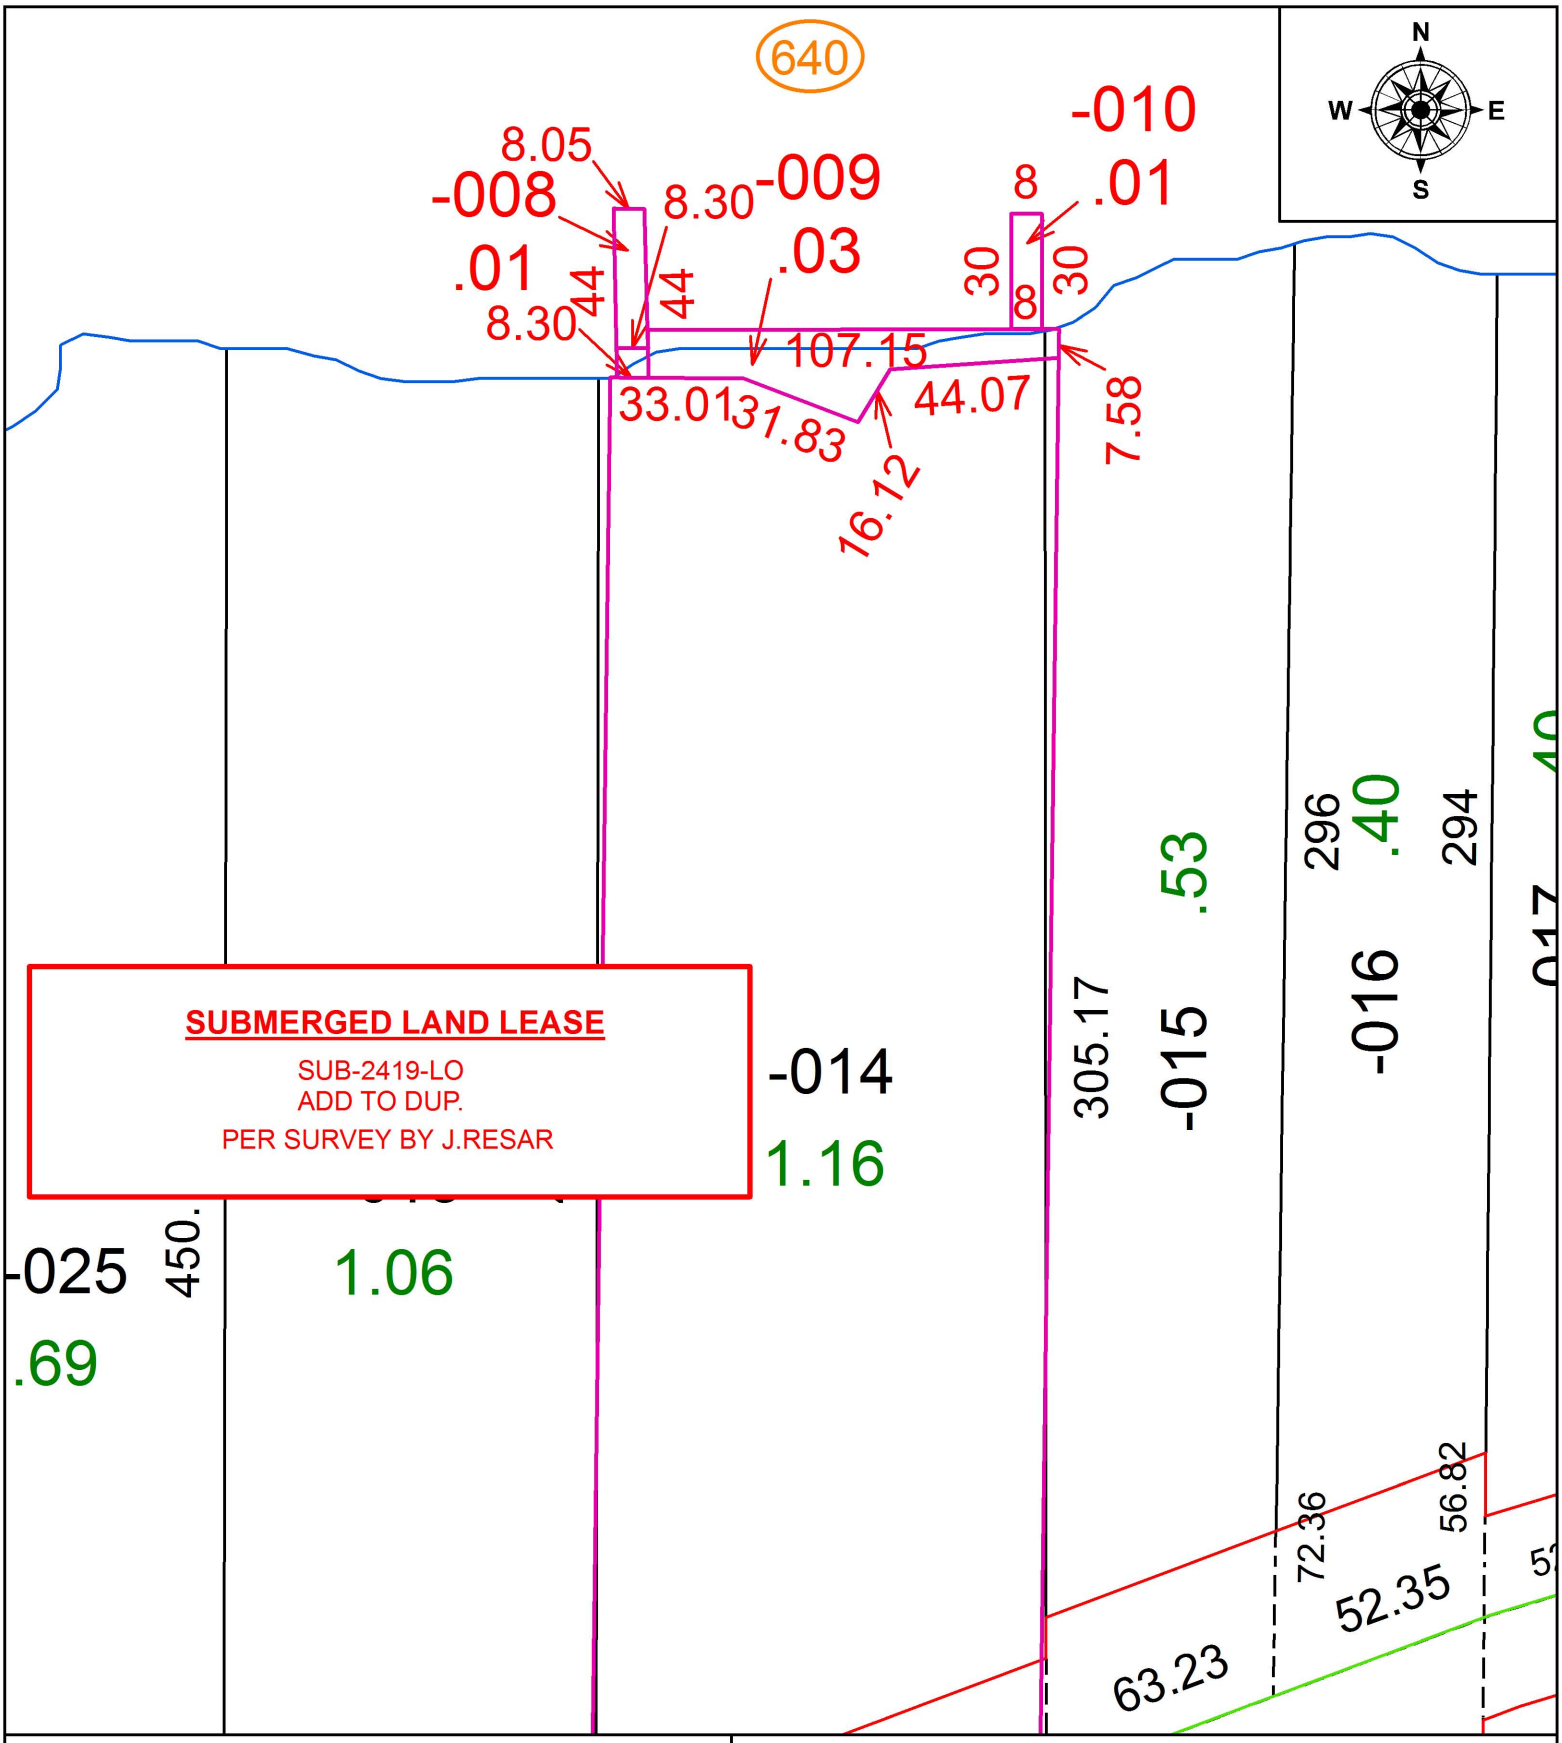

SPLITS/DEEDS PROCESSED
LORAIN COUNTY TAX MAP DEPARTMENT
226 MIDDLE AVE. ELYRIA, OH

SURVEYED BY: JAMES A. RESAR
CLOSURE: 1: 114,446
MAP PAGE(S): 4-00-018
APPOVED BY: RRM **DATE:** 11-21-16
SCALE: 1" = 50 **PRIOR INSTRUMENT:** 20140521570