PARENT PARCEL: 06-26-094-103-009
CHILD PARCEL: 06-26-094-103-031, -032
STARTING POINT: SOUTHWEST HALF OF S/L 2 IN PARSCH'S SUB.

17-03601-U

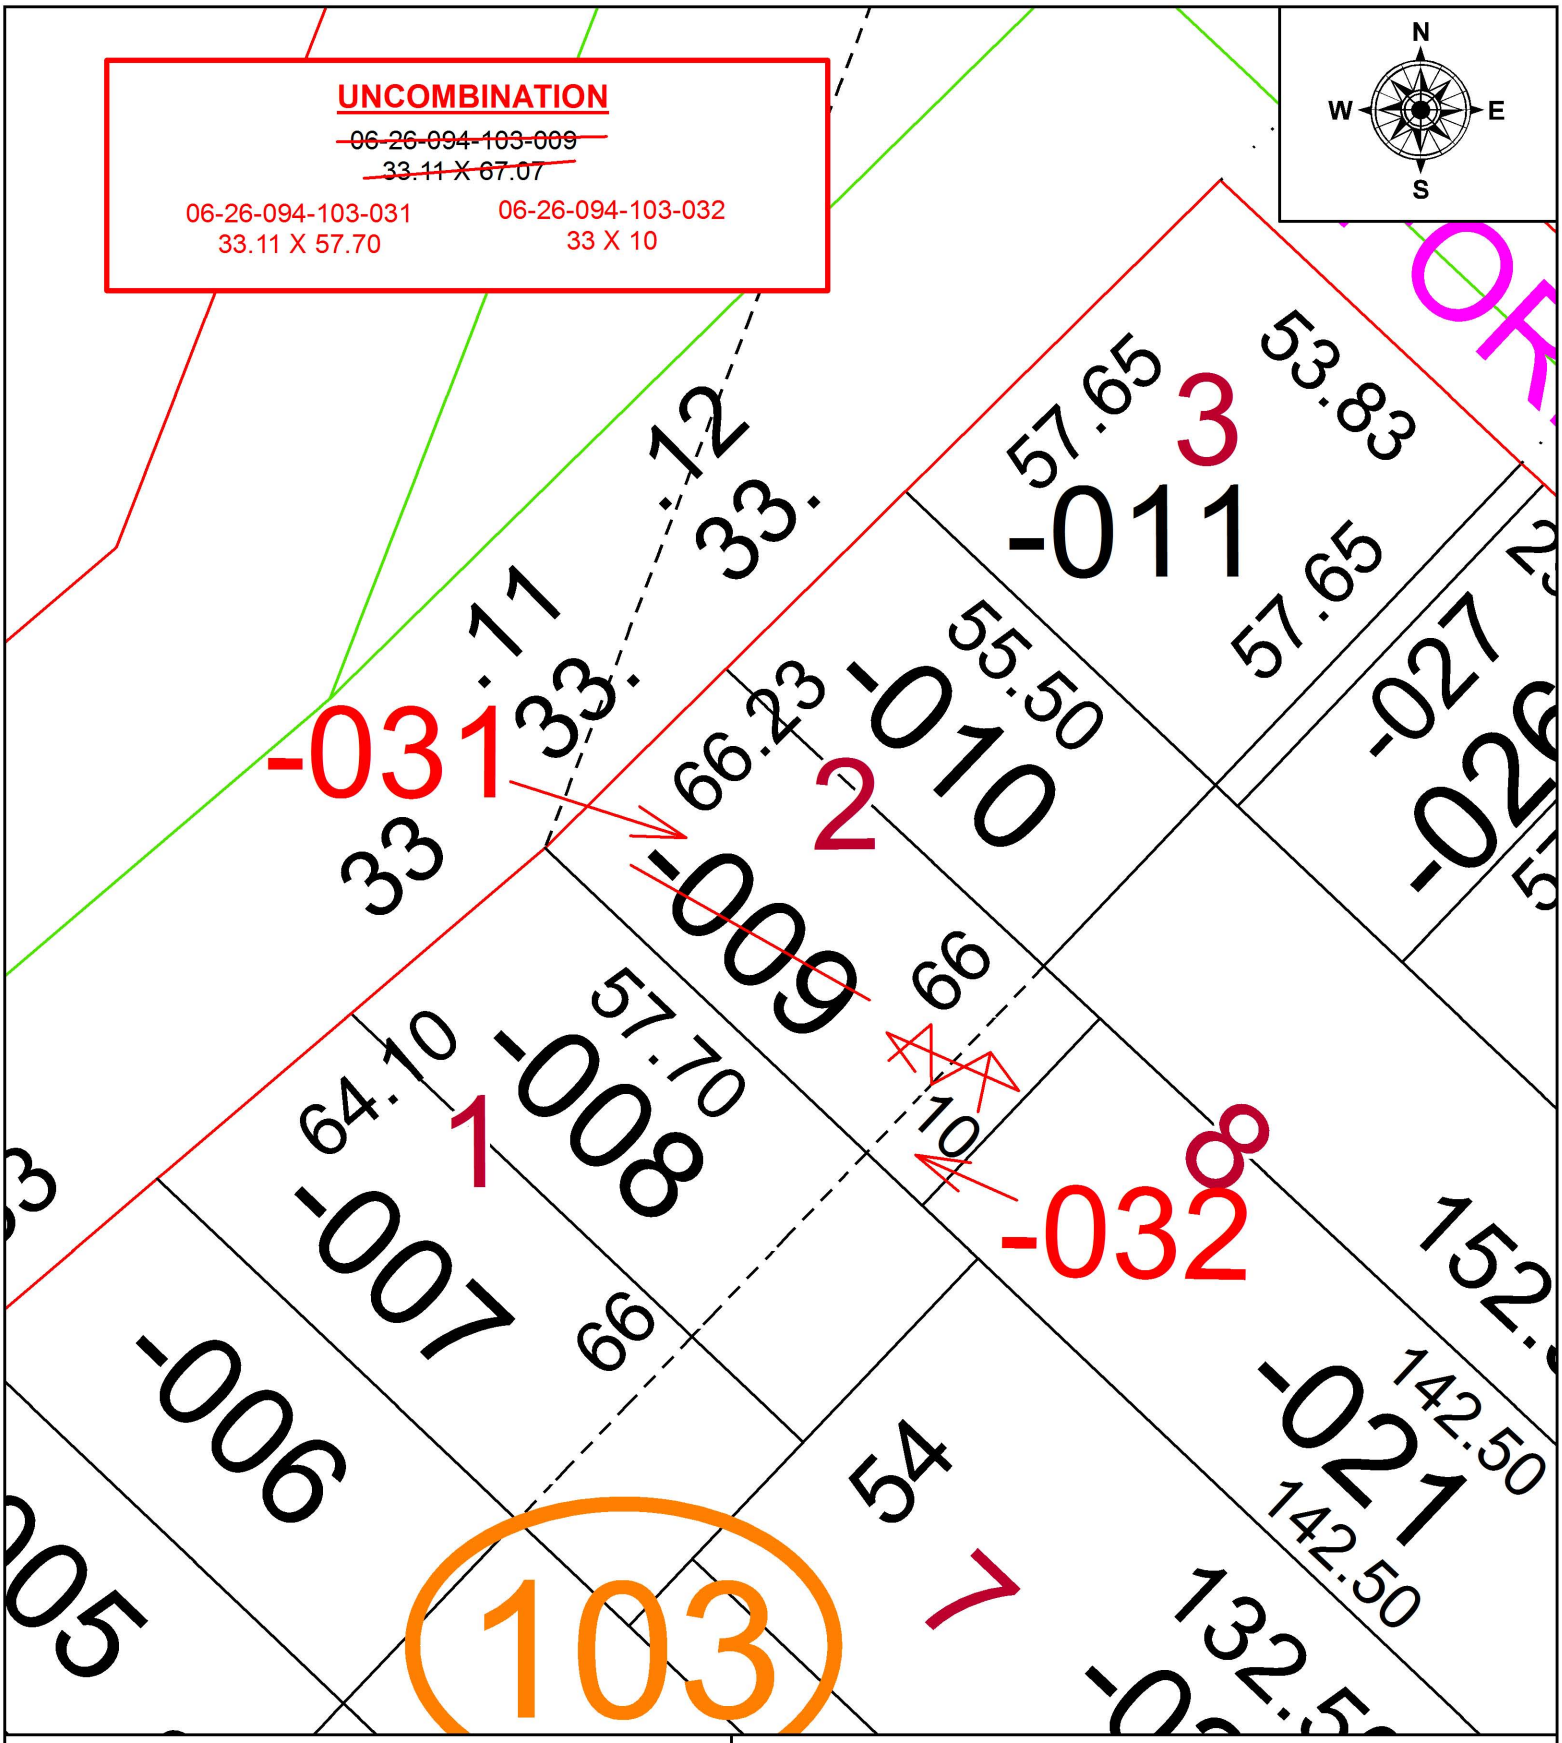

SPLITS/DEEDS PROCESSED
LORAIN COUNTY TAX MAP DEPARTMENT
226 MIDDLE AVE. ELYRIA, OH

SURVEYED BY: N/A
CLOSURE: N/A
MAP PAGE(S): 6-101
APPOVED BY: RRM **DATE:** 2-25-16
SCALE: 1" = 25 **PRIOR INSTRUMENT:** 20160612580