PARENT PARCEL: 01-00-063-000-050

CHILD PARCEL: 01-00-063-000-053 THRU -056

STARTING POINT: INTERSECTION OF C/L OF NORTH RIDGE RD, AND C/L OF GORE ORPHANAGE RD.

16-03601

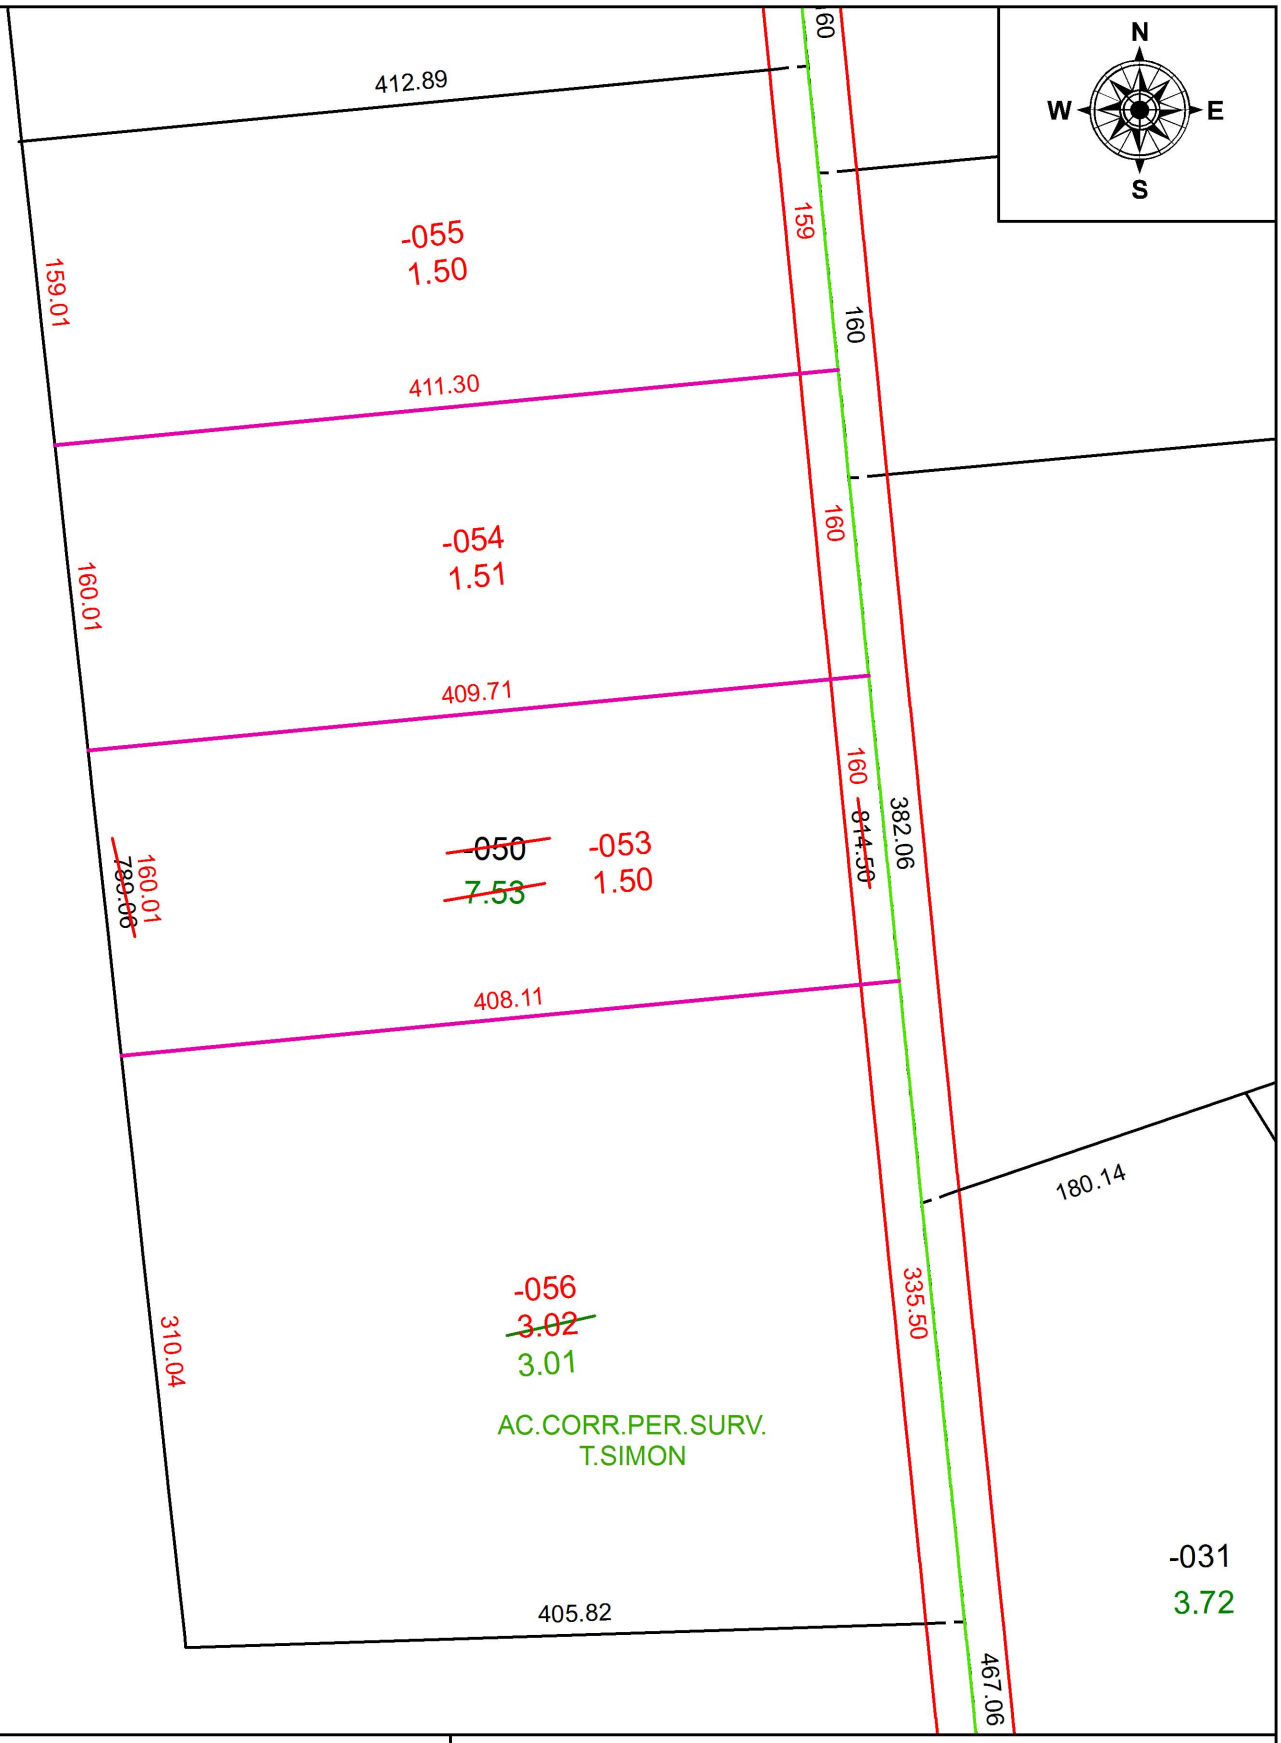

SPLITS/DEEDS PROCESSED

LORAIN COUNTY TAX MAP DEPARTMENT
226 MIDDLE AVE. ELYRIA, OH

SURVEYED BY: THOMAS A. SIMON
CLOSURE: 1: 238,640
MAP PAGE(S): 1-00-063
APPOVED BY: RRM **DATE:** 11-28-16
SCALE: 1" = 100 **PRIOR INSTRUMENT:** 20160609547