PARENT PARCEL: 05-00-099-000-206
CHILD PARCEL: 05-00-099-000-209 THRU -211
STARTING POINT: INTERSECTION OF C/L OF ROME BEAUTY DR. AND C/L OF ORCHARD GLEN DR.

16-03604

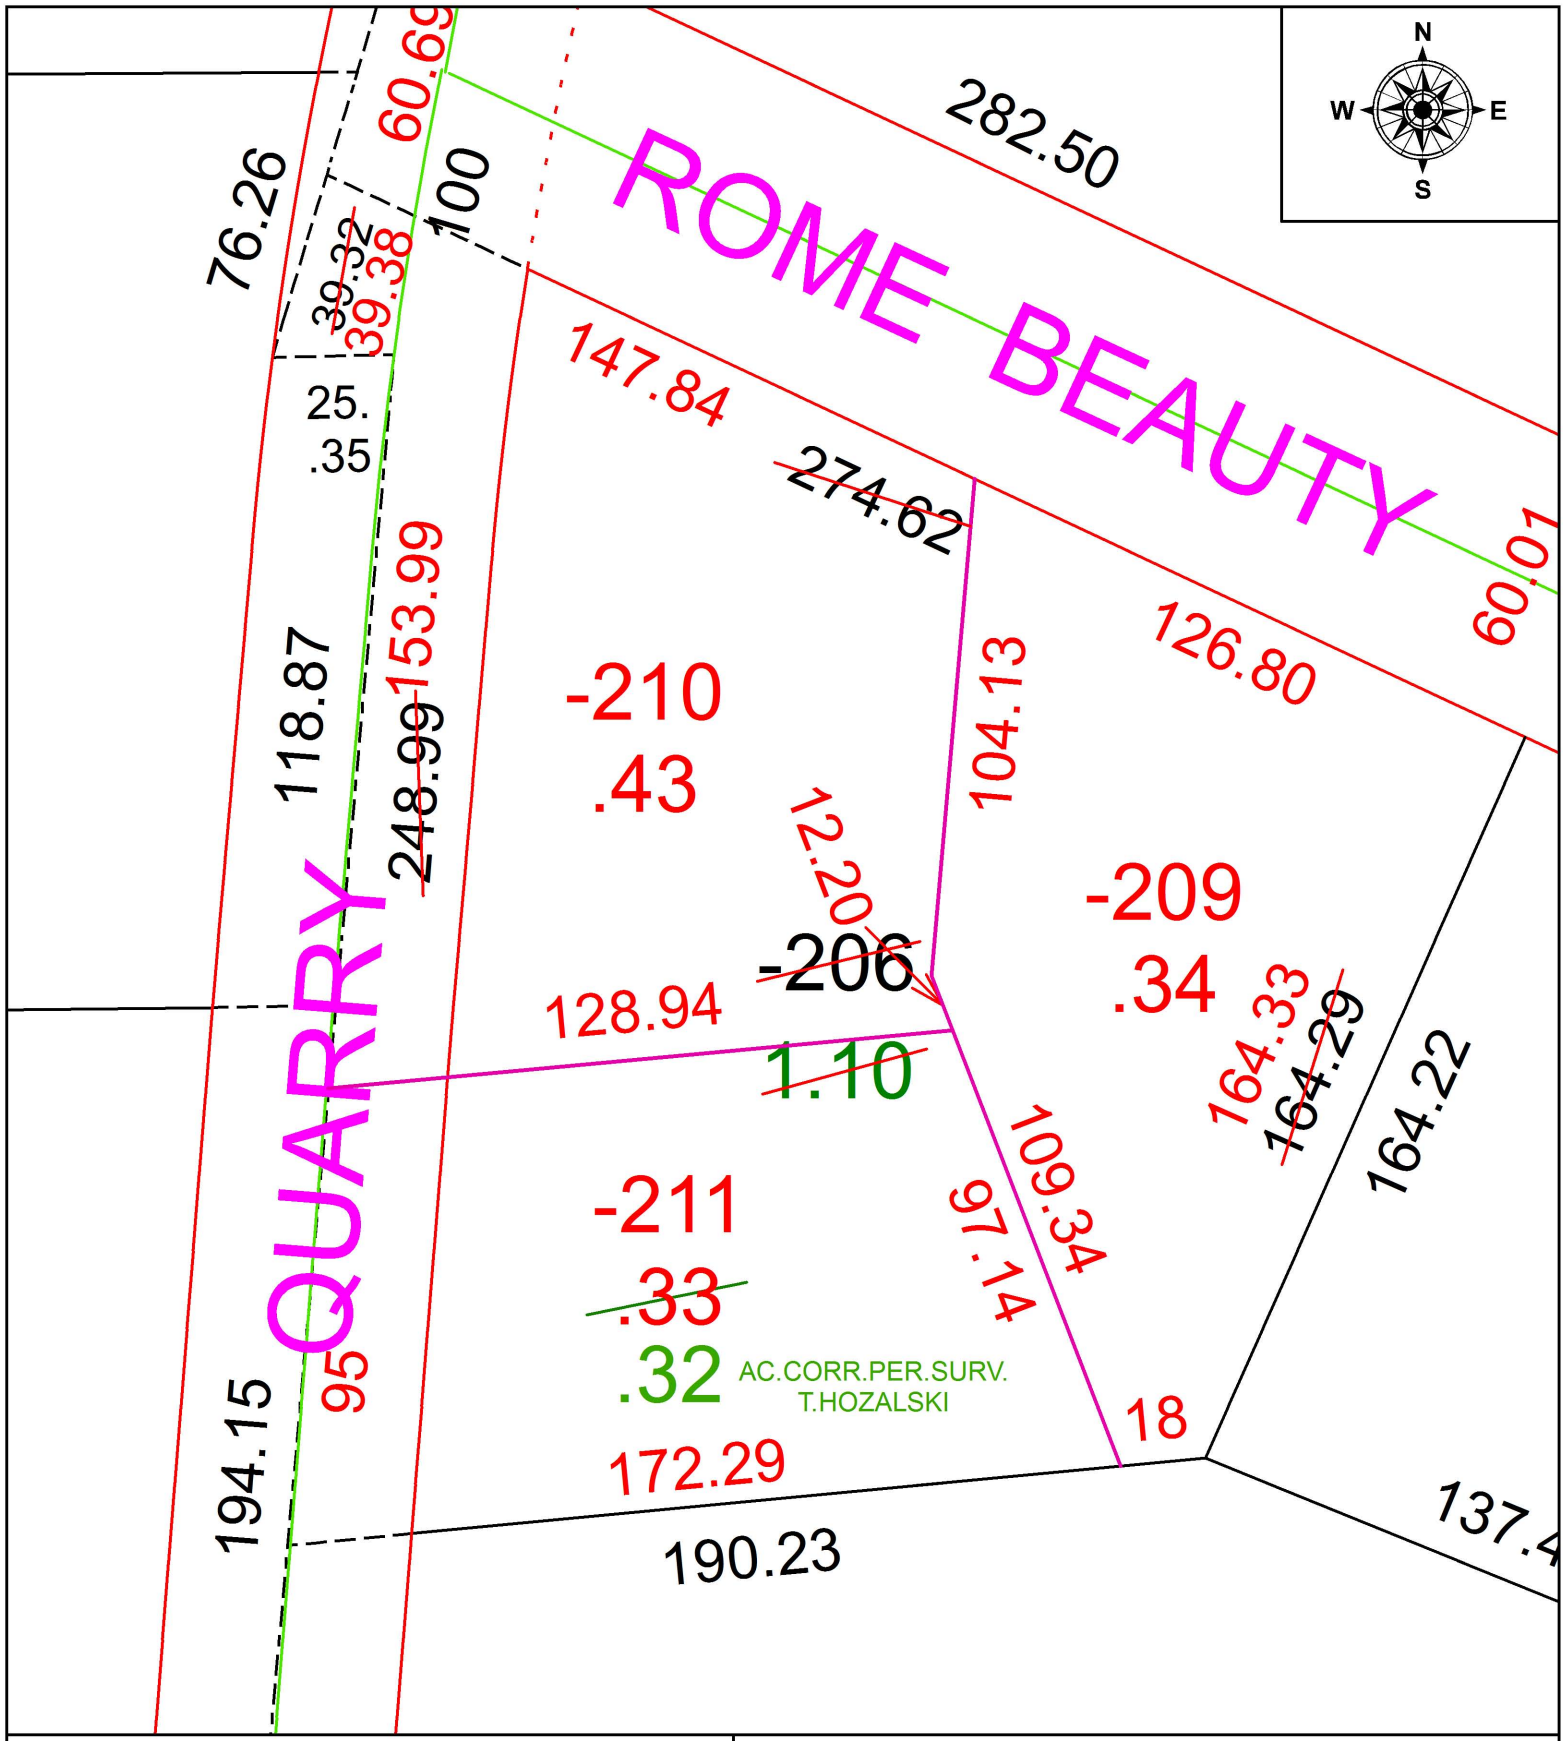

SPLITS/DEEDS PROCESSED
LORAIN COUNTY TAX MAP DEPARTMENT
226 MIDDLE AVE. ELYRIA, OH

SURVEYED BY: TIMOTHY D. HOZALSKI
CLOSURE: 1: 52,598
MAP PAGE(S): 5-00-099
APPOVED BY: RRM **DATE:** 12-1-16
SCALE: 1" = 40 **PRIOR INSTRUMENT:** 20160577234