PARENT PARCEL: 05-00-036-102-021 & -022
CHILD PARCEL: MAP CORR. ONLY
STARTING POINT: CL OF ELYRIA AVE. & EAS LINE OF AMHERST VILLAGE CORP. LINE

17-03606-C

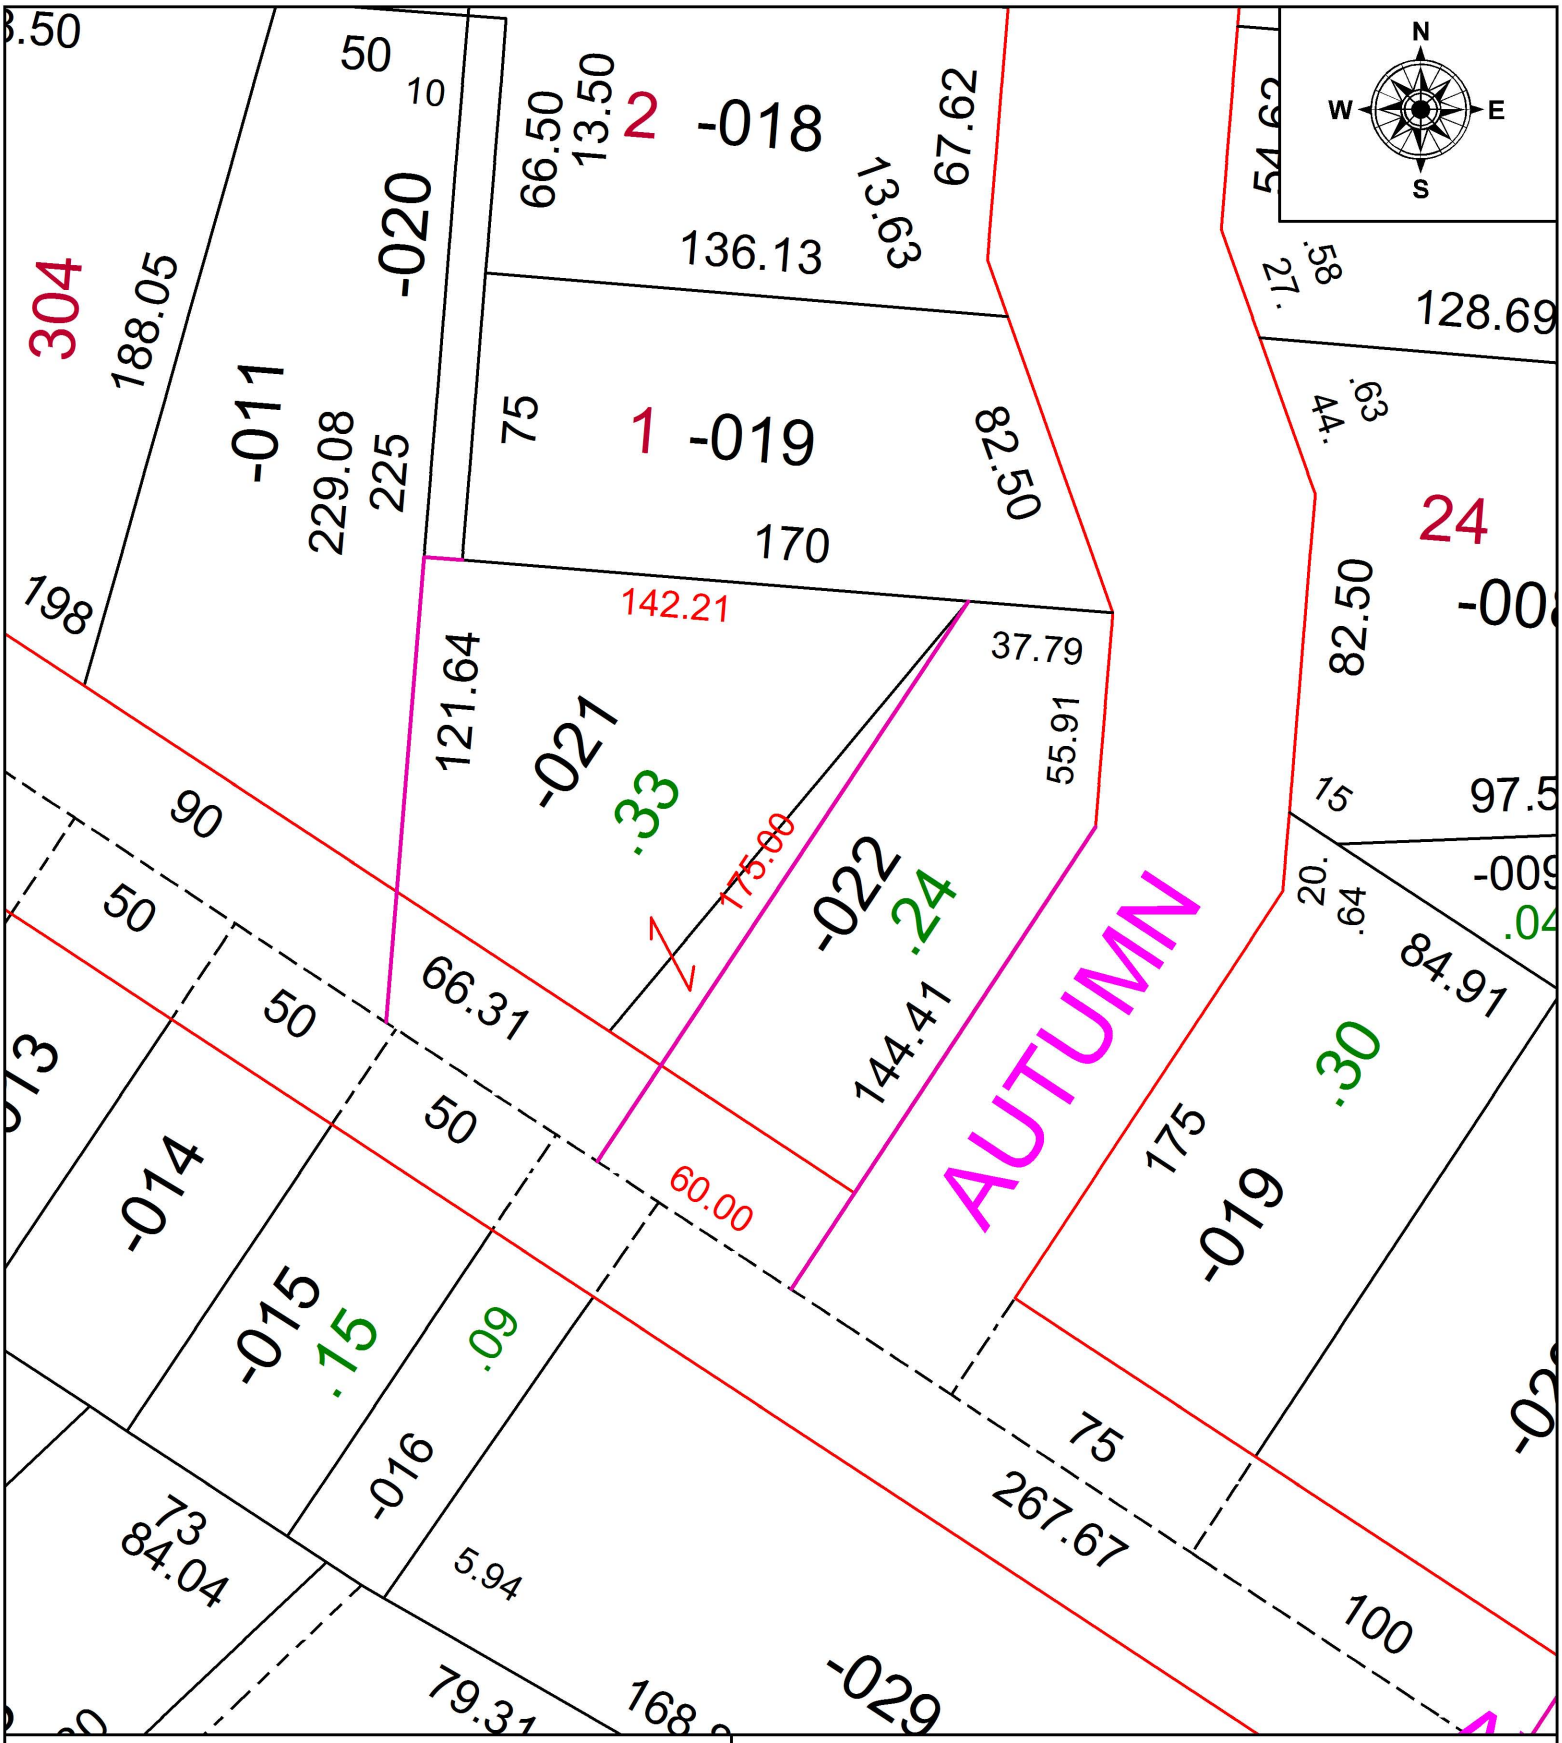

SPLITS/DEEDS PROCESSED
LORAIN COUNTY TAX MAP DEPARTMENT
226 MIDDLE AVE. ELYRIA, OH

SURVEYED BY: T.W. LAUNDON
CLOSURE: 1: 33,000
MAP PAGE(S): 05-00-036
APPOVED BY: TJS **DATE:** 2/7/17
SCALE: 1" = 200 **PRIOR INSTRUMENT:** 20060155666