PARENT PARCEL: 04-00-015-110-038, -277
CHILD PARCEL: 04-00-015-110-282, -283
STARTING POINT: INTERSECTION OF ORIGINAL C/L OF S.R. 254 AND C/L OF CENTER RD.

16-03607

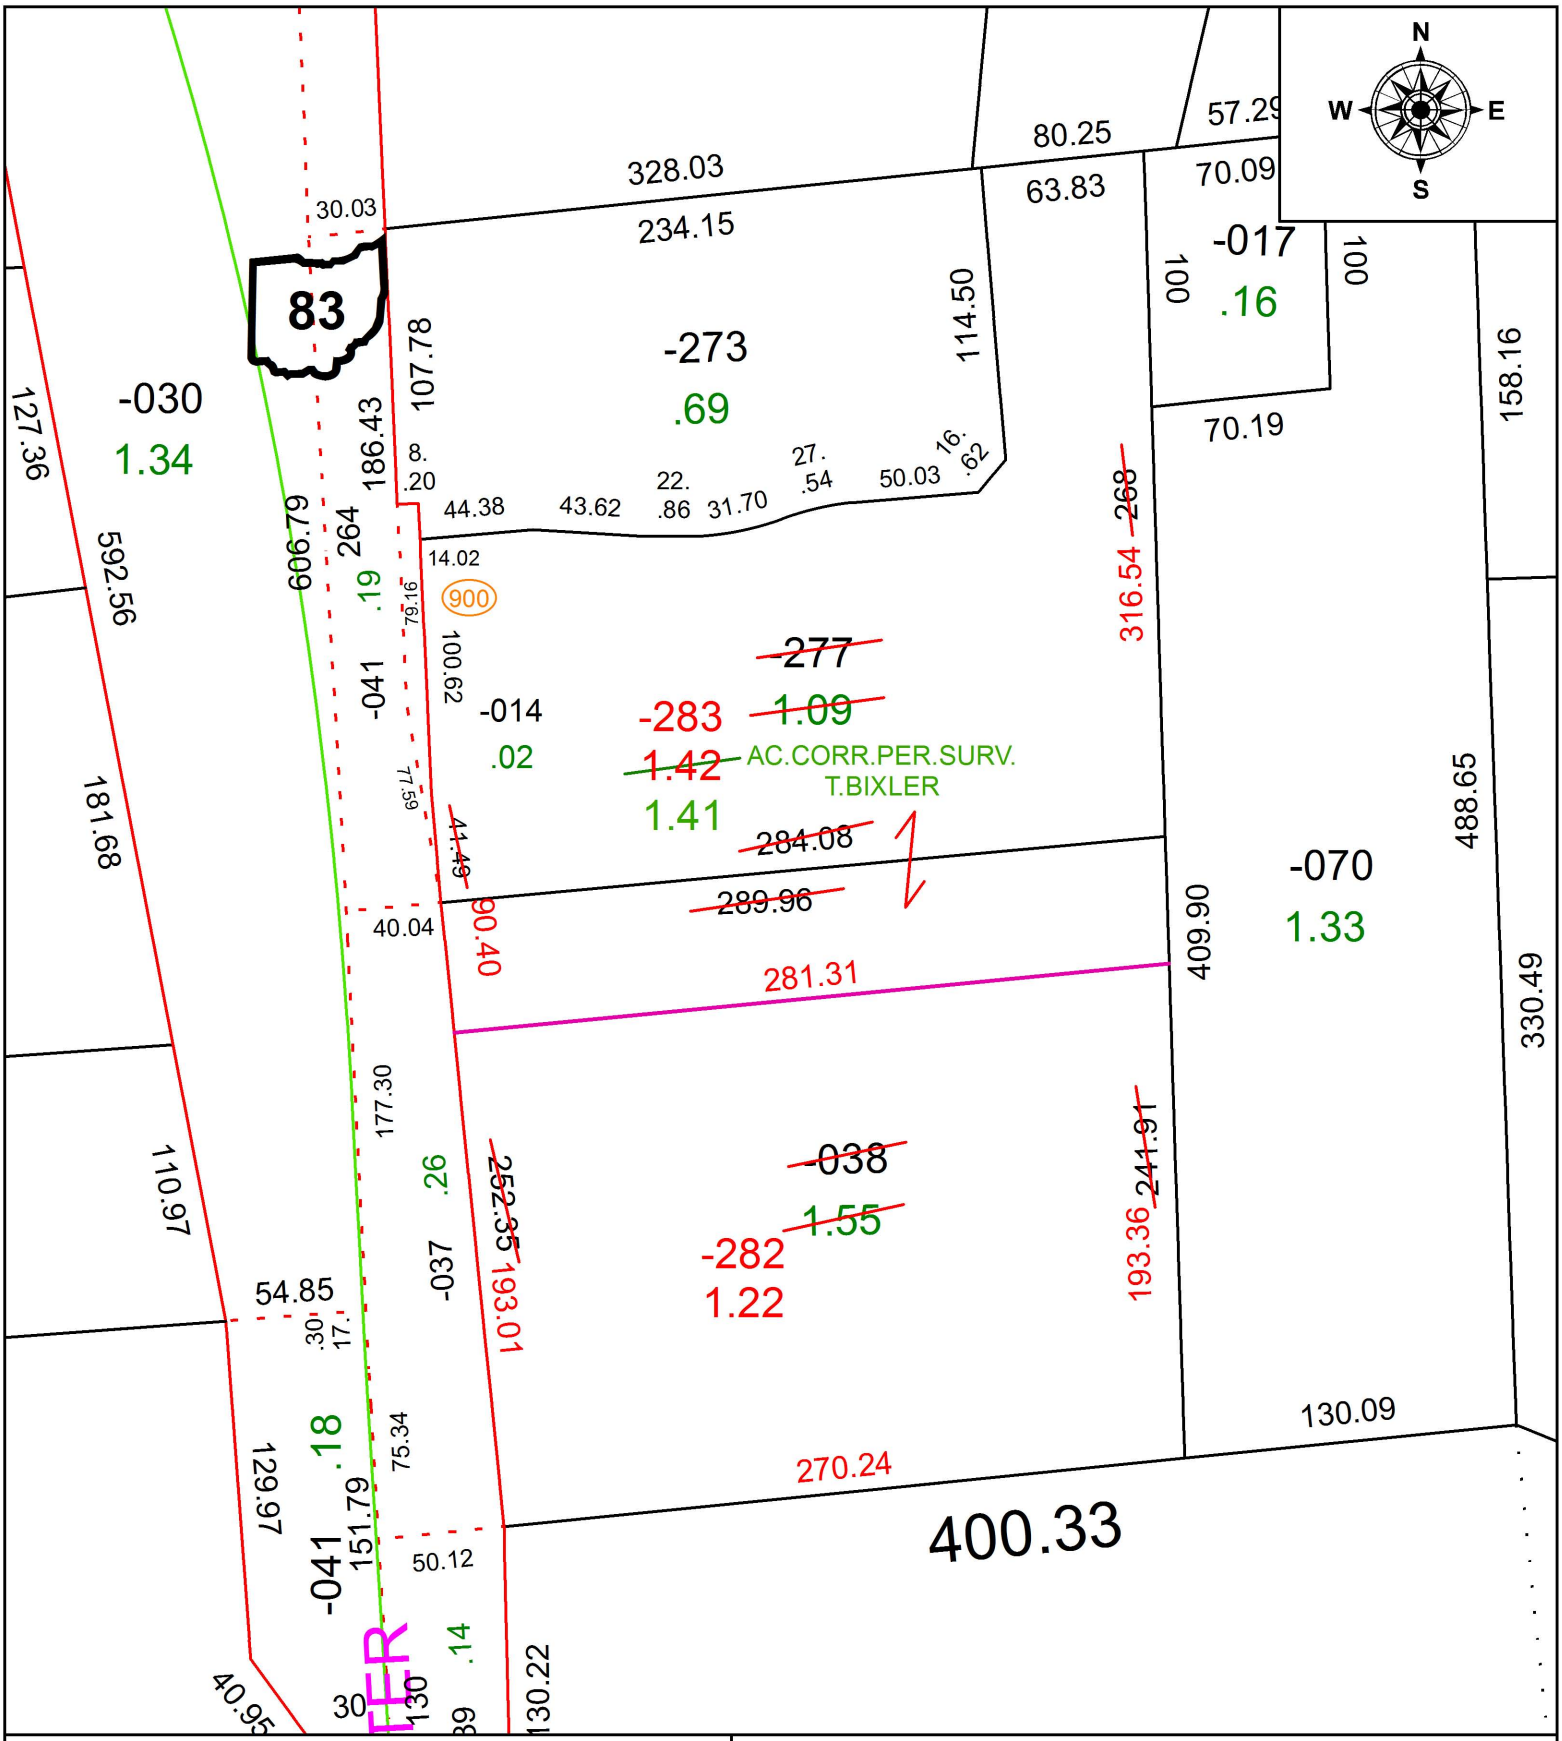

SPLITS/DEEDS PROCESSED
LORAIN COUNTY TAX MAP DEPARTMENT
226 MIDDLE AVE. ELYRIA, OH

SURVEYED BY: TREVOR A. BIXLER
CLOSURE: 1: 96,614
MAP PAGE(S): 4-00-015
APPOVED BY: RRM **DATE:** 12-2-16
SCALE: 1" = 75 **PRIOR INSTRUMENT:** 20120399472