PARENT PARCEL: 03-00-103-108-011, -015, -016

CHILD PARCEL: 03-00-103-108-026

STARTING POINT: INTERSECTION OF SOUTH LINE OF 36TH ST AND WEST LINE OF ELYRIA AVE

17-03608-D

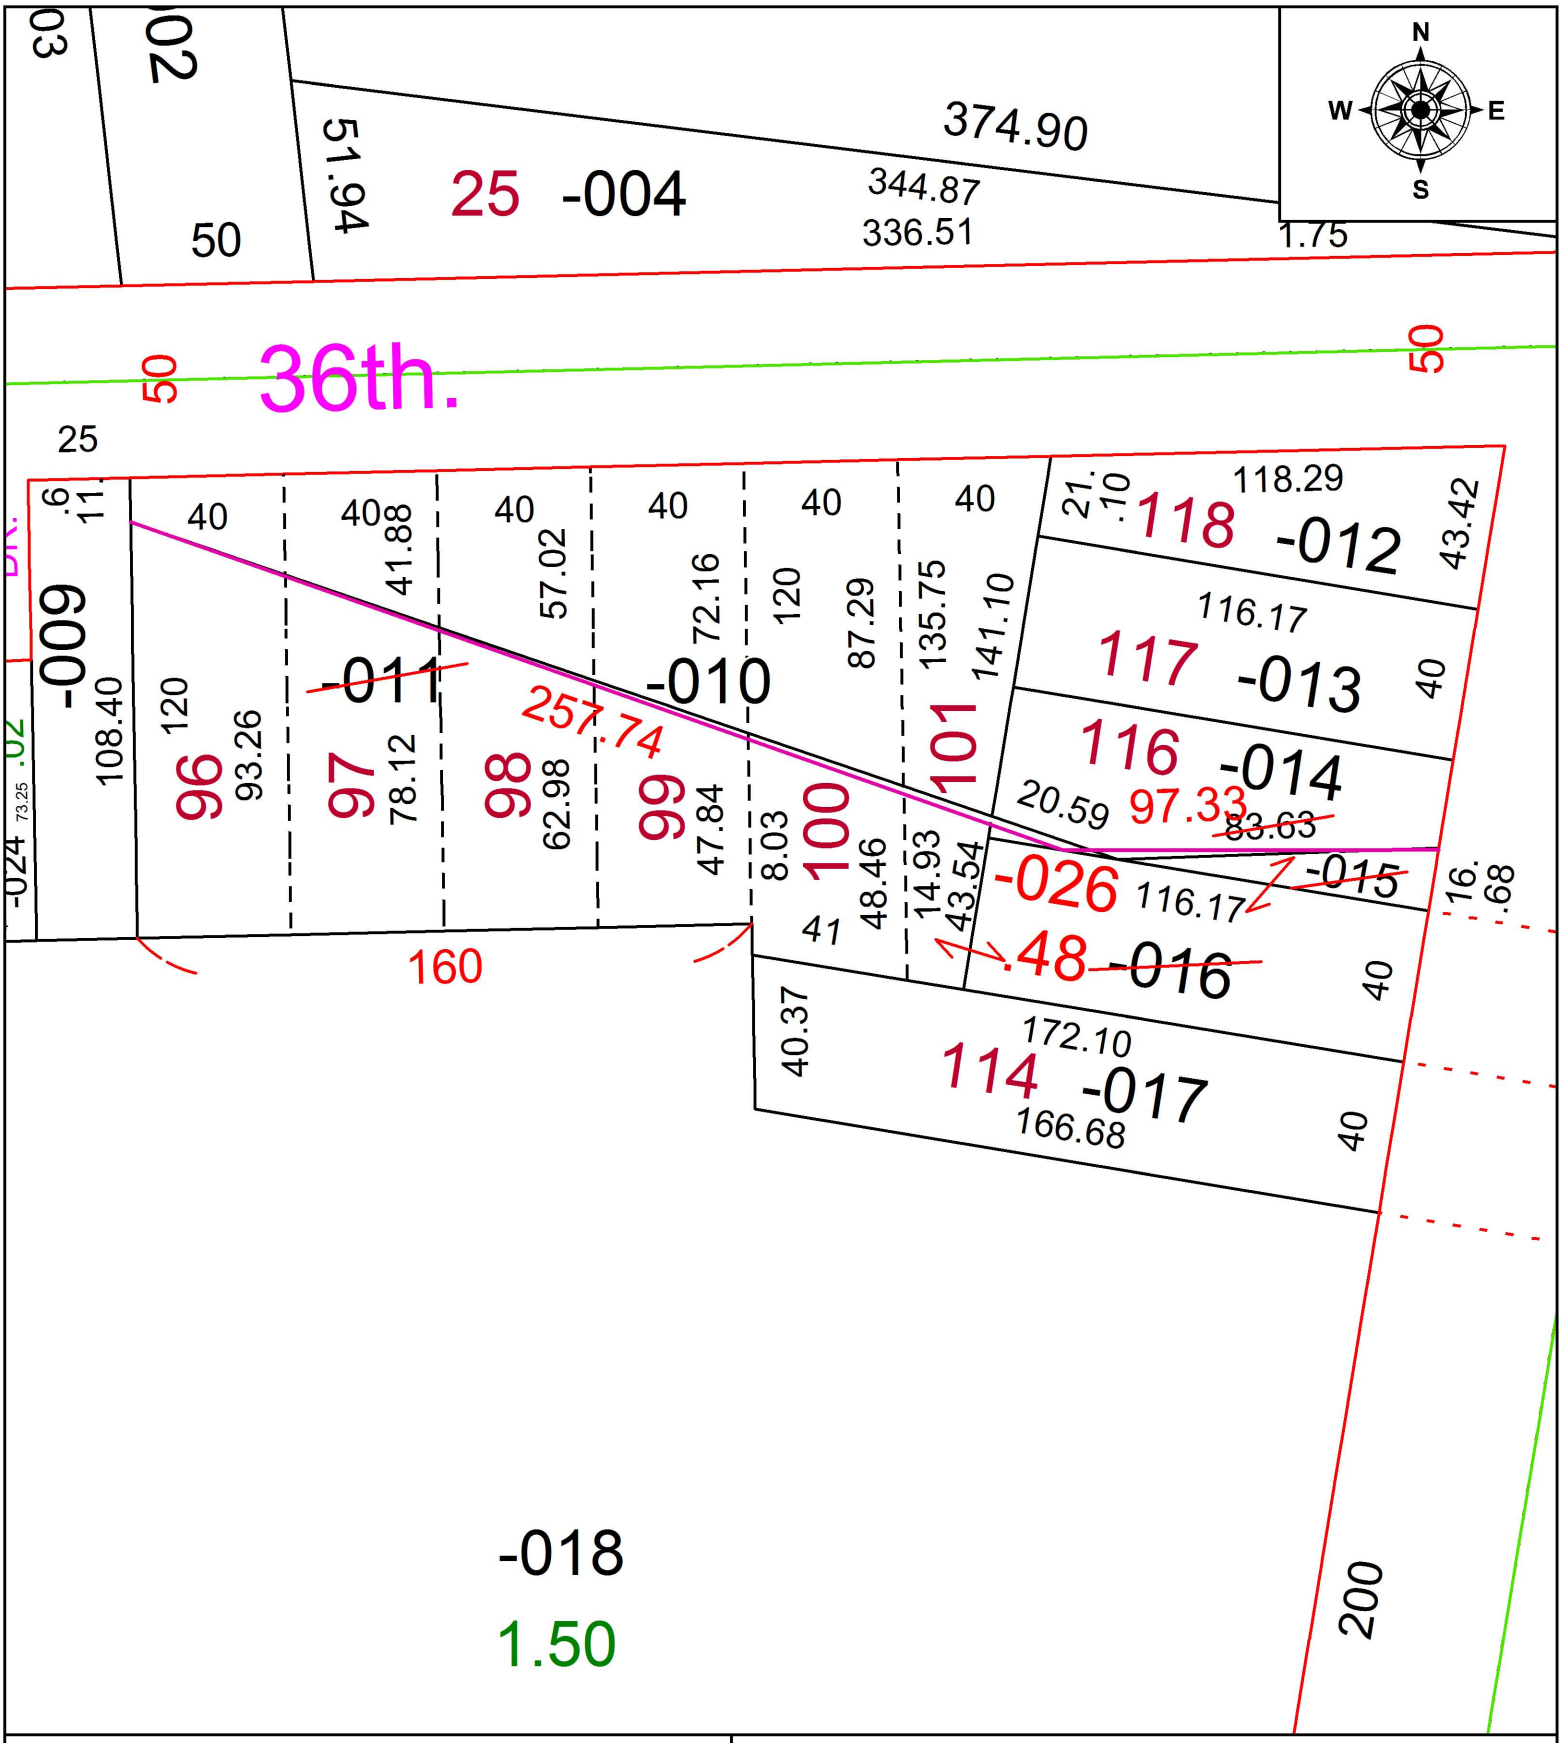

SPLITS/DEEDS PROCESSED

LORAIN COUNTY TAX MAP DEPARTMENT
226 MIDDLE AVE. ELYRIA, OH

SURVEYED BY: WILLIAM R. WALLACE
CLOSURE: 1: 142,843
MAP PAGE(S): 3-00-103
APPOVED BY: RRM **DATE:** 2-13-17
SCALE: 1" = 50 **PRIOR INSTRUMENT:** 20160545654