PARENT PARCEL: 13-11-021-000-028, 13-20-022-000-028

CHILD PARCEL: 13-11-021-000-029, -030, 13-20-022-000-030 THRU -035

STARTING POINT: INTERSECTION OF C/L OF S.R. 20 AND C/L OF GREEN RD.

16-03608

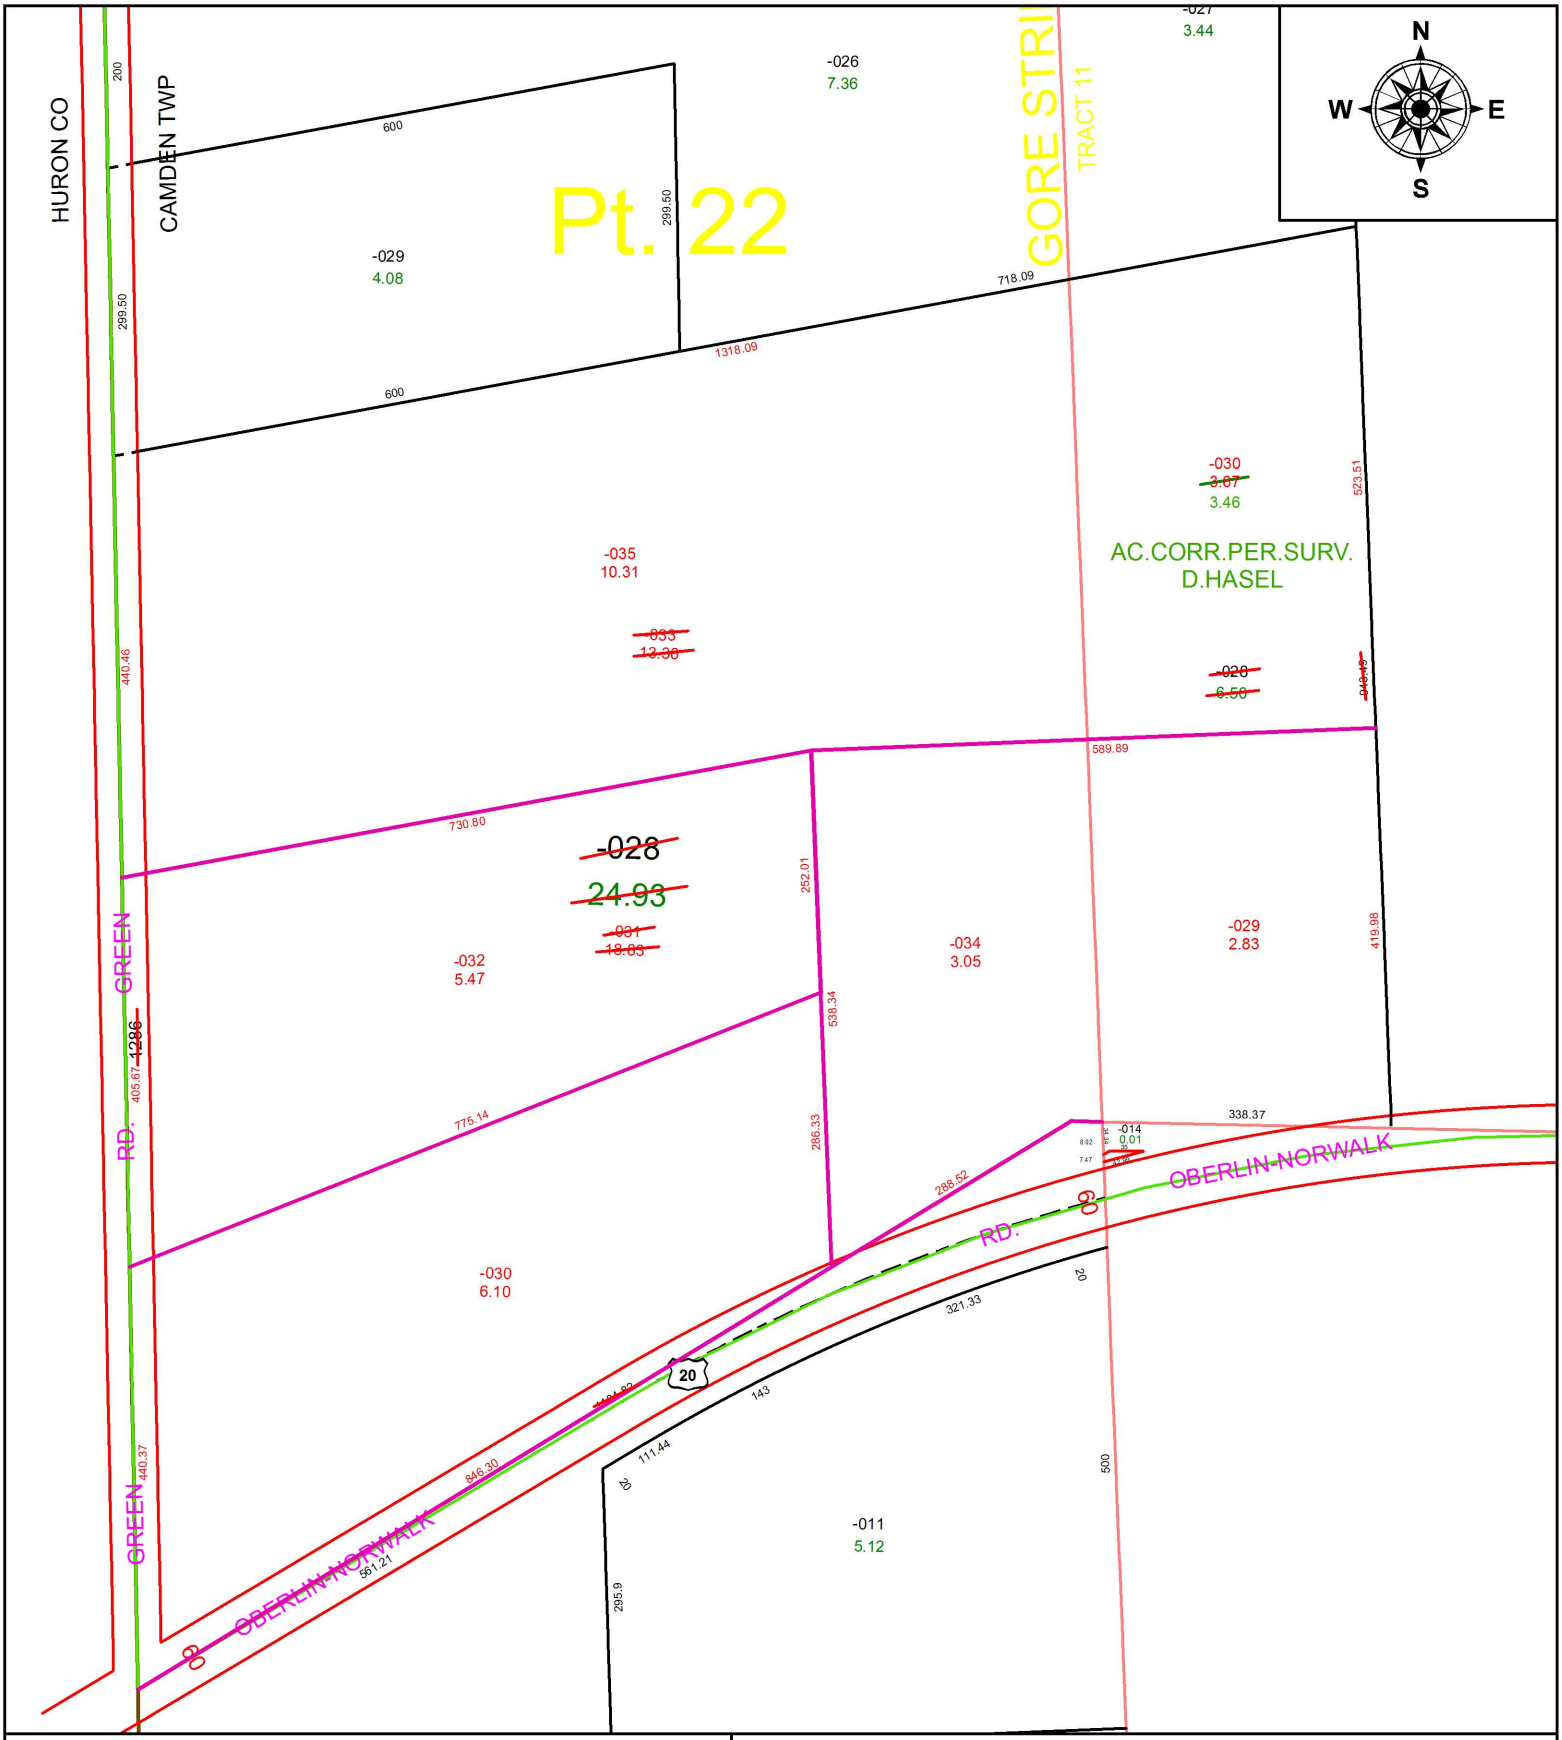

SPLITS/DEEDS PROCESSED

LORAIN COUNTY TAX MAP DEPARTMENT
226 MIDDLE AVE. ELYRIA, OH

SURVEYED BY: DOUGLAS A. HASEL
CLOSURE: 1: 296,462
MAP PAGE(S): 13-A
APPOVED BY: RRM **DATE:** 12-5-16
SCALE: 1" = 200 **PRIOR INSTRUMENT:** 20130461723