PARENT PARCEL: 09-00-004-101-038

CHILD PARCEL: 09-00-004-101-058, -059

STARTING POINT: INTERSECTION OF C/L OF ANNIS RD. AND NORTH LINE OF O.L.4

16-03610

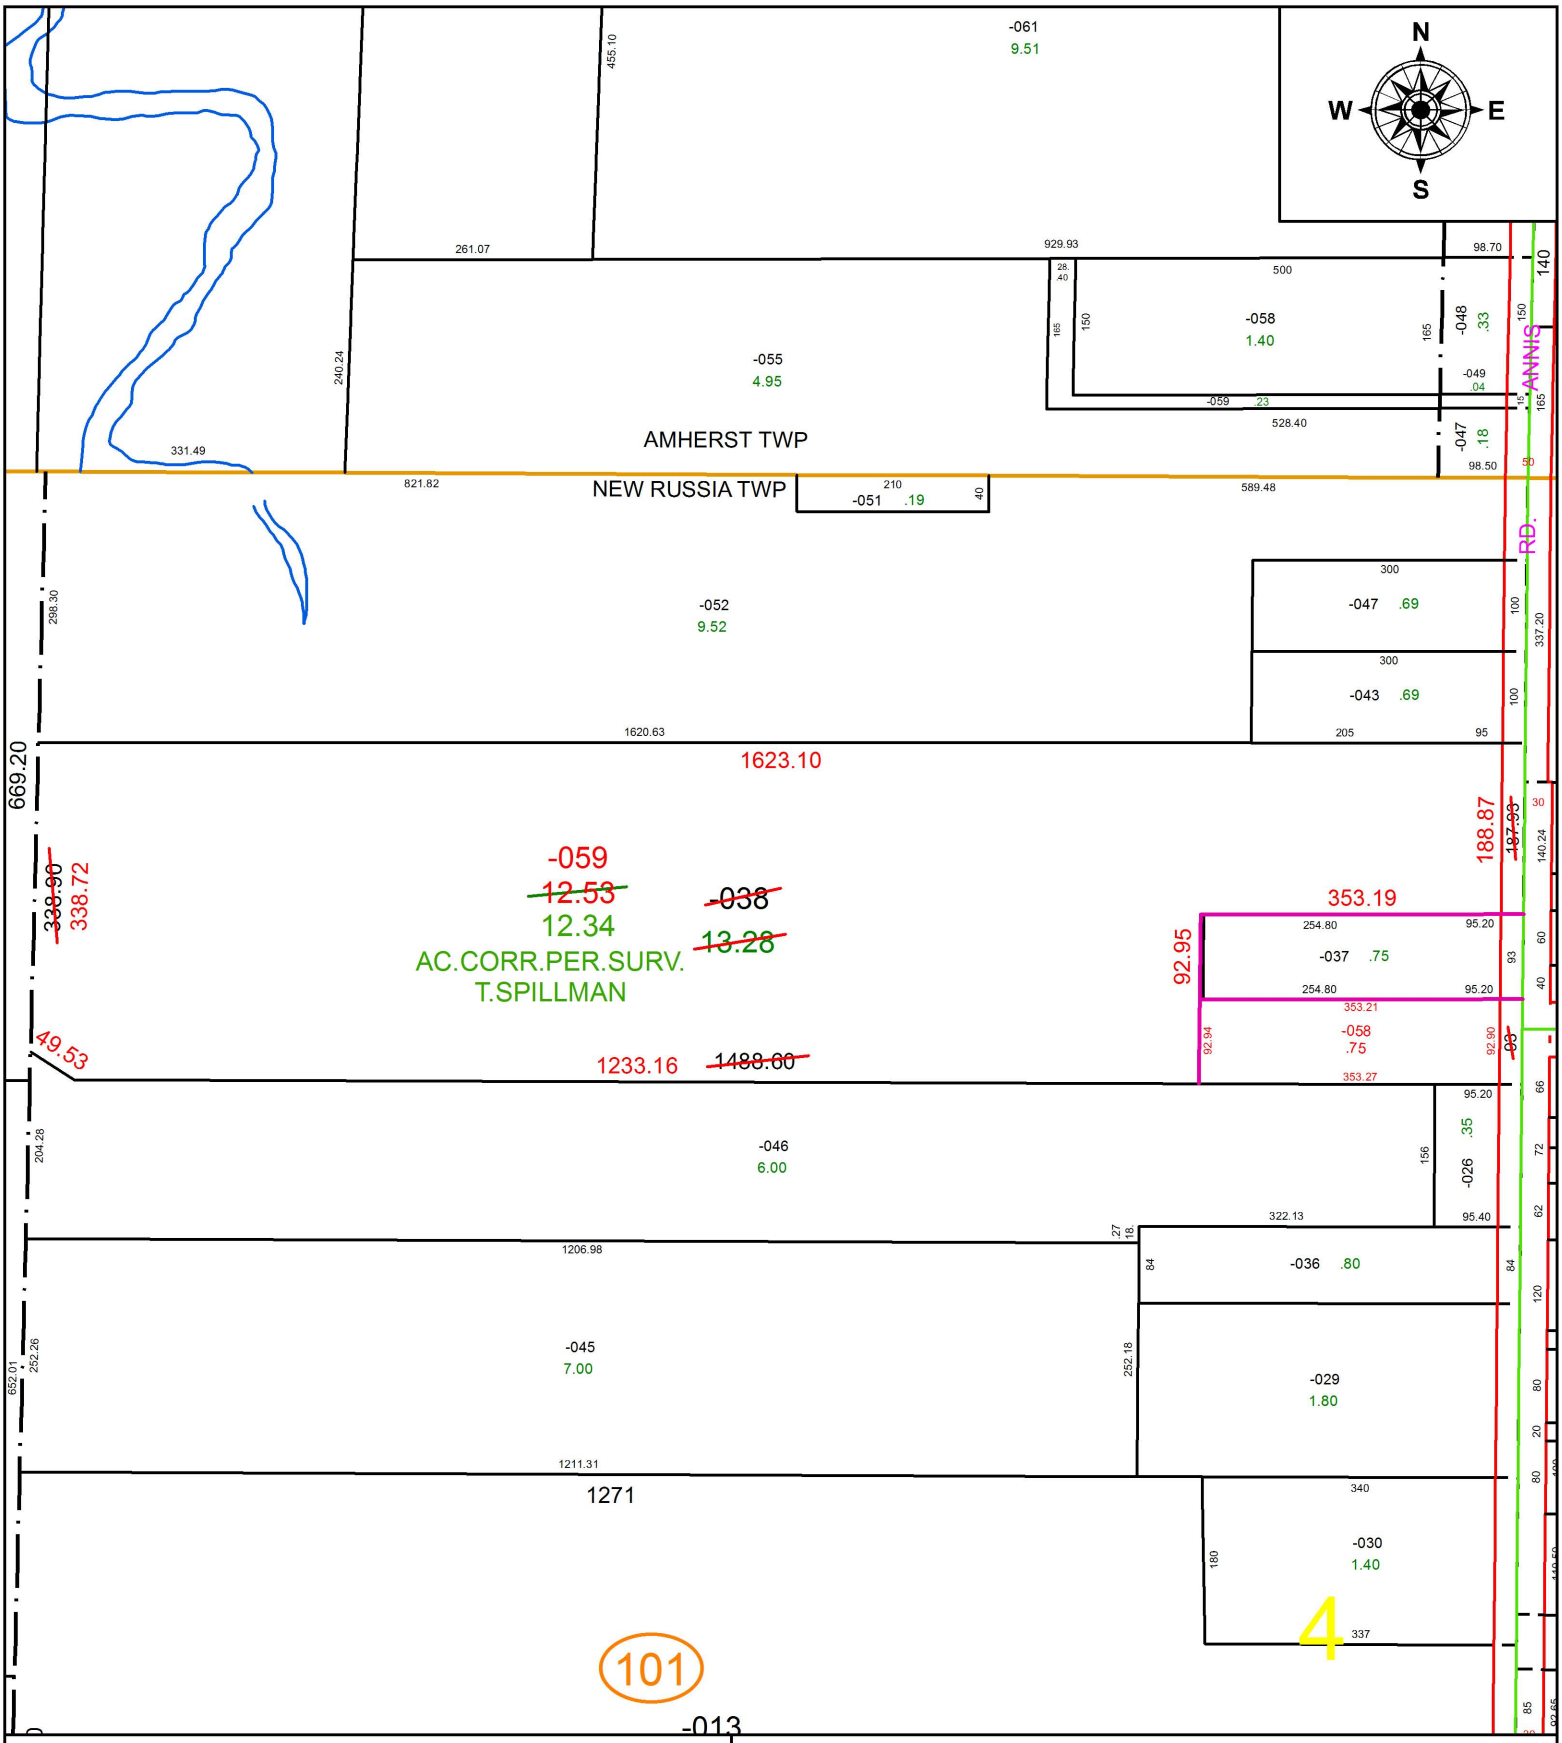

SPLITS/DEEDS PROCESSED

LORAIN COUNTY TAX MAP DEPARTMENT
226 MIDDLE AVE. ELYRIA, OH

SURVEYED BY: THEODORE J. SPILLMAN

CLOSURE: 1: 1,221,680

MAP PAGE(S): 9-00-004

APPOVED BY: RRM **DATE:** 12-7-16

SCALE: 1" = 210 **PRIOR INSTRUMENT:** 20070203919