PARENT PARCEL: 06-26-005-000-001
CHILD PARCEL: XX-XX-XXX-XXX-XXX
STARTING POINT: INTERSECTION OF WEST LINE OF EAST AVE AND NORTH LINE OF O.L.6

17-03611-D

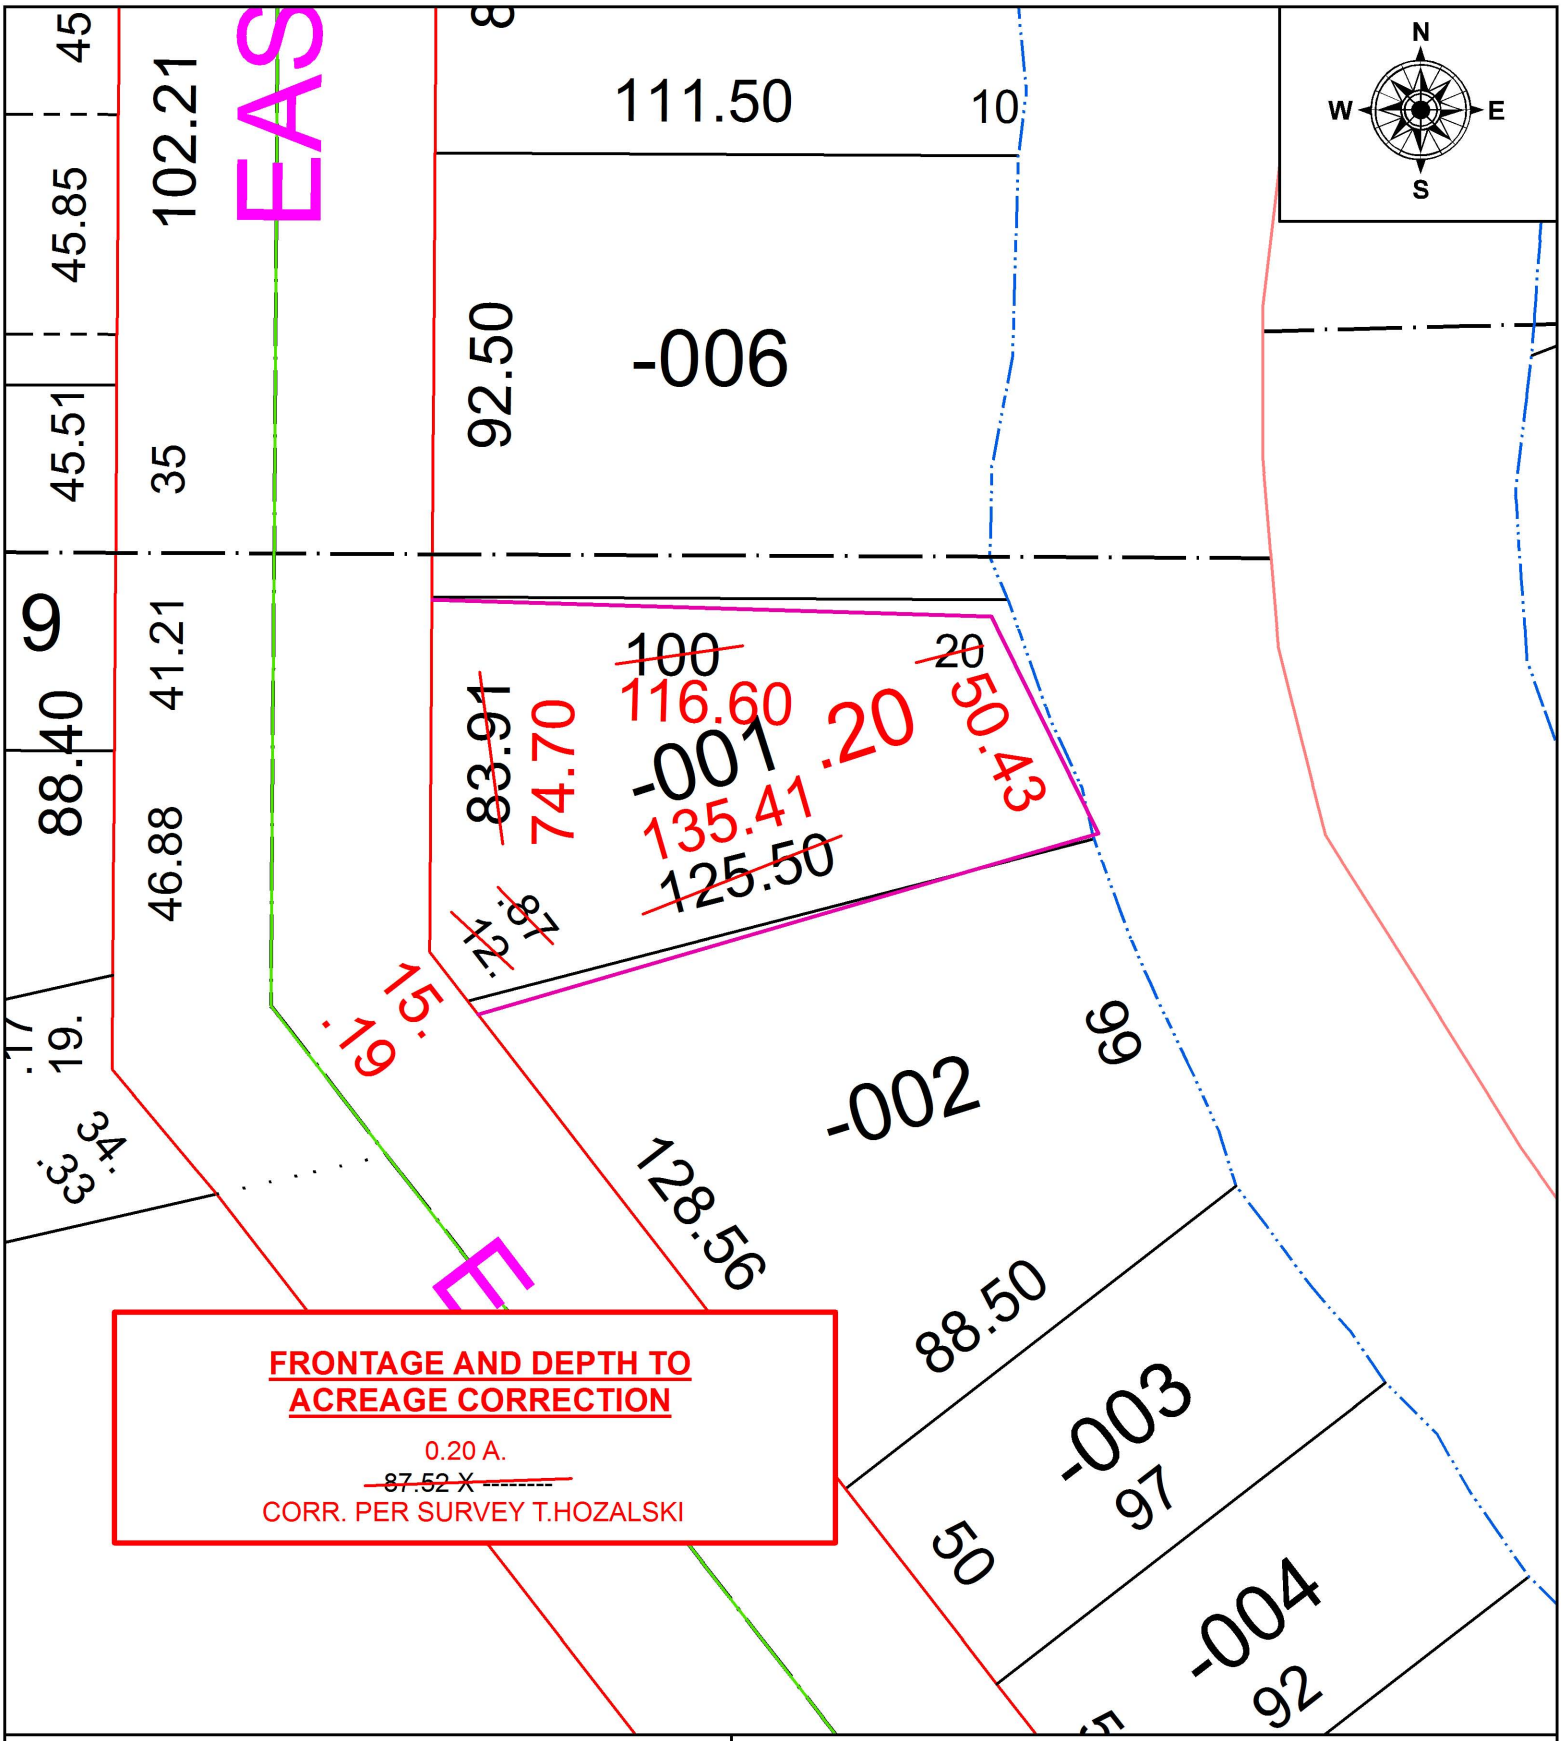

SPLITS/DEEDS PROCESSED
LORAIN COUNTY TAX MAP DEPARTMENT
226 MIDDLE AVE. ELYRIA, OH

SURVEYED BY: TIMOTHY D. HOZALSKI
CLOSURE: 1: 81,057
MAP PAGE(S): 6-138
APPOVED BY: RRM **DATE:** 2-15-17
SCALE: 1" = 40 **PRIOR INSTRUMENT:** 20150570265