PARENT PARCEL: 03-00-083-101-044

CHILD PARCEL: 03-00-083-101-046 & -047

STARTING POINT: I.P. MON. BOX, CL OF E. 28TH ST. & CL OF GROVE AVE.

16-03614

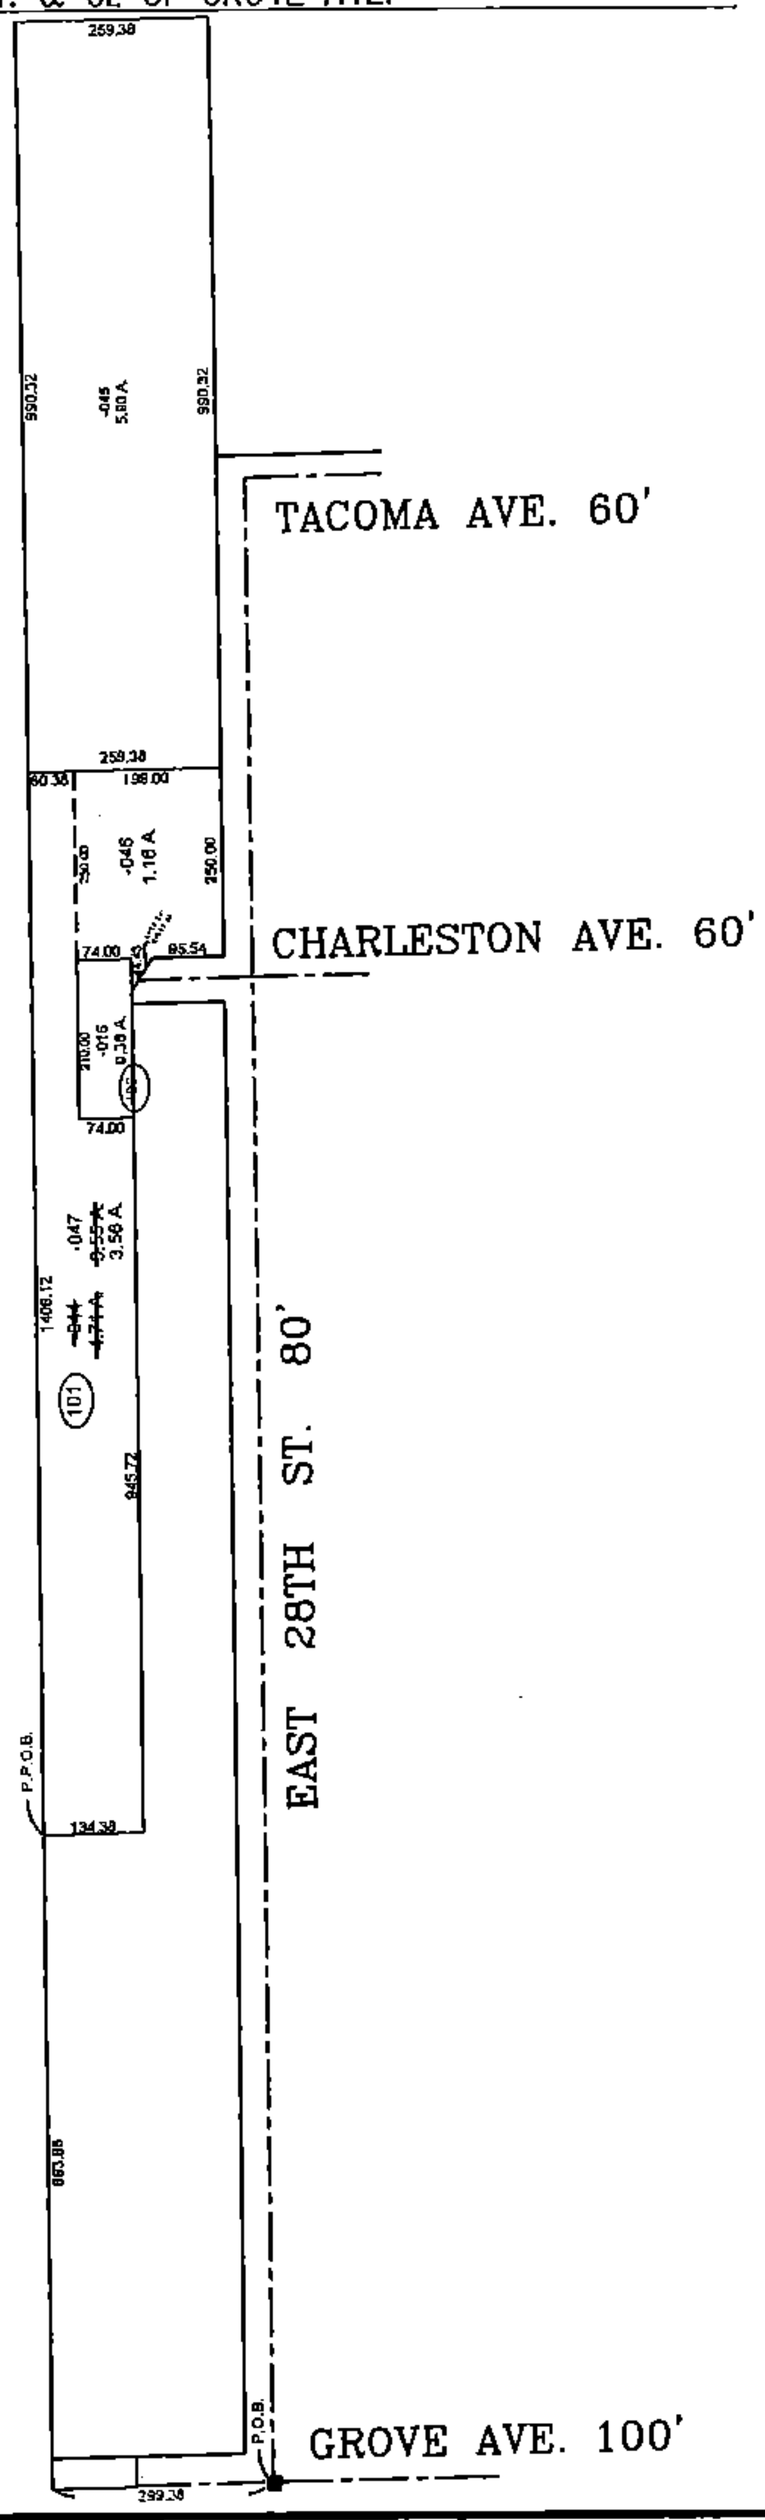

SPLITS/DEEDS PROCESSED

LORAIN COUNTY TAX MAP DEPARTMENT
226 MIDDLE AVE. ELYRIA, OHIO

SURVEYED BY: PETER ZWICK

CLOSURE: 0.01 : 10,000

MAP PAGE(S): 03-00-083

APPROVED BY: TJS DATE: 12/16/16

SCALE: 1"= 400 PRIOR INSTRUMENT: 2015-0559659