PARENT PARCEL: 13-09-001-000-004 , 13-09-018-000-001, & 13-10-032-000-002

CHILD PARCEL: 13-09-001-000-005 & -006

STARTING POINT: MAG. NAIL SET, CL OF GORE ORPHANAGE RD. (RUN SOUTH)& CL OF S.R. 303, ALSO, MAG. NAIL FD. CL OF GORE & CL OF S.R. 303 (RUN NORTH)

16-03616

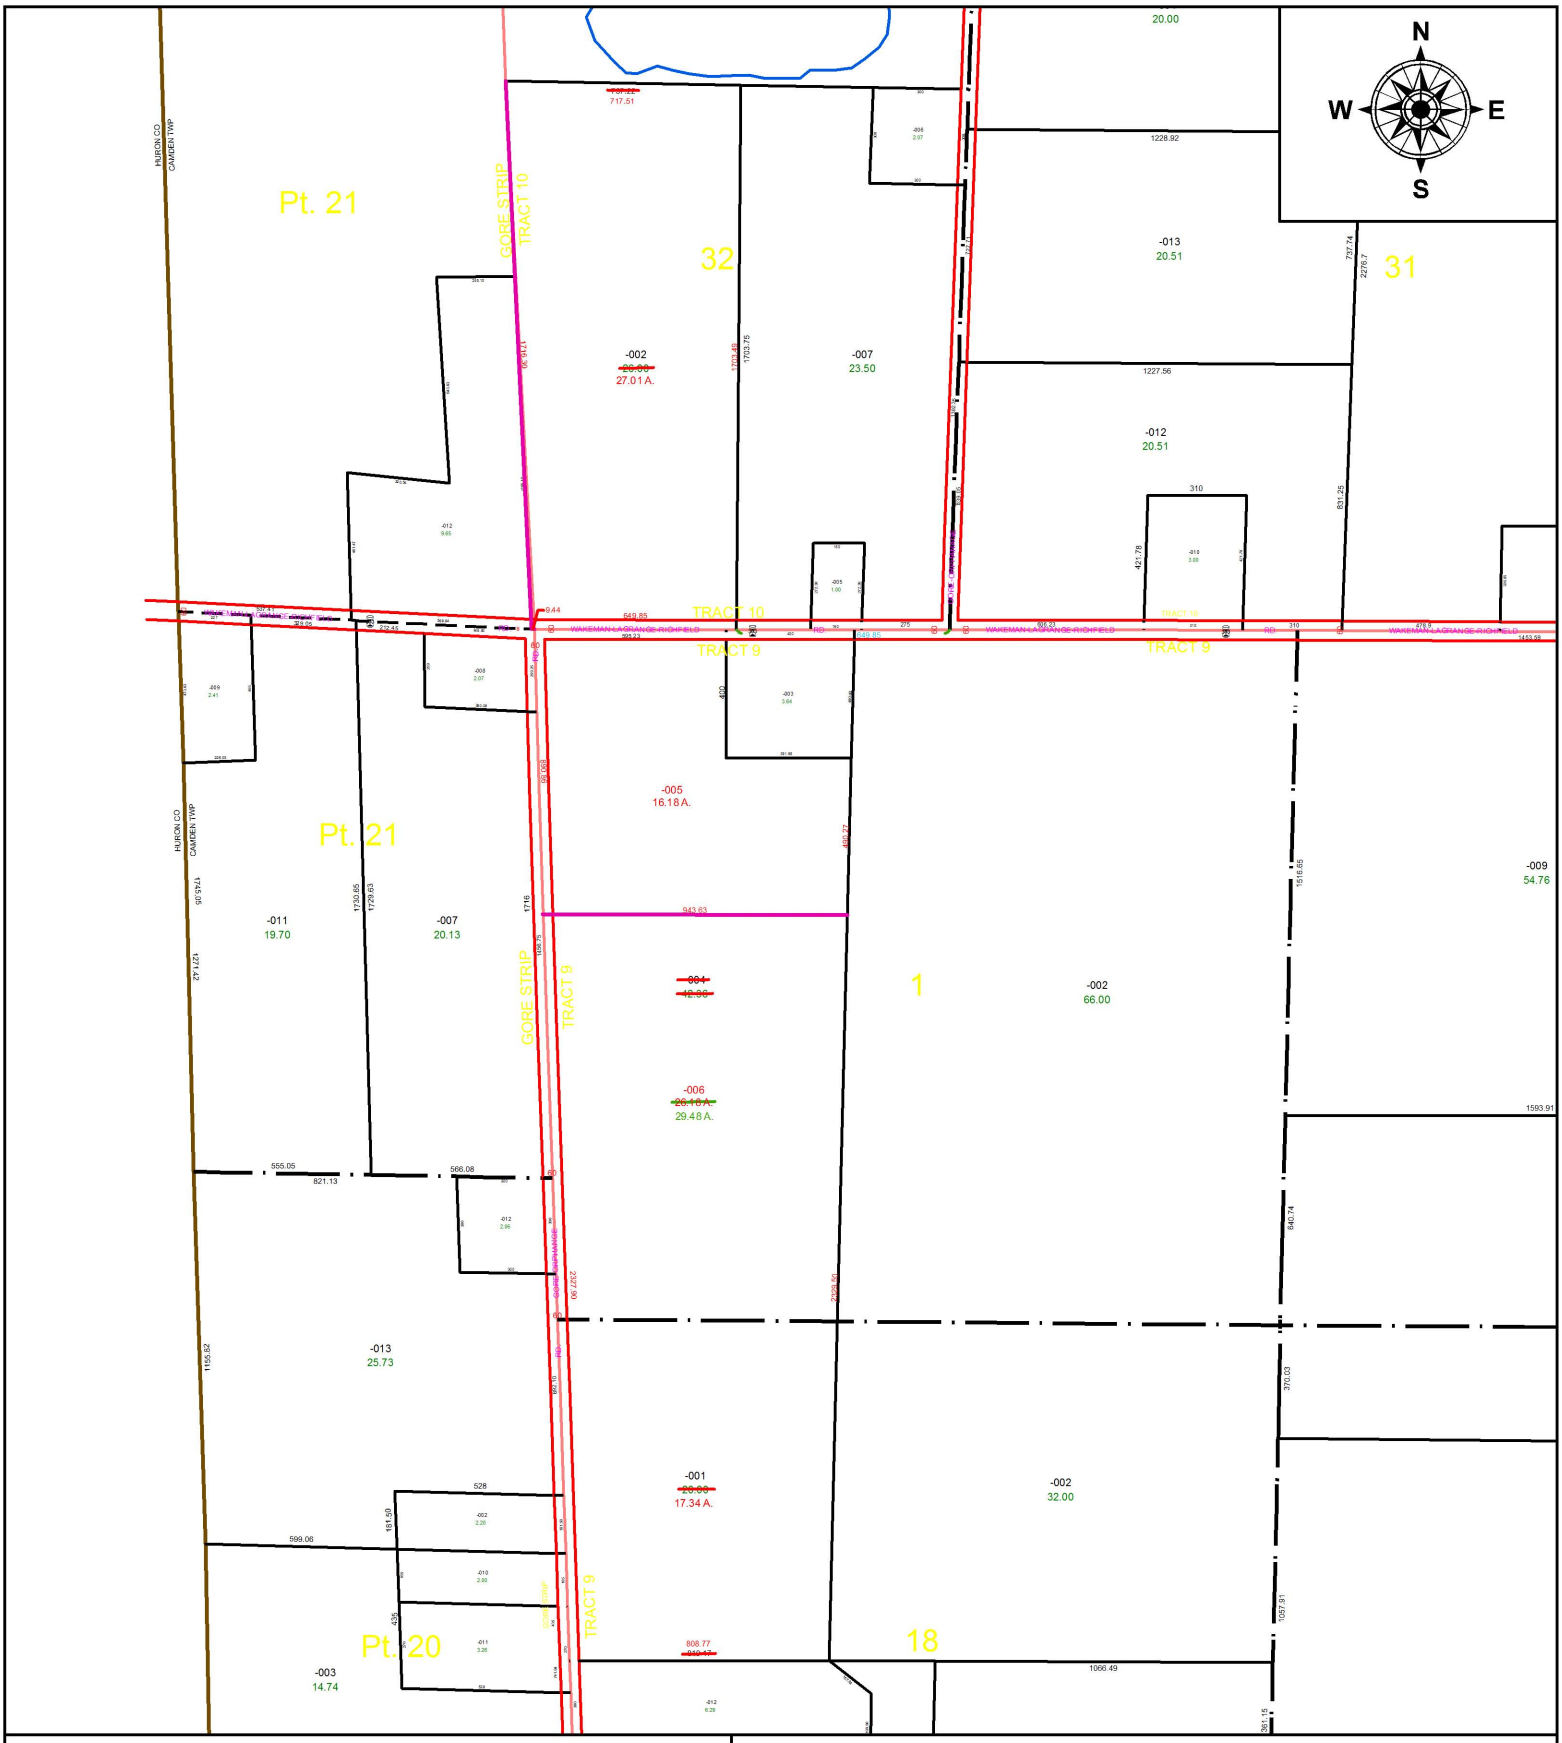

SPLITS/DEEDS PROCESSED

LORAIN COUNTY TAX MAP DEPARTMENT
226 MIDDLE AVE. ELYRIA, OH

SURVEYED BY: ADAM E. WEAVER
CLOSURE: 1: 33,000
MAP PAGE(S): 12-00-033
APPOVED BY: TJS **DATE:** 12/20/16
SCALE: 1" = 600 **PRIOR INSTRUMENT:** 2016-0574281