PARENT PARCEL: 05-00-040-106-128
CHILD PARCEL: XX-XX-XXX-XXX-XXX
STARTING POINT: INTERSECTION OF C/L OF LEAVITT RD. AND C/L OF COOPER FOSTER PARK RD.

17-03619-D

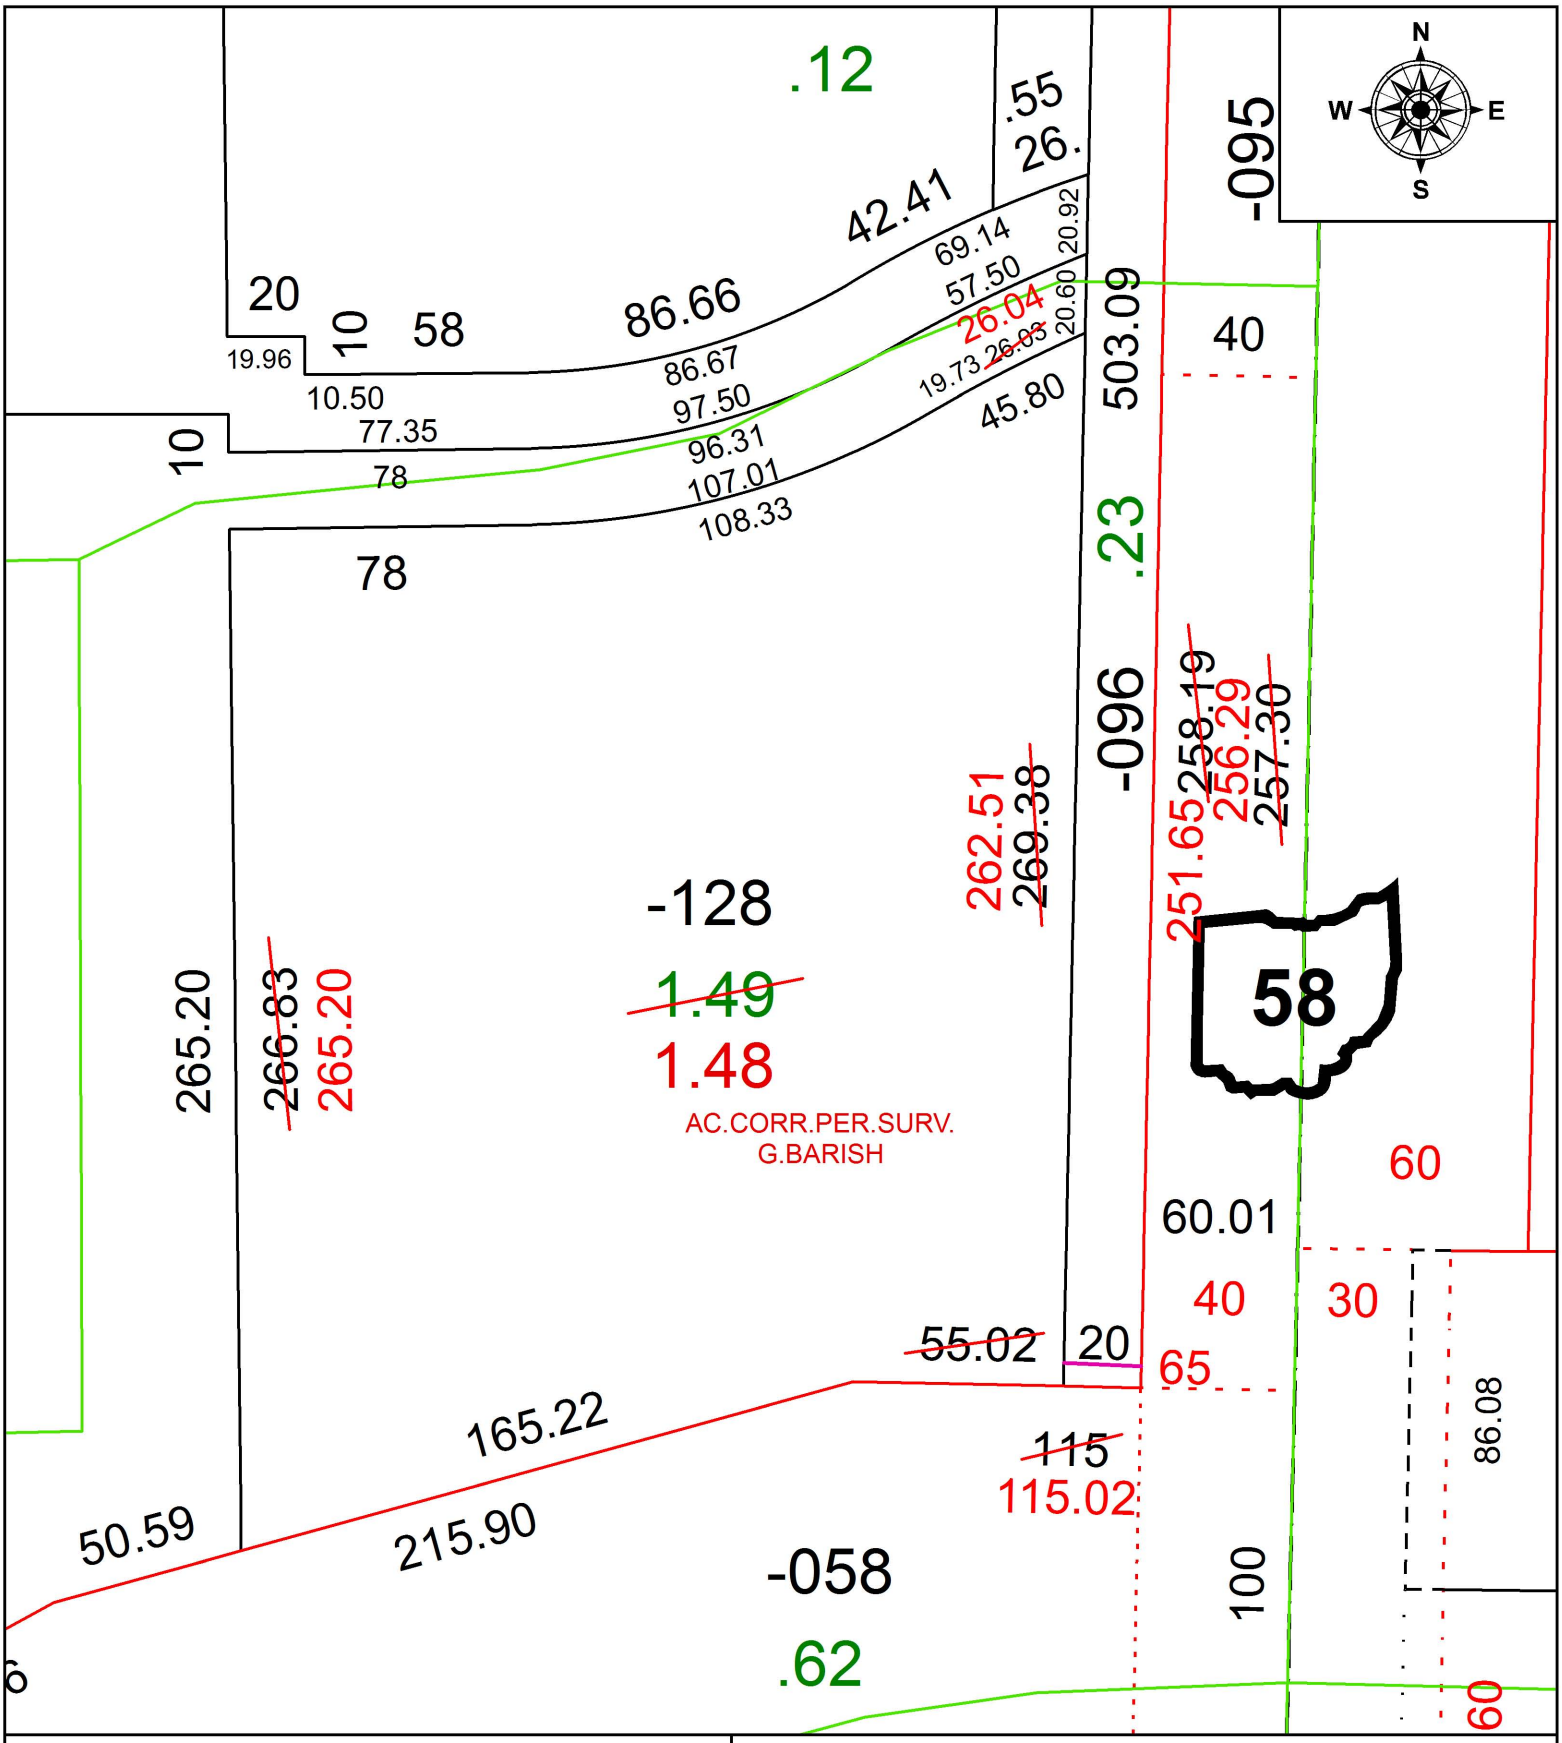

SPLITS/DEEDS PROCESSED
LORAIN COUNTY TAX MAP DEPARTMENT
226 MIDDLE AVE. ELYRIA, OH

SURVEYED BY: GILBERT M. BARISH
CLOSURE: 1: 416,695
MAP PAGE(S): 5-00-040
APPOVED BY: RRM **DATE:** 2-27-17
SCALE: 1" = 50 **PRIOR INSTRUMENT:** DV 1416/646