PARENT PARCEL: 03-00-043-101-007 & -008
CHILD PARCEL: 03-00-043-101-017, -018, & -019
STARTING POINT: I.P. FOUND, N.E. CORNER OF S/L 100 IN COLONIAL GARDENS ALLOTMENT P.V. 14 PG. 17

16-03619

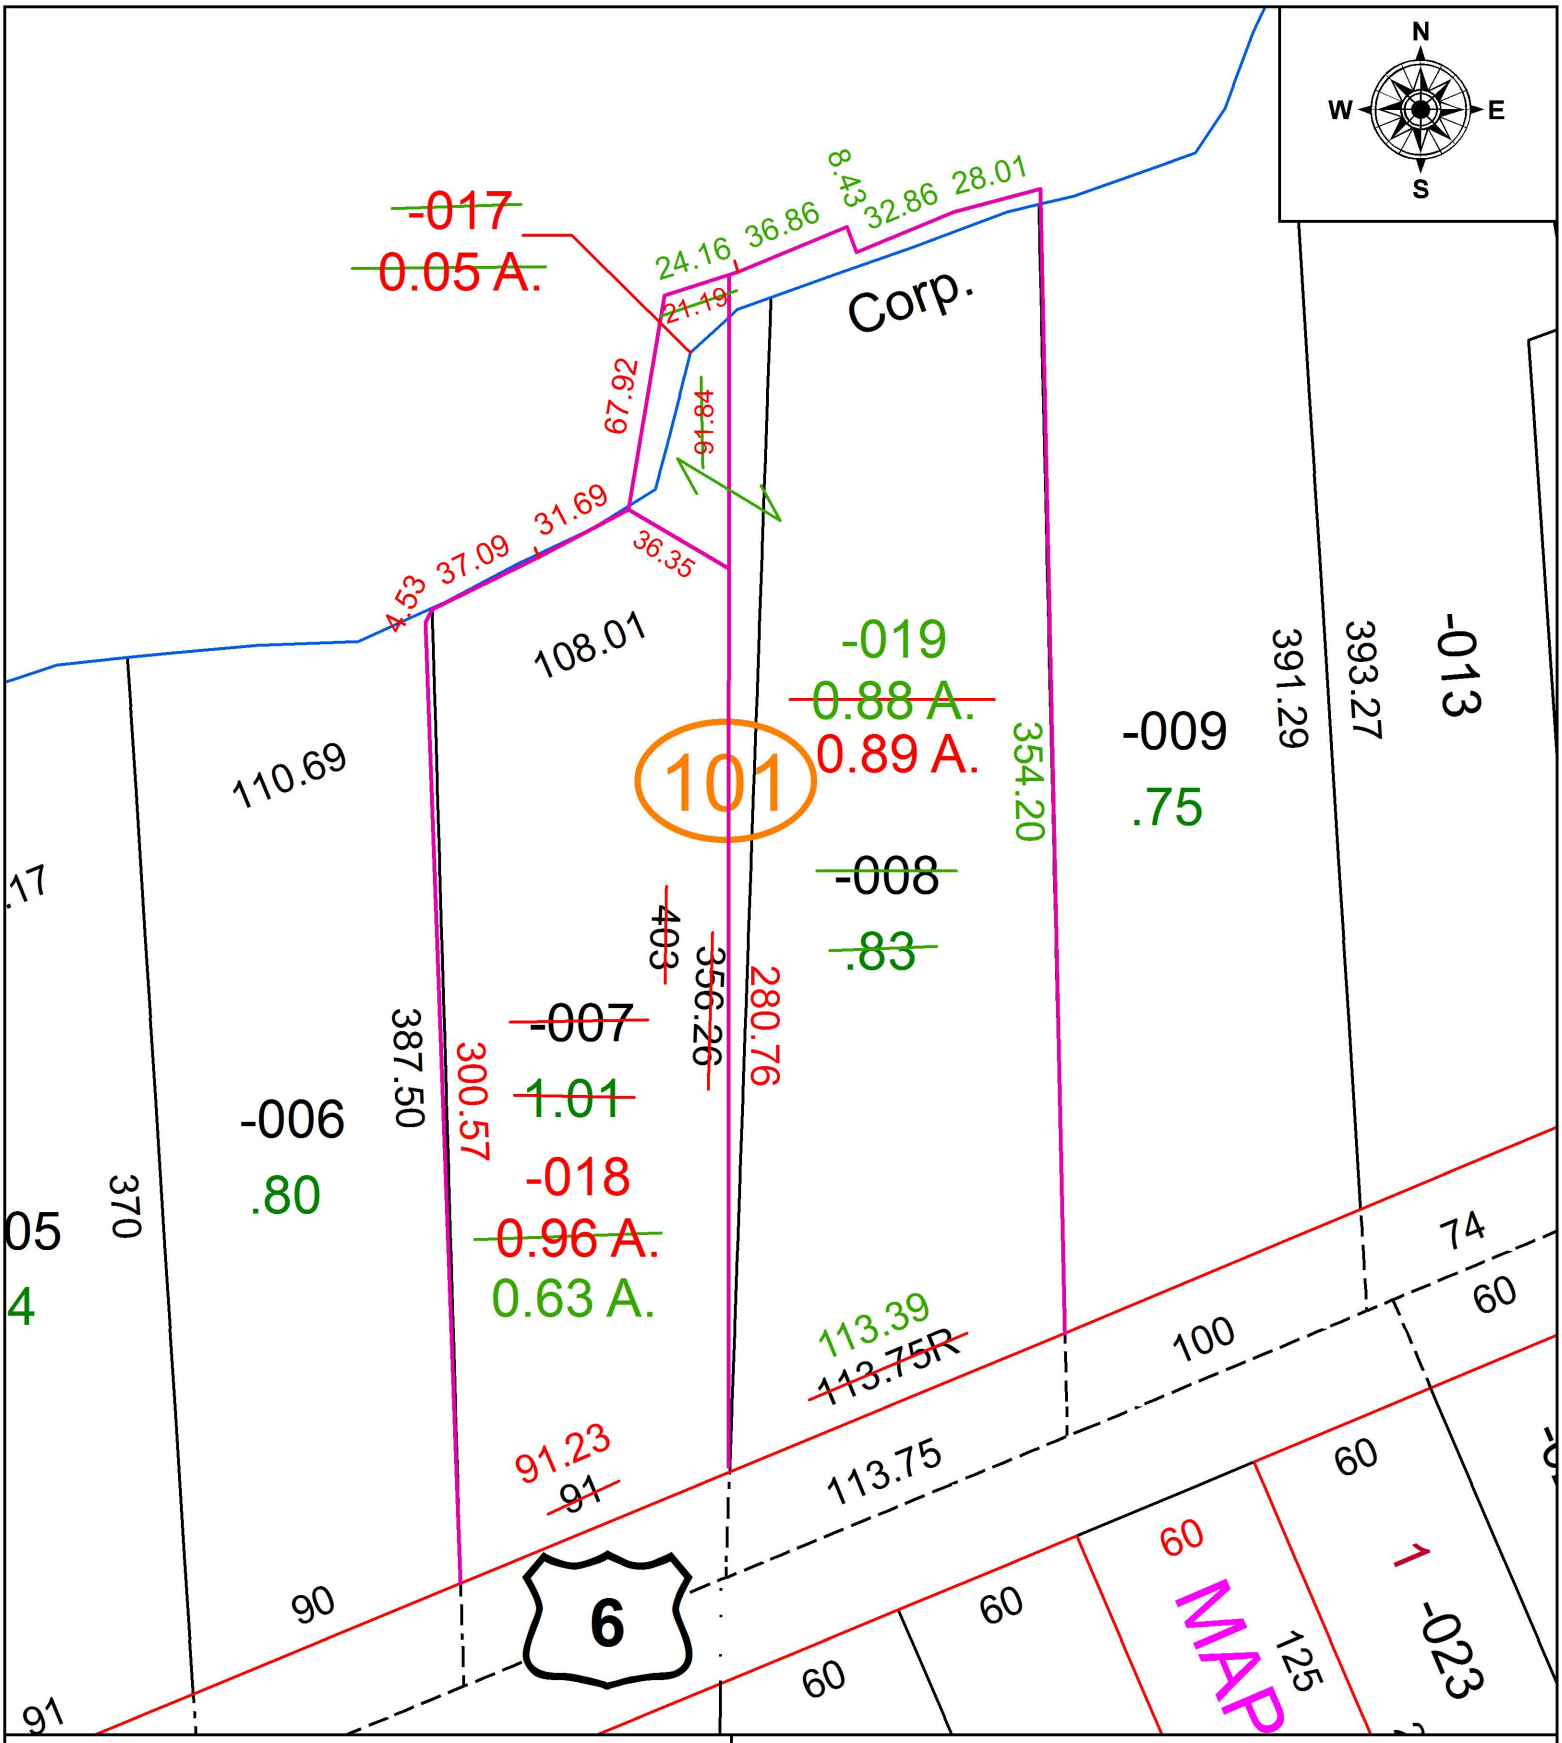

SPLITS/DEEDS PROCESSED
LORAIN COUNTY TAX MAP DEPARTMENT
226 MIDDLE AVE. ELYRIA, OH

SURVEYED BY: RICHARD A. CARPENTER
CLOSURE: 1: 84,000
MAP PAGE(S): 03-00-043
APPOVED BY: TJS **DATE:** 12/16/16
SCALE: 1" = 60 **PRIOR INSTRUMENT:** 2010-0326807