PARENT PARCEL: 11-00-020-000-004

CHILD PARCEL: 11-00-020-000-031 & -032

STARTING POINT: I.P. MON. BOX FOUND, CL OF COWLEY RD. & N.E. CORNER OF O.L. 20

16-03620

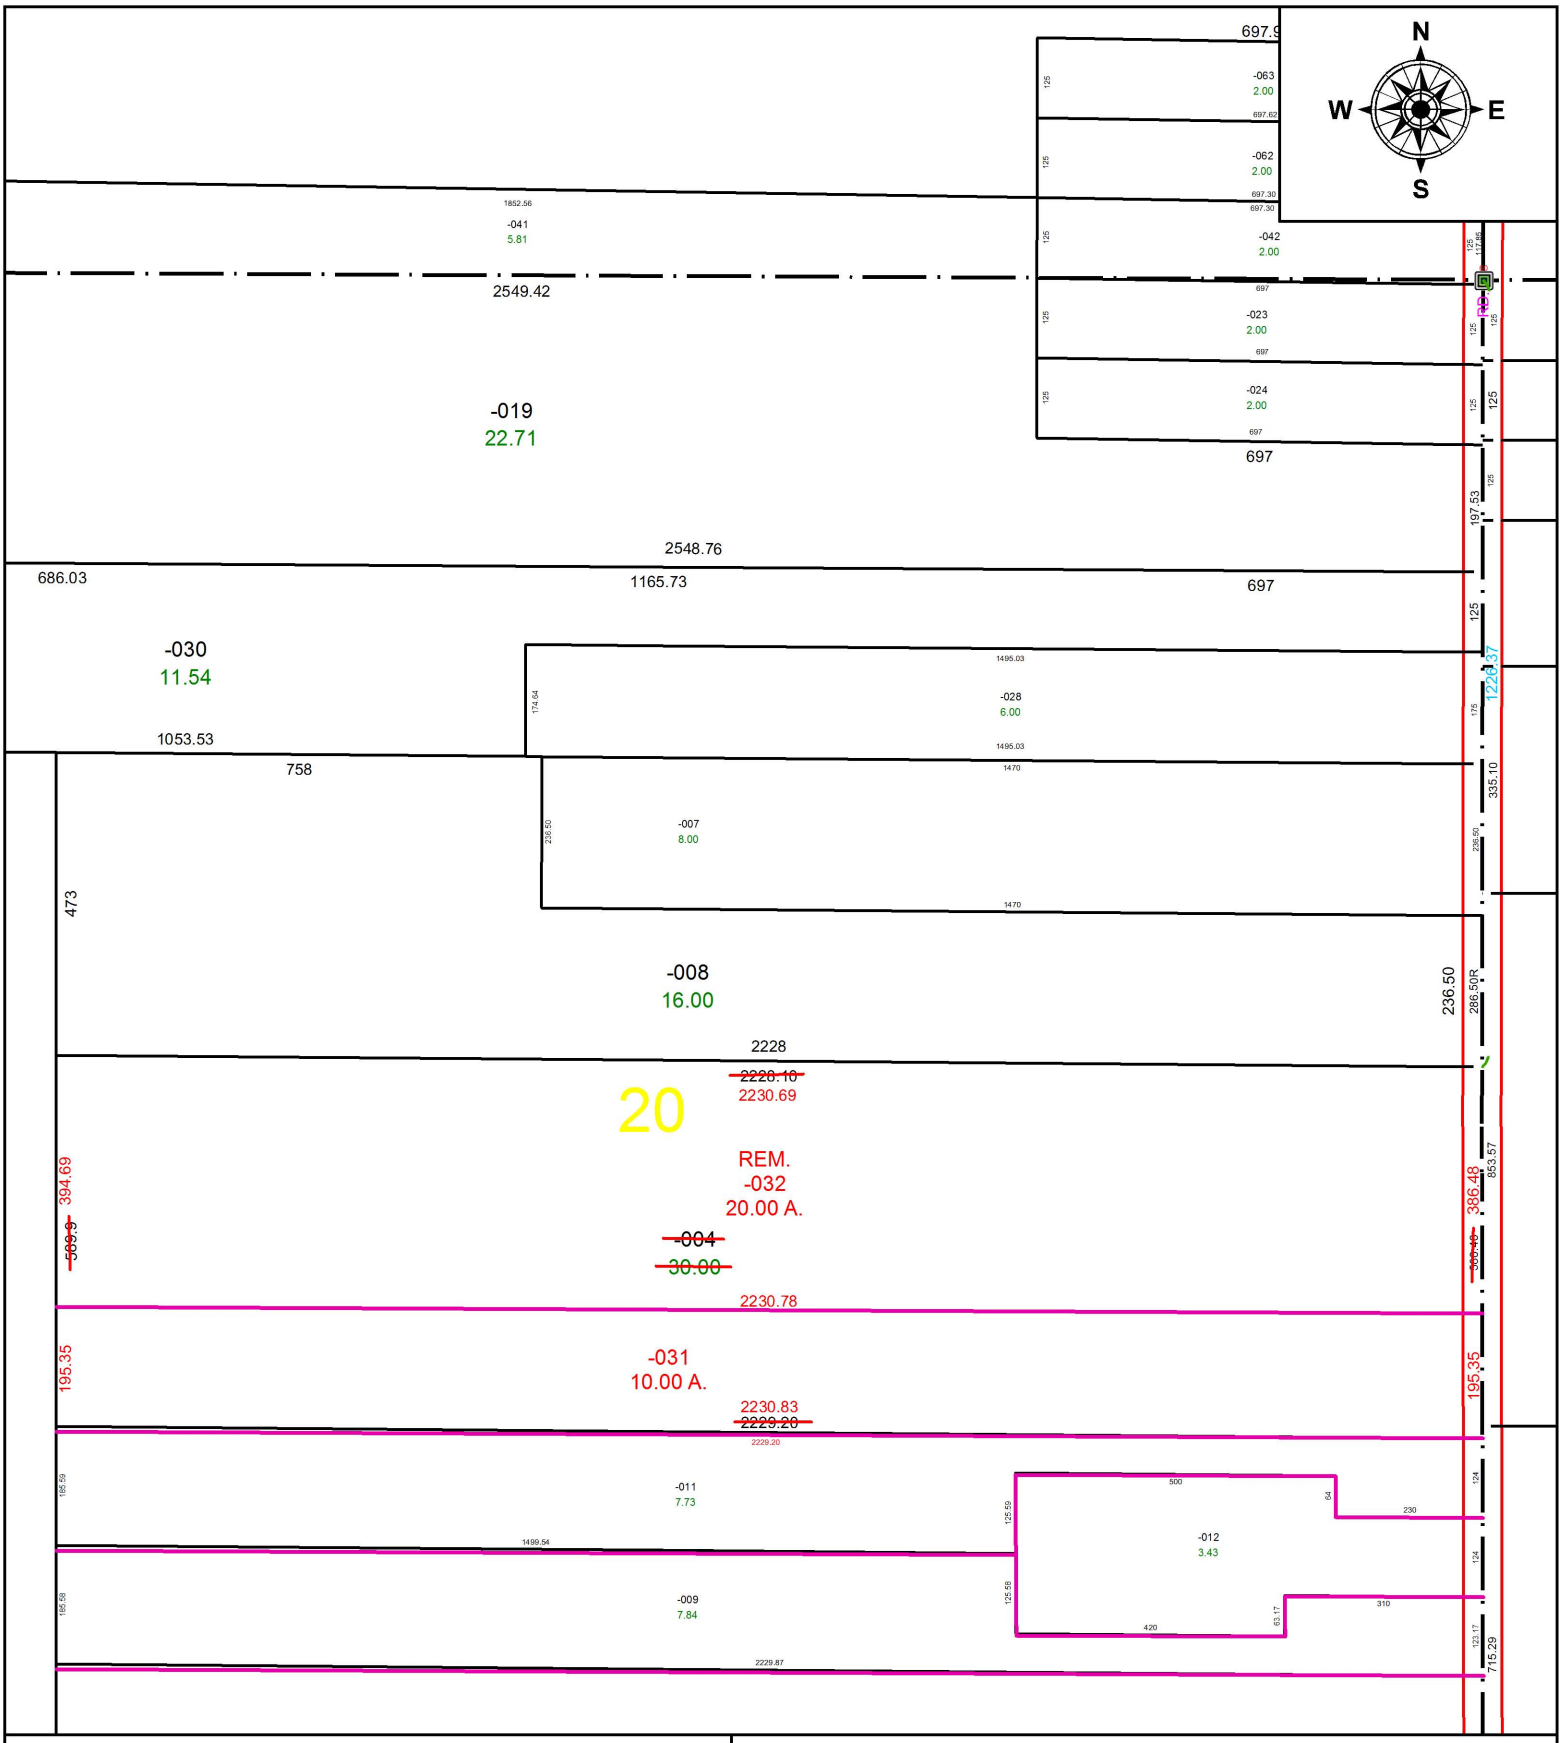

SPLITS/DEEDS PROCESSED

LORAIN COUNTY TAX MAP DEPARTMENT
226 MIDDLE AVE. ELYRIA, OH

SURVEYED BY: THOMAS SIMON
CLOSURE: 1: 95,000
MAP PAGE(S): 11-00-020
APPOVED BY: TJS **DATE:** 12/29/16
SCALE: 1" = 200 **PRIOR INSTRUMENT:** 2016-0586084