PARENT PARCEL: 03-00-113-103-003
CHILD PARCEL: XX-XX-XXX-XXX-XXX
STARTING POINT: INTERSECTION OF C/L OF NORTH RIDGE RD. AND C/L OF BROADWAY

17-03627-D

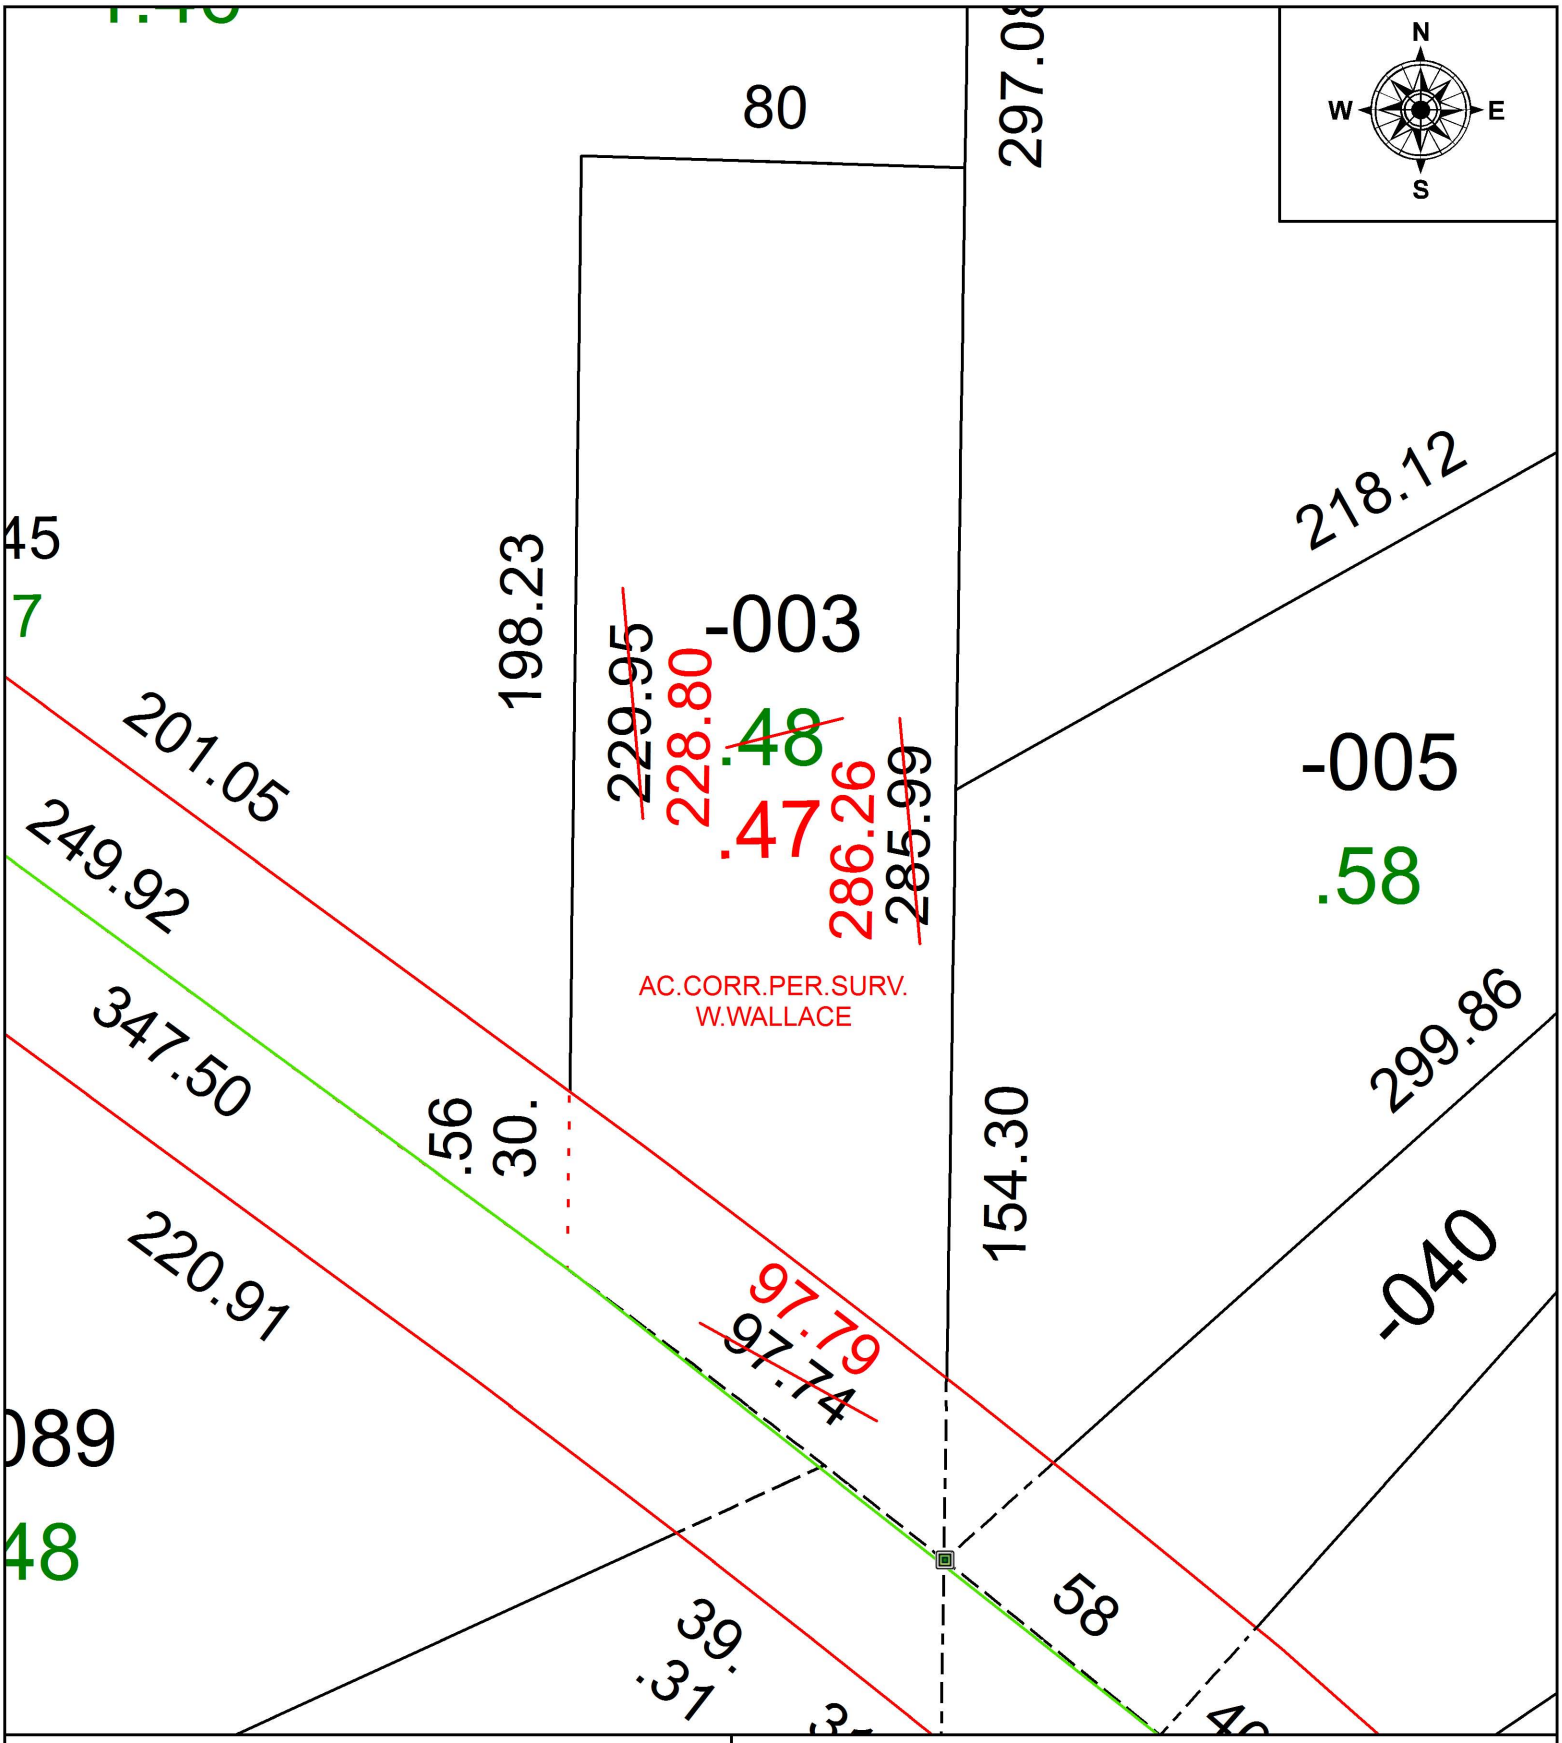

SPLITS/DEEDS PROCESSED
LORAIN COUNTY TAX MAP DEPARTMENT
226 MIDDLE AVE. ELYRIA, OH

SURVEYED BY: WILLIAM R. WALLACE
CLOSURE: 1: 223,315
MAP PAGE(S): 3-00-113
APPOVED BY: RRM **DATE:** 3-10-17
SCALE: 1" = 40 **PRIOR INSTRUMENT:** 20170616929