PARENT PARCEL: 05-00-020-000-127 & -128

CHILD PARCEL: 05-00-020-000-129 THRU -131

STARTING POINT: 5/8" I.P. SET IN THE N.W. CORNER OF HOLLSTEIN DRIVE DED. PLAT VOL. 100 PG. 55

17-03631

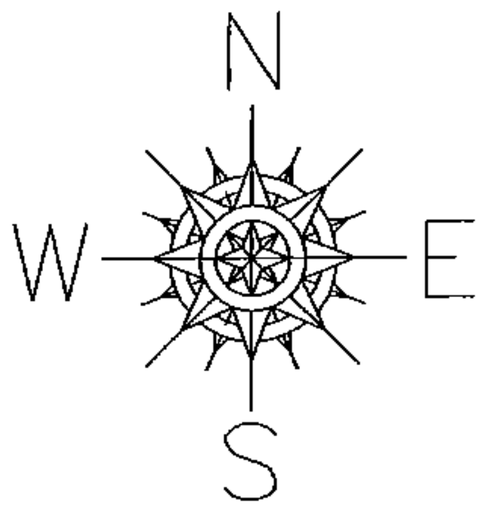

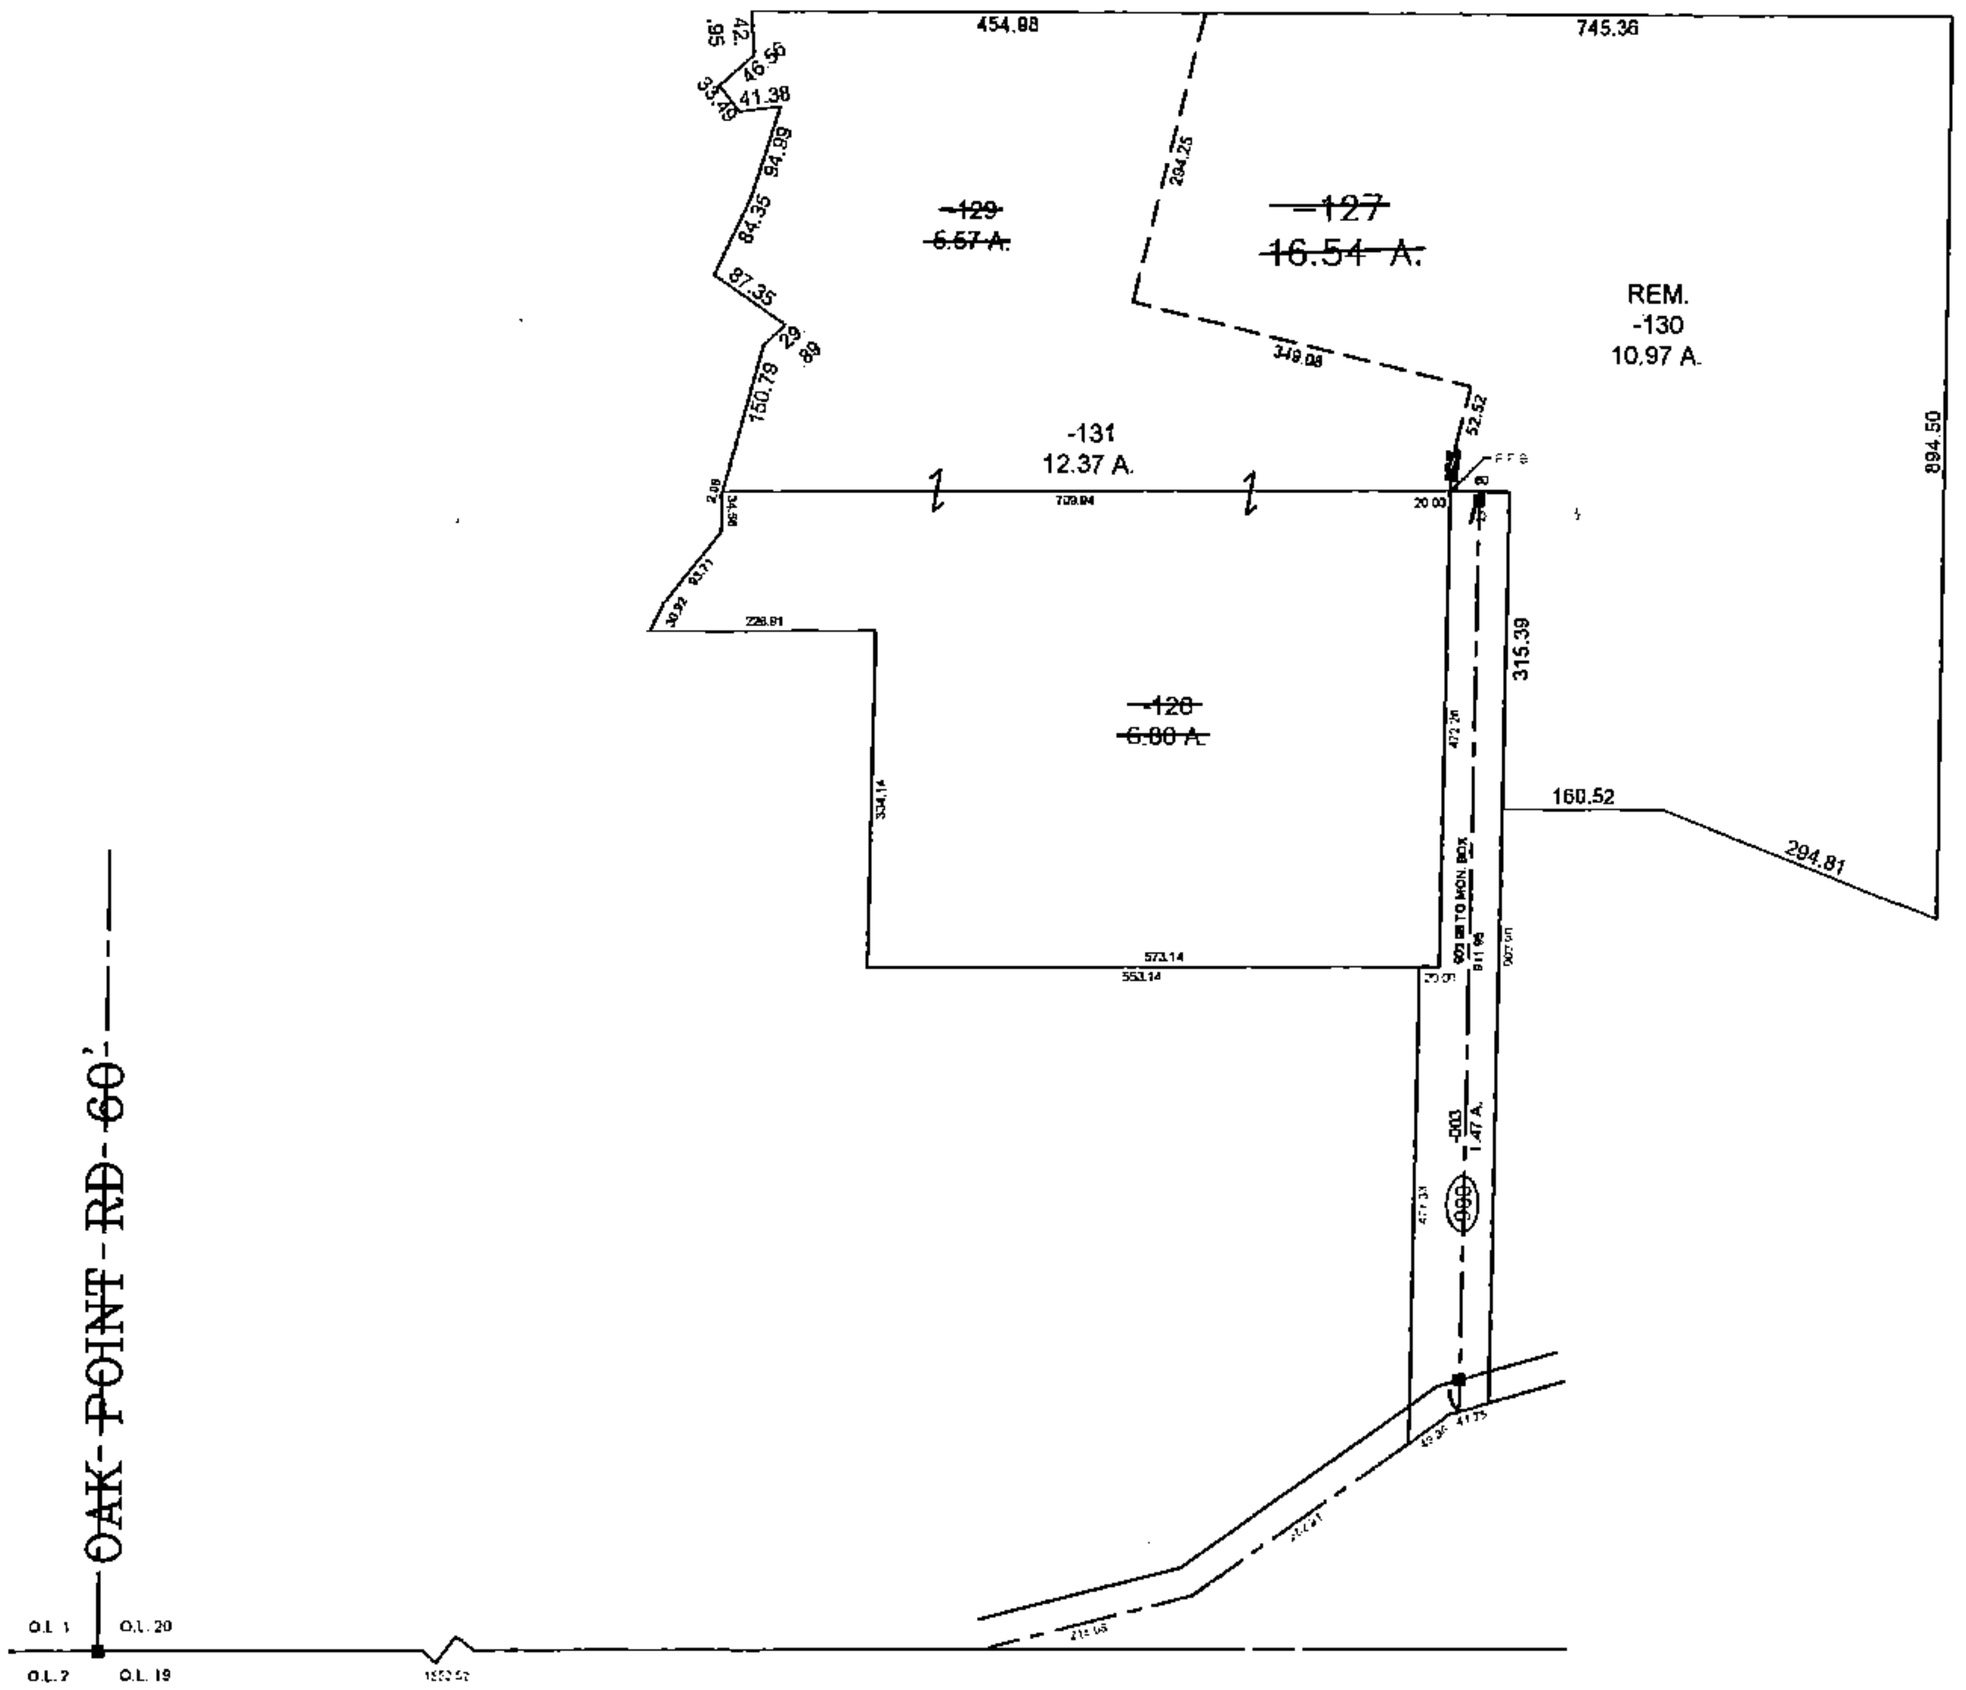

SPLITS/DEEDS PROCESSED

LORAIN COUNTY TAX MAP DEPARTMENT
226 MIDDLE AVE. ELYRIA, OHIO

SURVEYED BY: MICHAEL P. SPELACY

CLOSURE: 0.01 : 10,000

MAP PAGE(S): 05-00-020

APPROVED BY: TJS DATE: 1/25/17

SCALE: 1"= 300 PRIOR INSTRUMENT: 20110395960