PARENT PARCEL: 04-00-017-803-007

CHILD PARCEL: CERTIFICAT OF CORRECTION - FRONTAGE CORRECTION

STARTING POINT: XXXXXX

17-03632-C

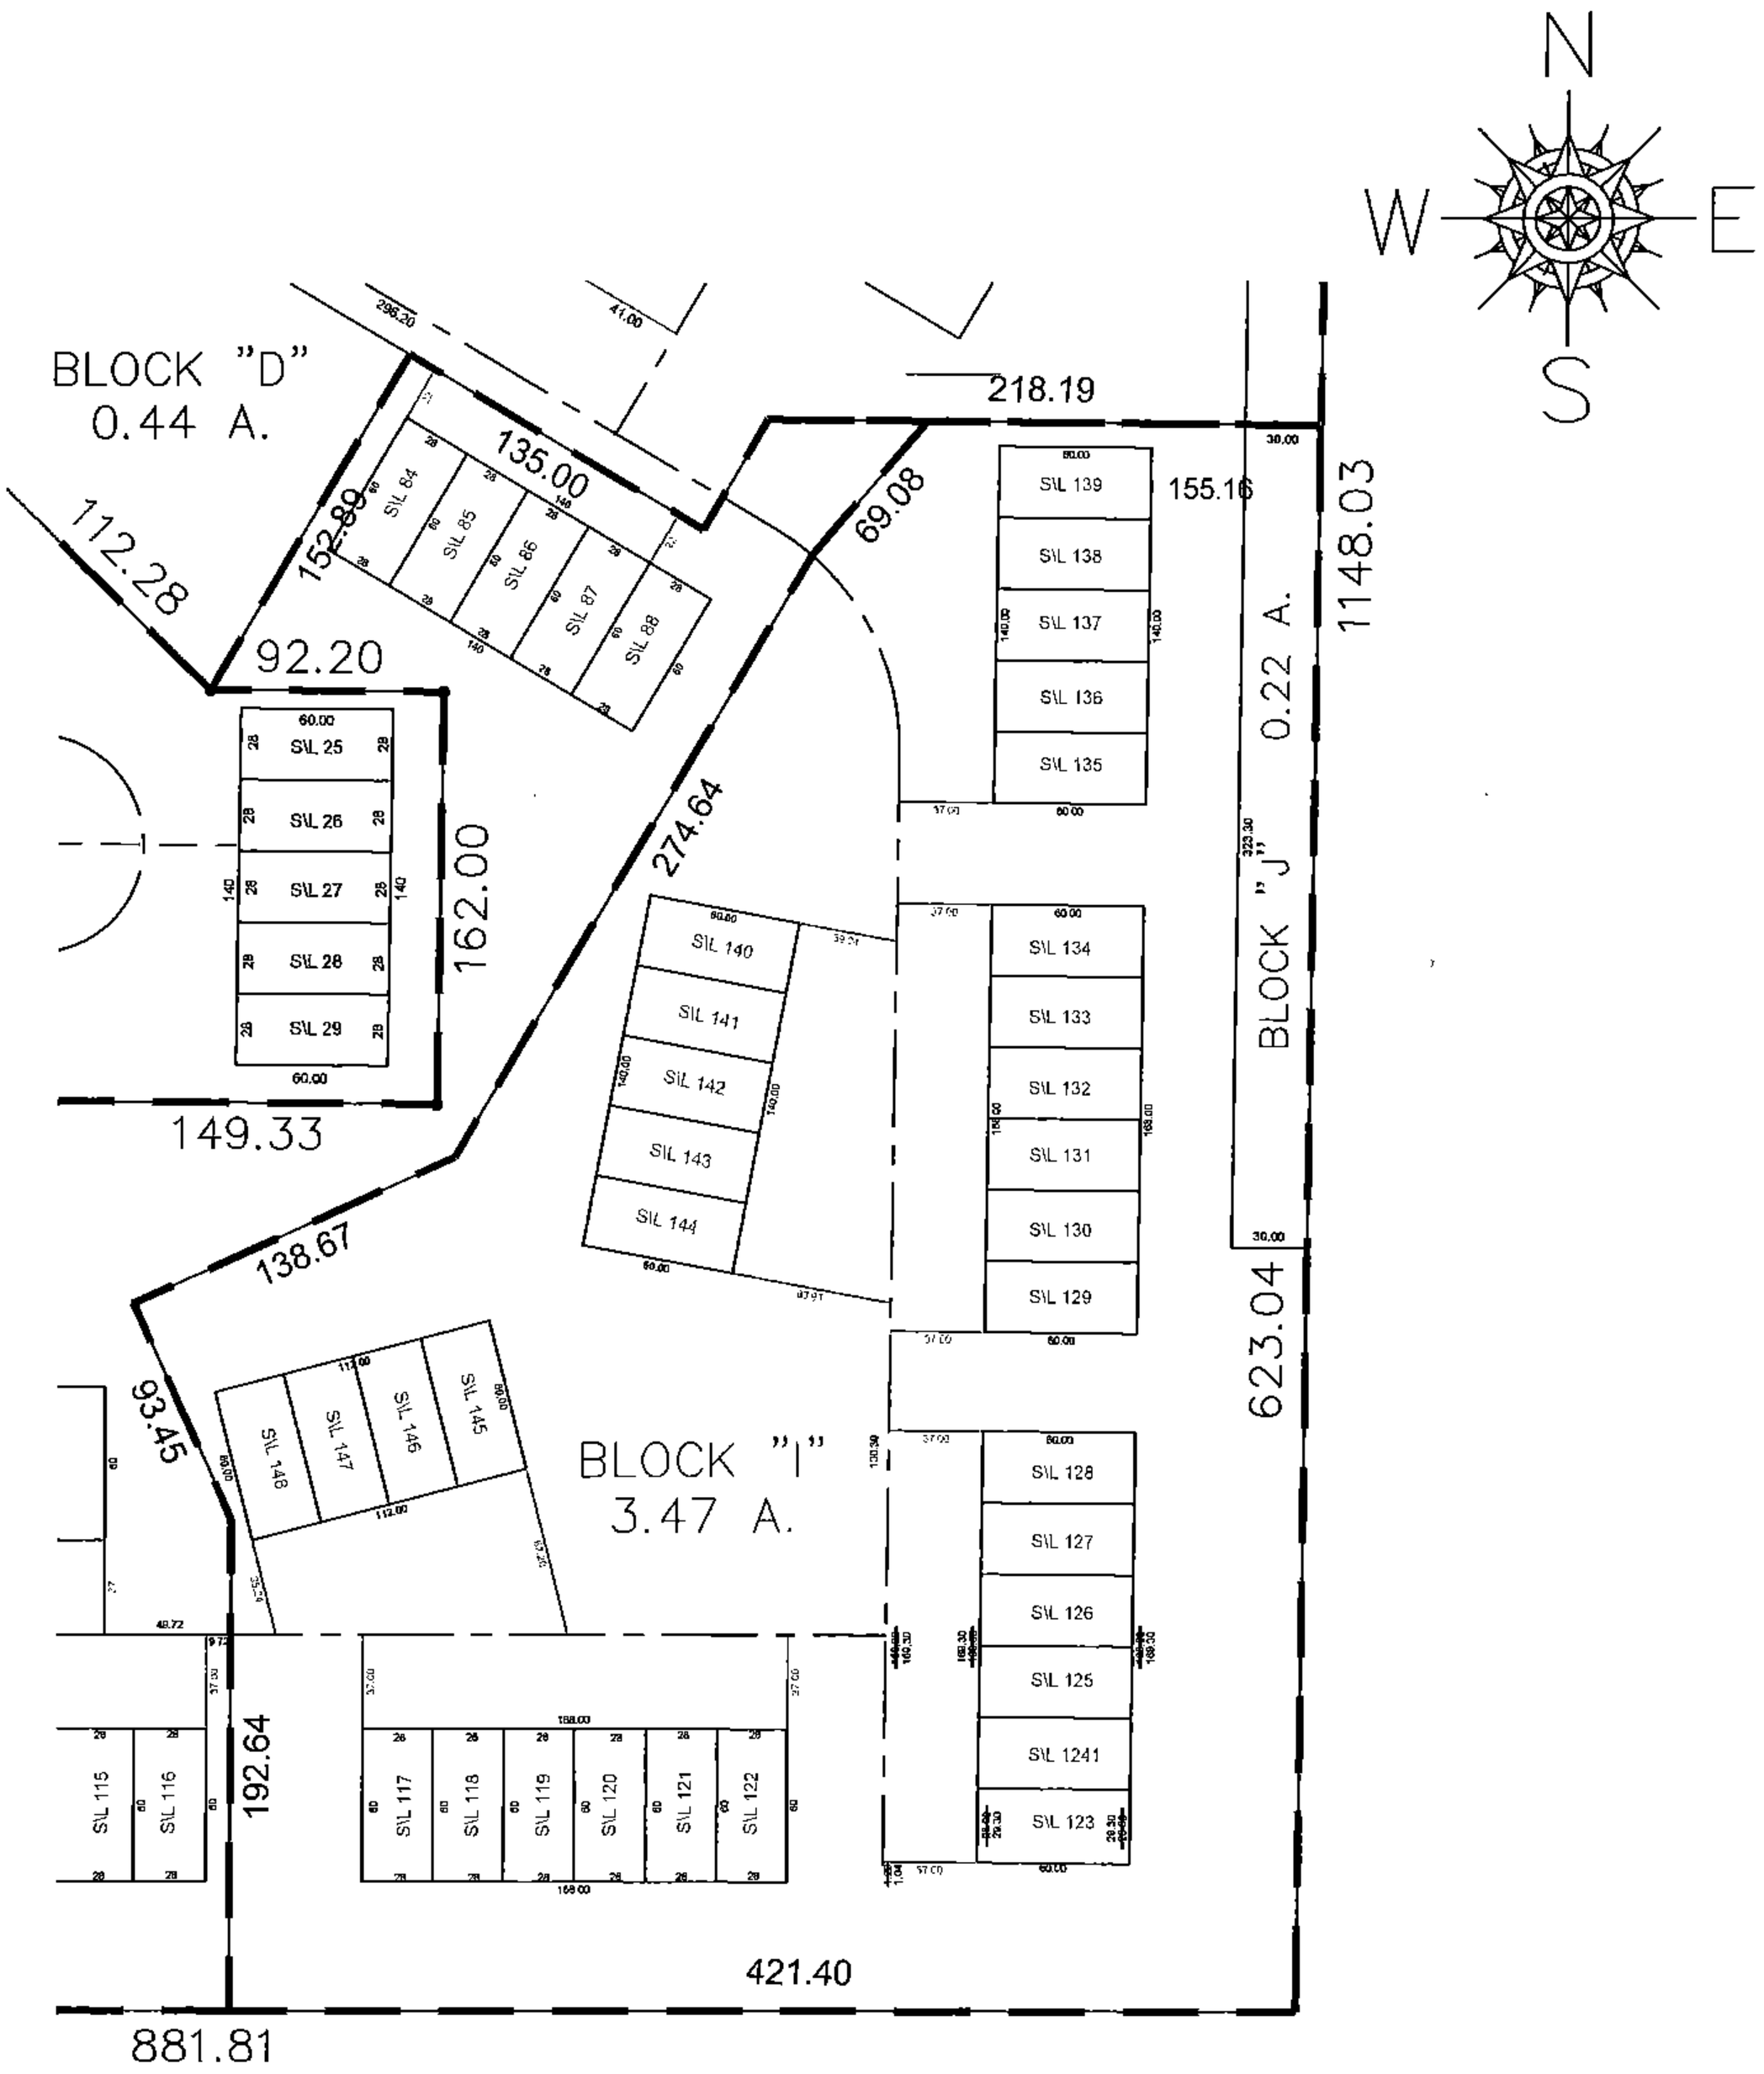

SPLITS/DEEDS PROCESSED

LORAIN COUNTY TAX MAP DEPARTMENT

226 MIDDLE AVE. ELYRIA, OHIO

SURVEYED BY: D. SAYLER

CLOSURE: NA

MAP PAGE(S): 04-00-017

APPROVED BY: TJS DATE: 3/29/17

SCALE: 1"= 100 PRIOR INSTRUMENT: PV. 93/13