PARENT PARCEL: 03-00-049-104-019

CHILD PARCEL: 03-00-049-104-022, -023

STARTING POINT: INTERSECTION EASTERLY LINE OF MISSOURI AVE AND NORTHERLY LINE OF LAKE SHORE ELECTRIC R.R.

17-03634-U

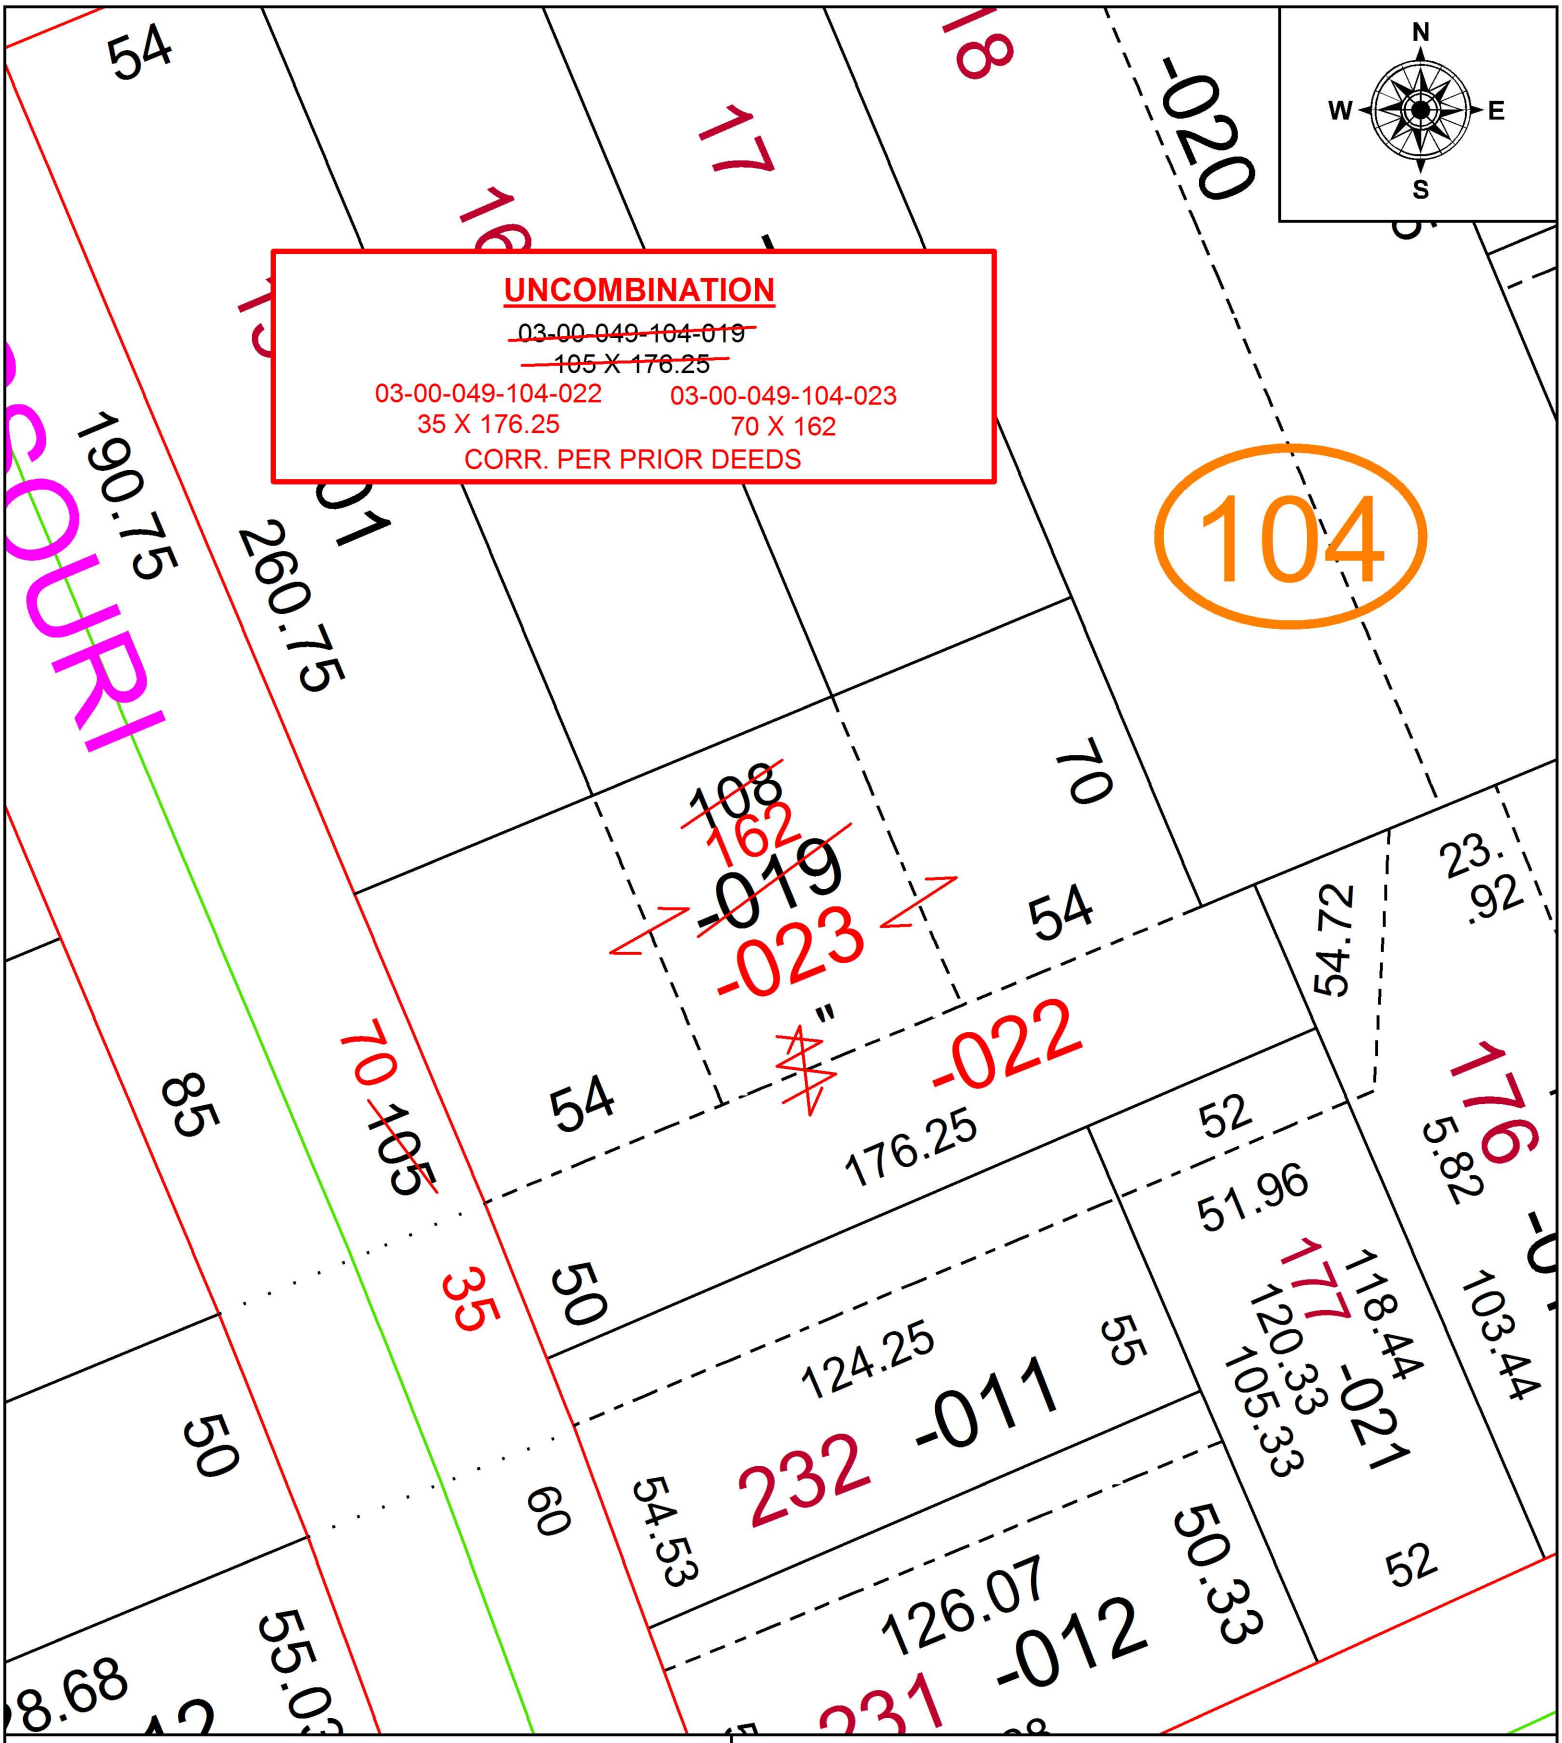

SPLITS/DEEDS PROCESSED

LORAIN COUNTY TAX MAP DEPARTMENT
226 MIDDLE AVE. ELYRIA, OH

SURVEYED BY: N/A
CLOSURE: N/A
MAP PAGE(S): 3-00-049
APPOVED BY: RRM **DATE:** 3-23-17
SCALE: 1" = 40 **PRIOR INSTRUMENT:** 20120439274