PARENT PARCEL: 14-00-044-000-027, -028, -031

CHILD PARCEL: 14-00-044-000-033

STARTING POINT: INTERSECTION OF C/L OF HUGHES RD. AND C/L OF HALLAUER RD.

17-03634

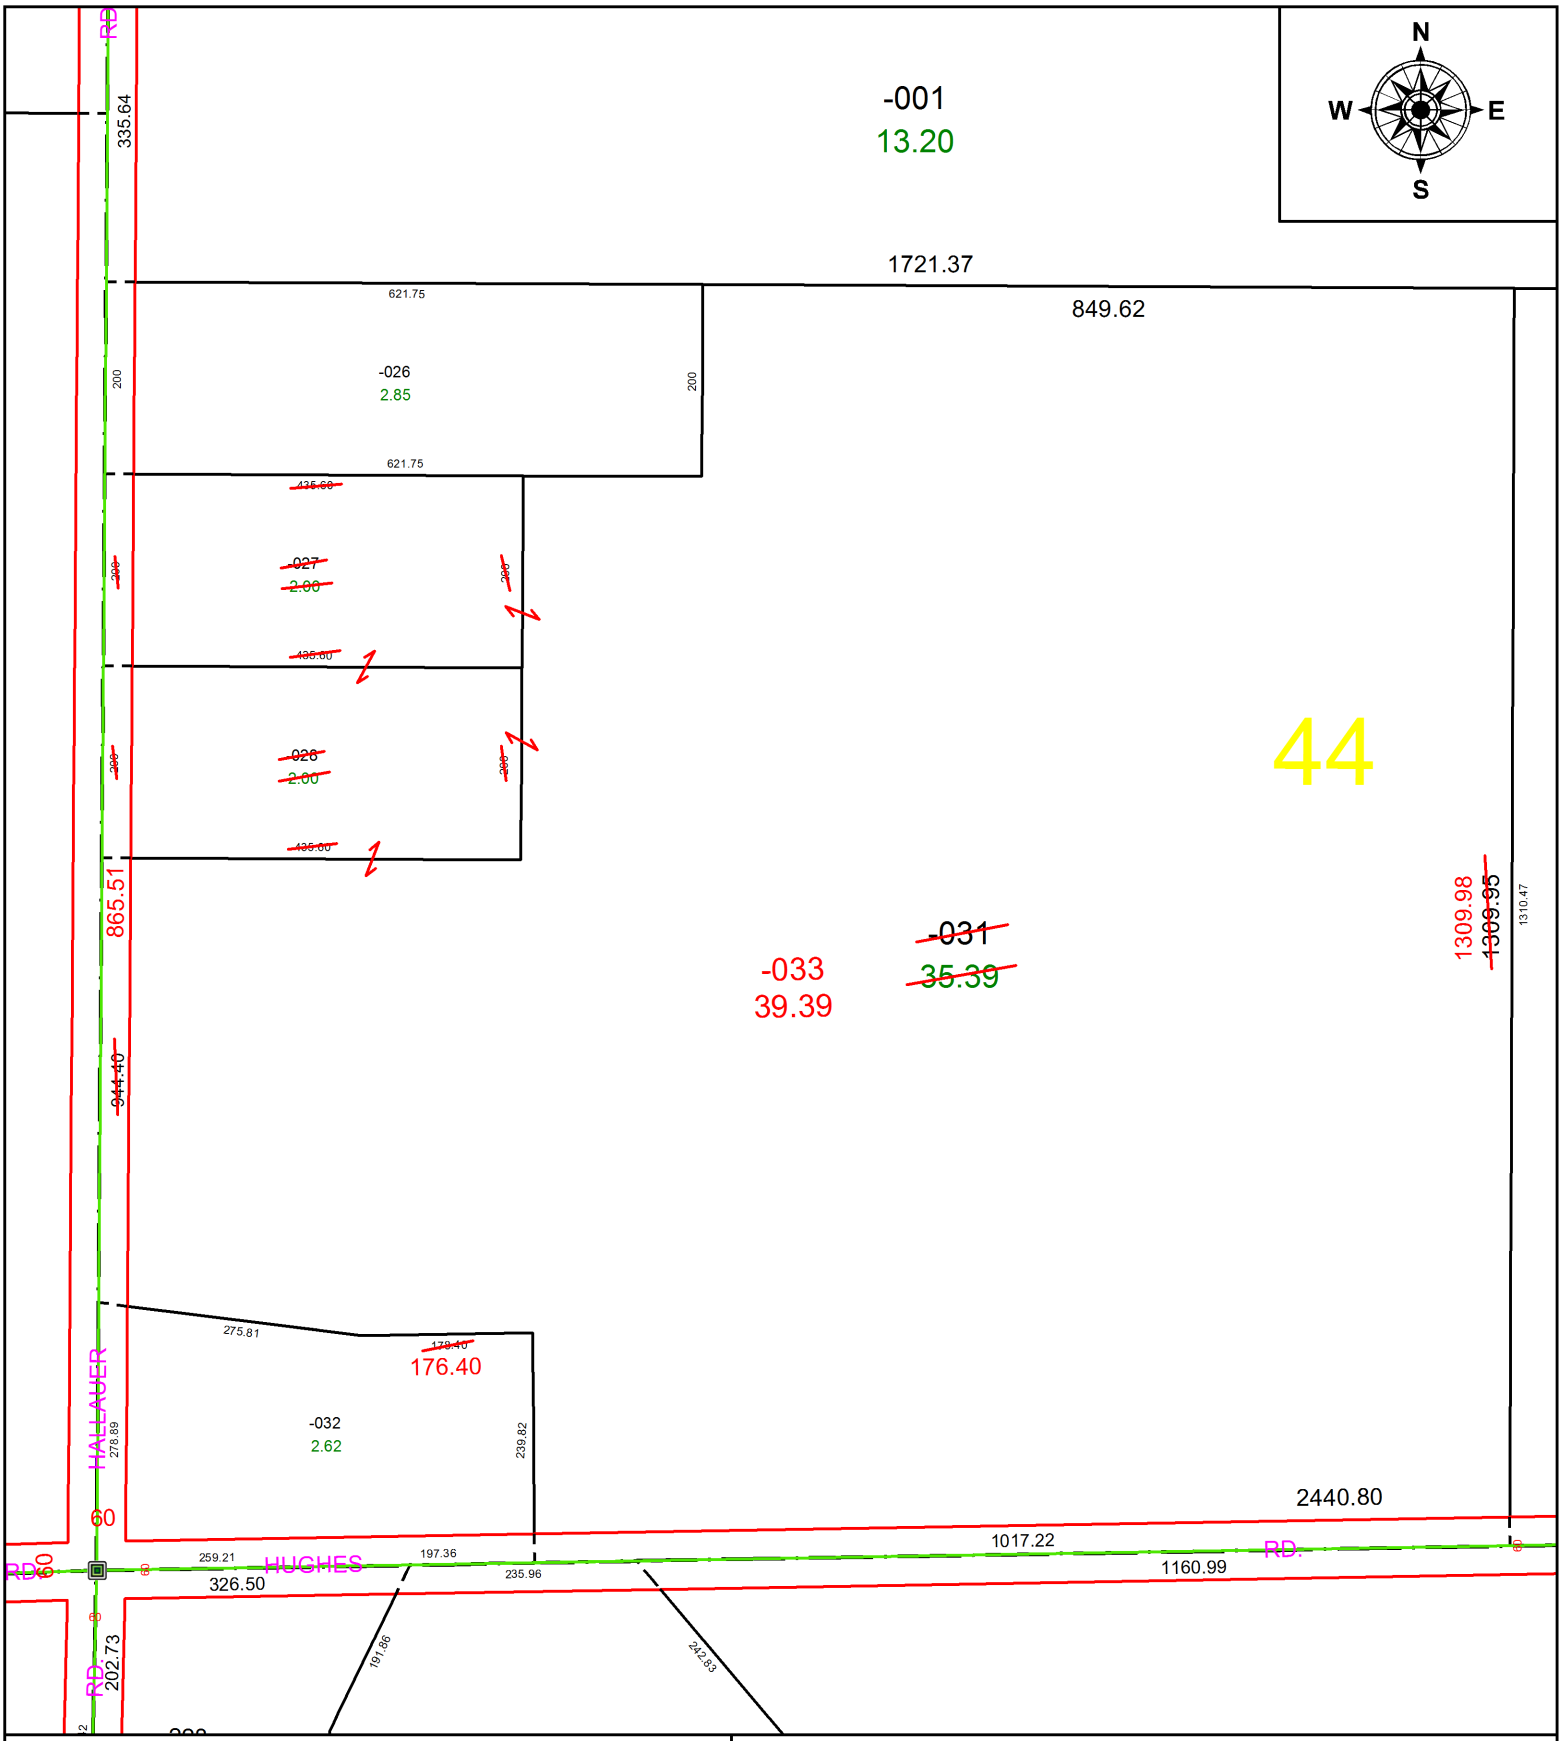

SPLITS/DEEDS PROCESSED

LORAIN COUNTY TAX MAP DEPARTMENT
226 MIDDLE AVE. ELYRIA, OH

SURVEYED BY: AMY M. KELLY
CLOSURE: 1: 520.459
MAP PAGE(S): 14-C
APPOVED BY: RRM **DATE:** 2-9-17
SCALE: 1" = 200 **PRIOR INSTRUMENT:** 20020820645