PARENT PARCEL: 02-03-006-110-009
CHILD PARCEL: XX-XX-XXX-XXX-XXX
STARTING POINT: INTERSECTION OF C/L OF SOUTH PARK DR. AND C/L OF ROSECLIFF DR.

17-03635-D

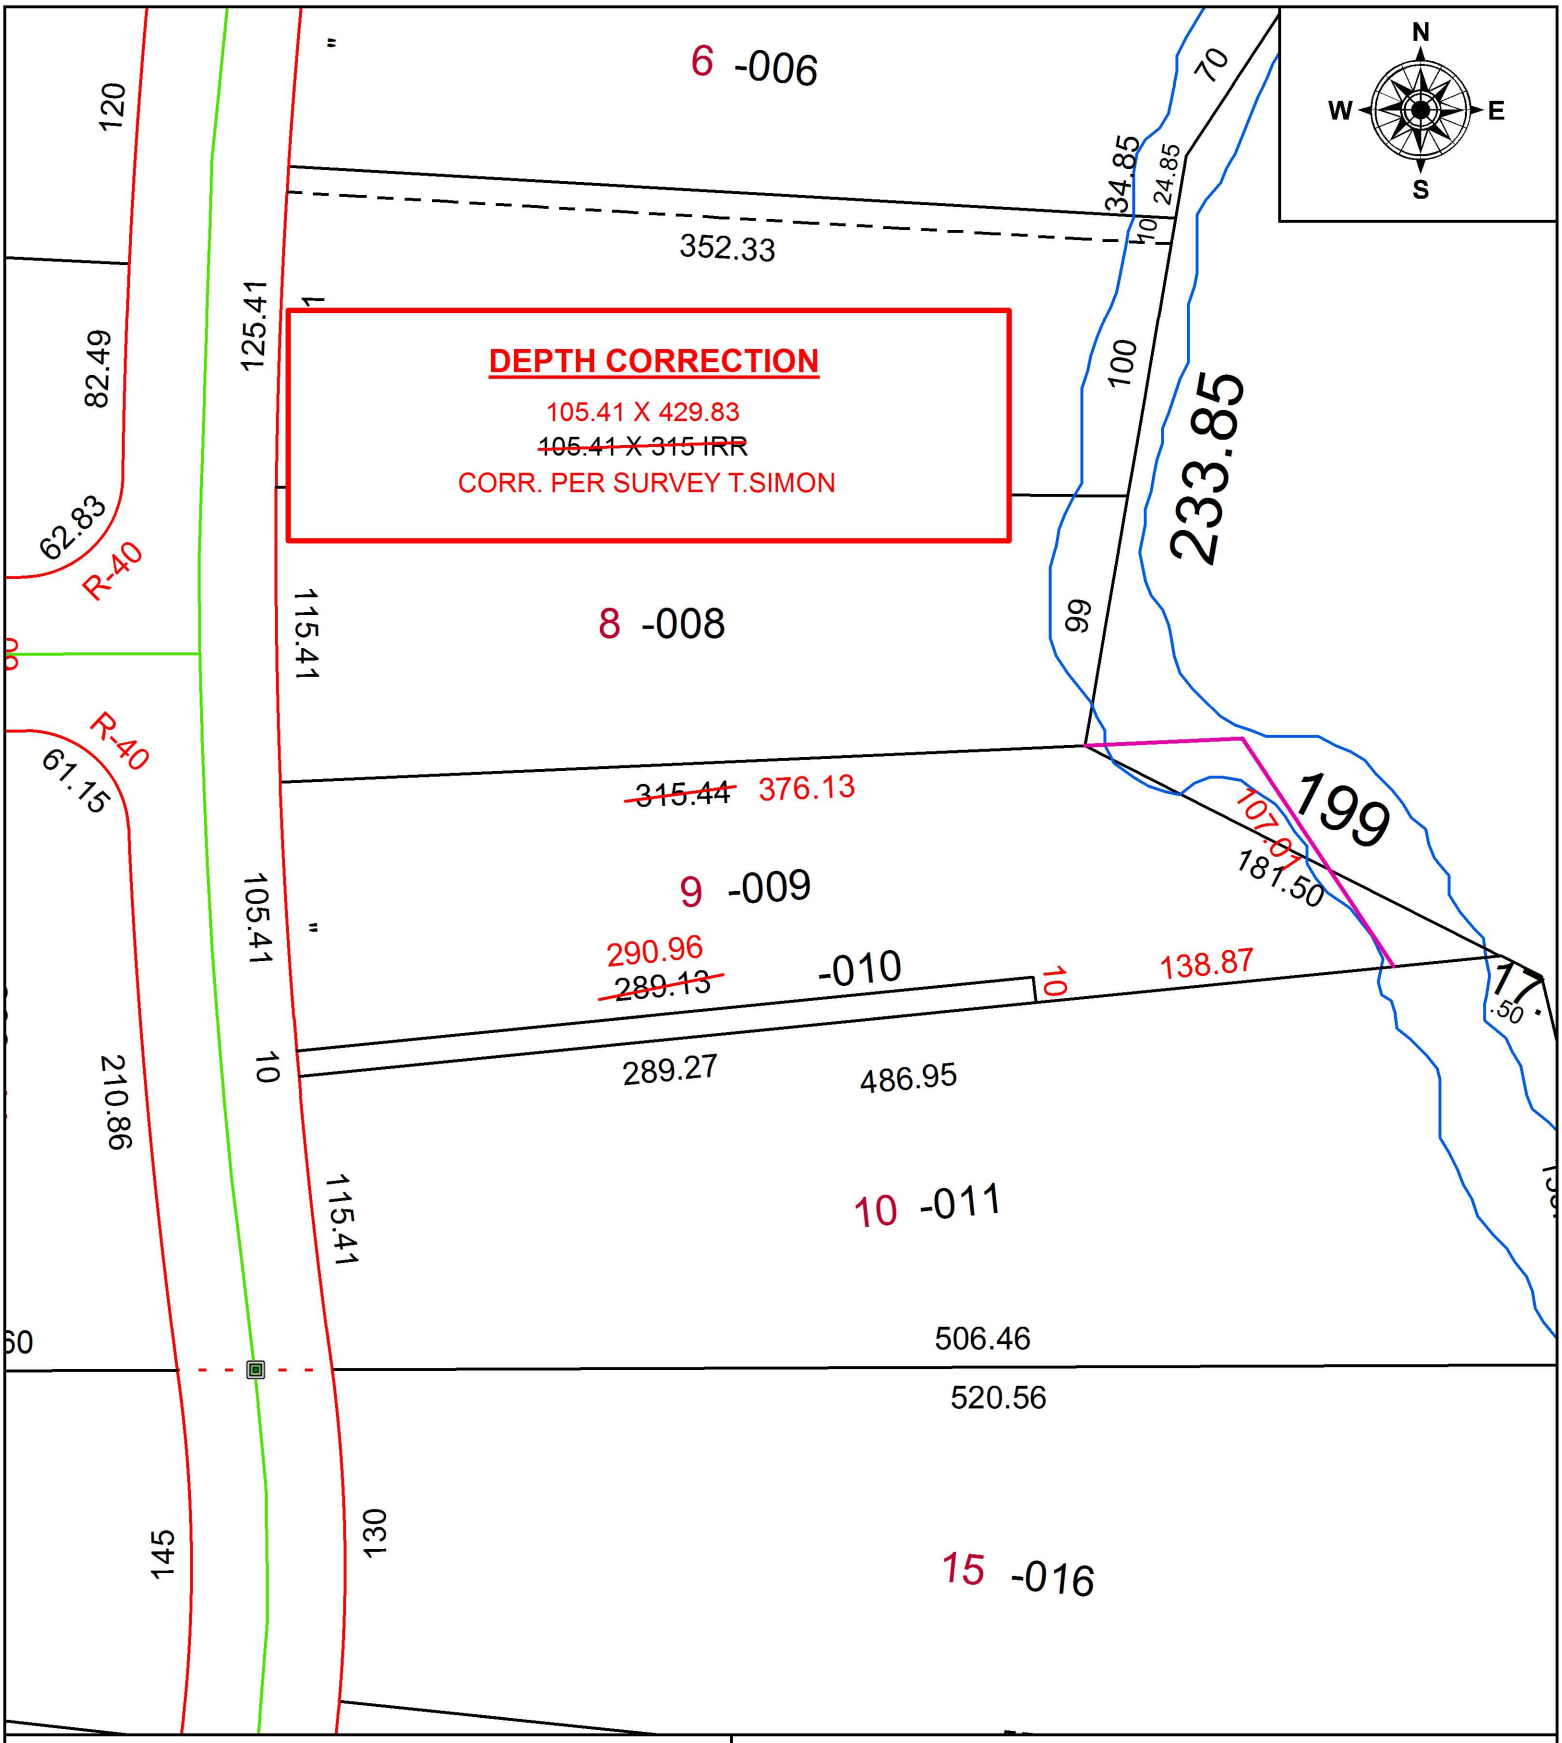

SPLITS/DEEDS PROCESSED
LORAIN COUNTY TAX MAP DEPARTMENT
226 MIDDLE AVE. ELYRIA, OH

SURVEYED BY: THOMAS A. SIMON
CLOSURE: 1: 53,779
MAP PAGE(S): 2-03-006
APPOVED BY: RRM **DATE:** 3-23-17
SCALE: 1" = 75 **PRIOR INSTRUMENT:** 20170614628