PARENT PARCEL: 11-00-063-000-023, -025, 11-00-059-000-001

CHILD PARCEL: 11-00-063-000-029 THRU -031, 11-00-059-000-001

STARTING POINT: NORTHEAST CORNER OF O.L.63

17-03641

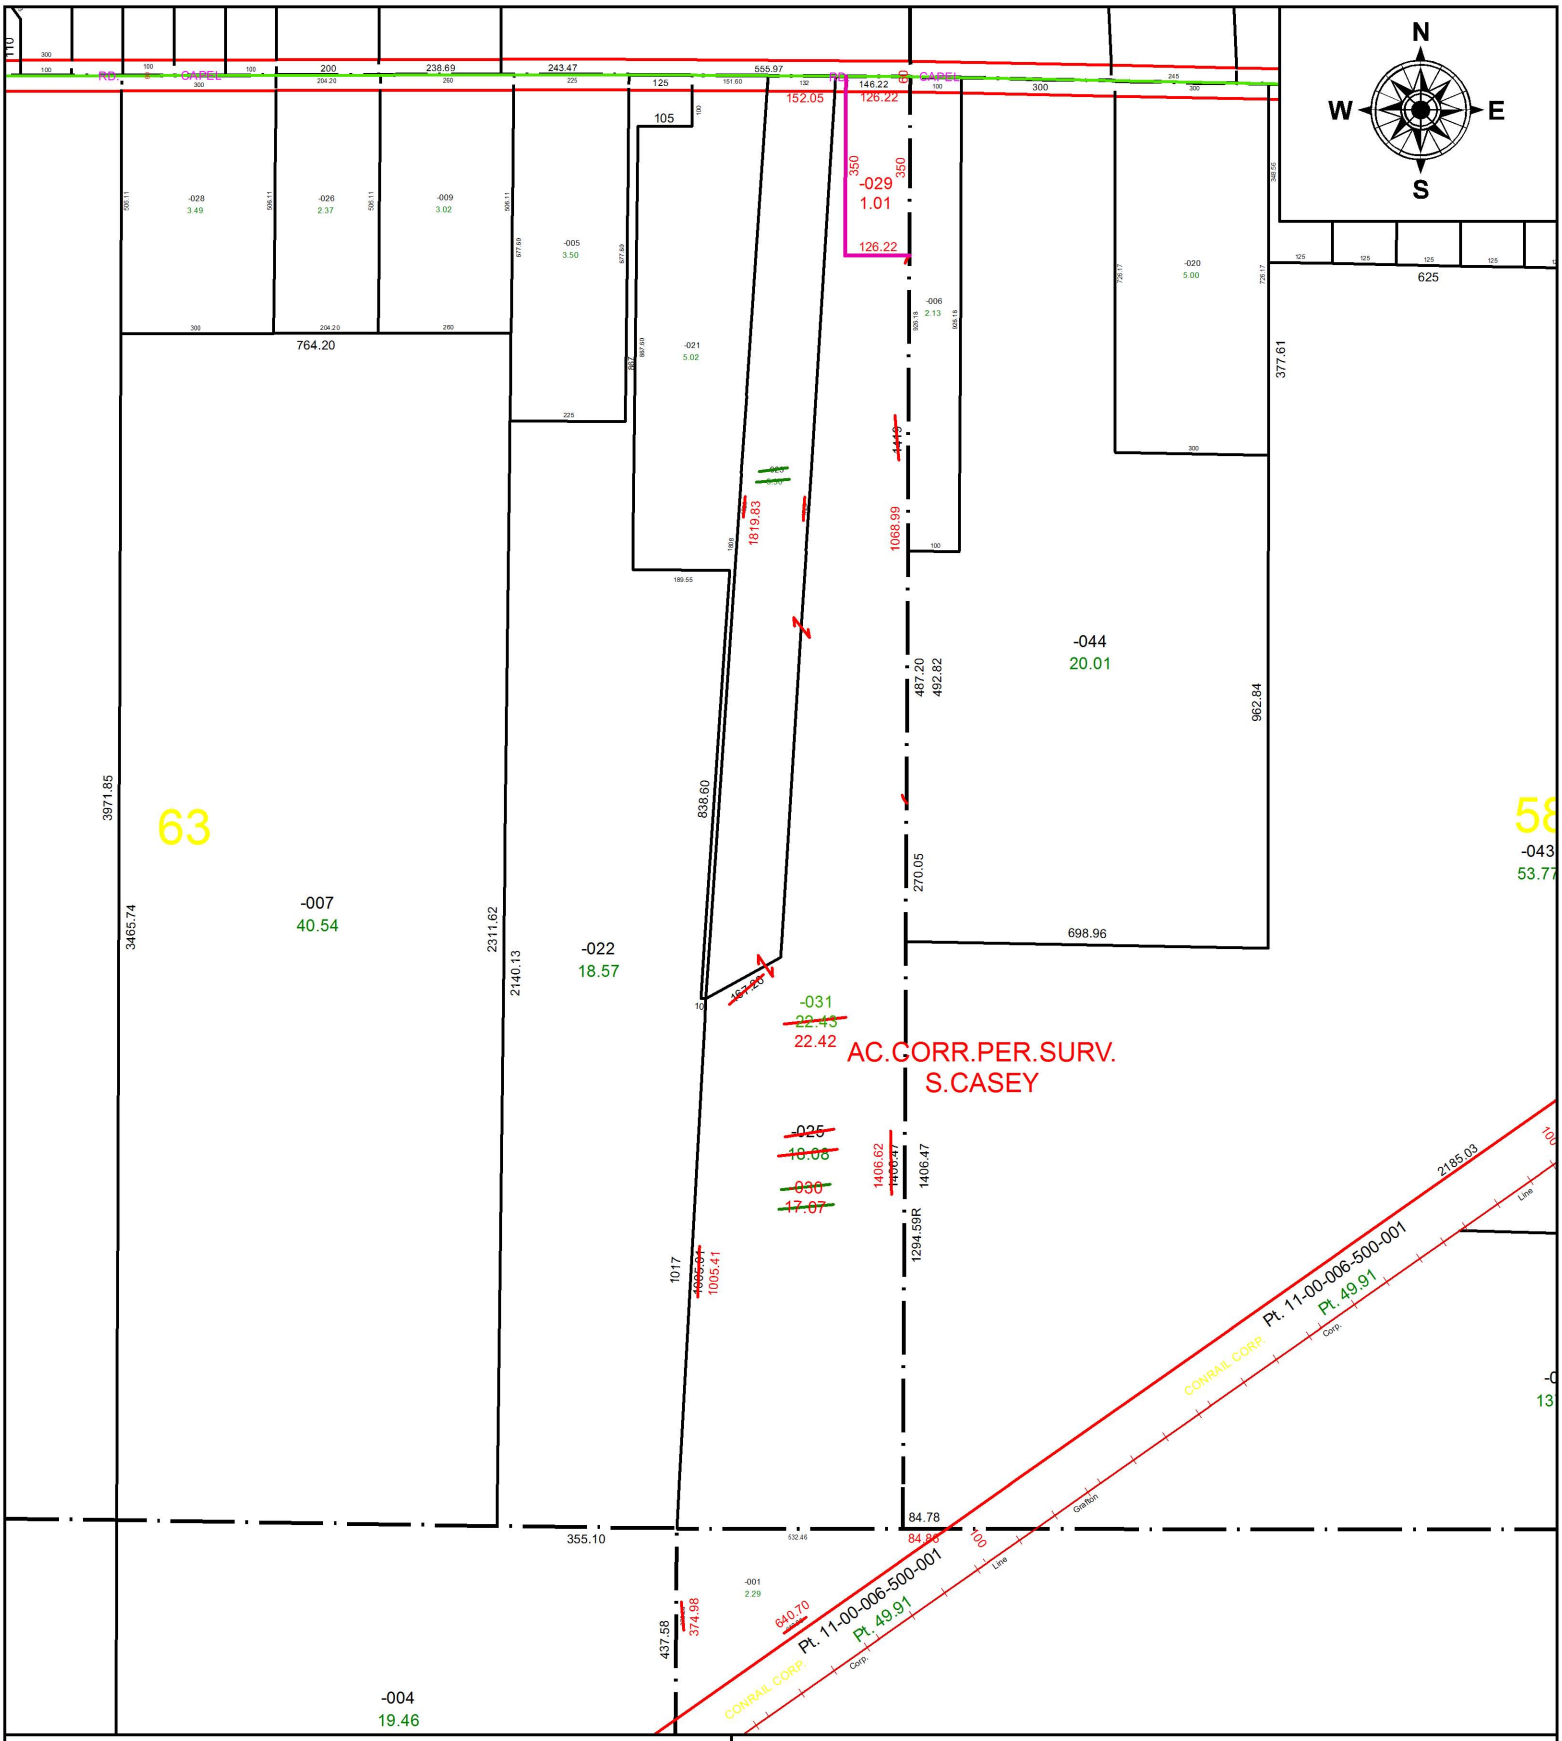

SPLITS/DEEDS PROCESSED

LORAIN COUNTY TAX MAP DEPARTMENT
226 MIDDLE AVE. ELYRIA, OH

SURVEYED BY: SCOTT J. CASEY
CLOSURE: 1: 624,891
MAP PAGE(S): 11-00-063
APPOVED BY: RRM **DATE:** 2-21-17
SCALE: 1" = 375 **PRIOR INSTRUMENT:** 19990646516