PARENT PARCEL: 19-02-056-000-018
CHILD PARCEL: 19-02-056-000-019, -020
STARTING POINT: INTERSECTION OF C/L OF FOSTER RD. AND C/L OF JONES RD.

17-03643

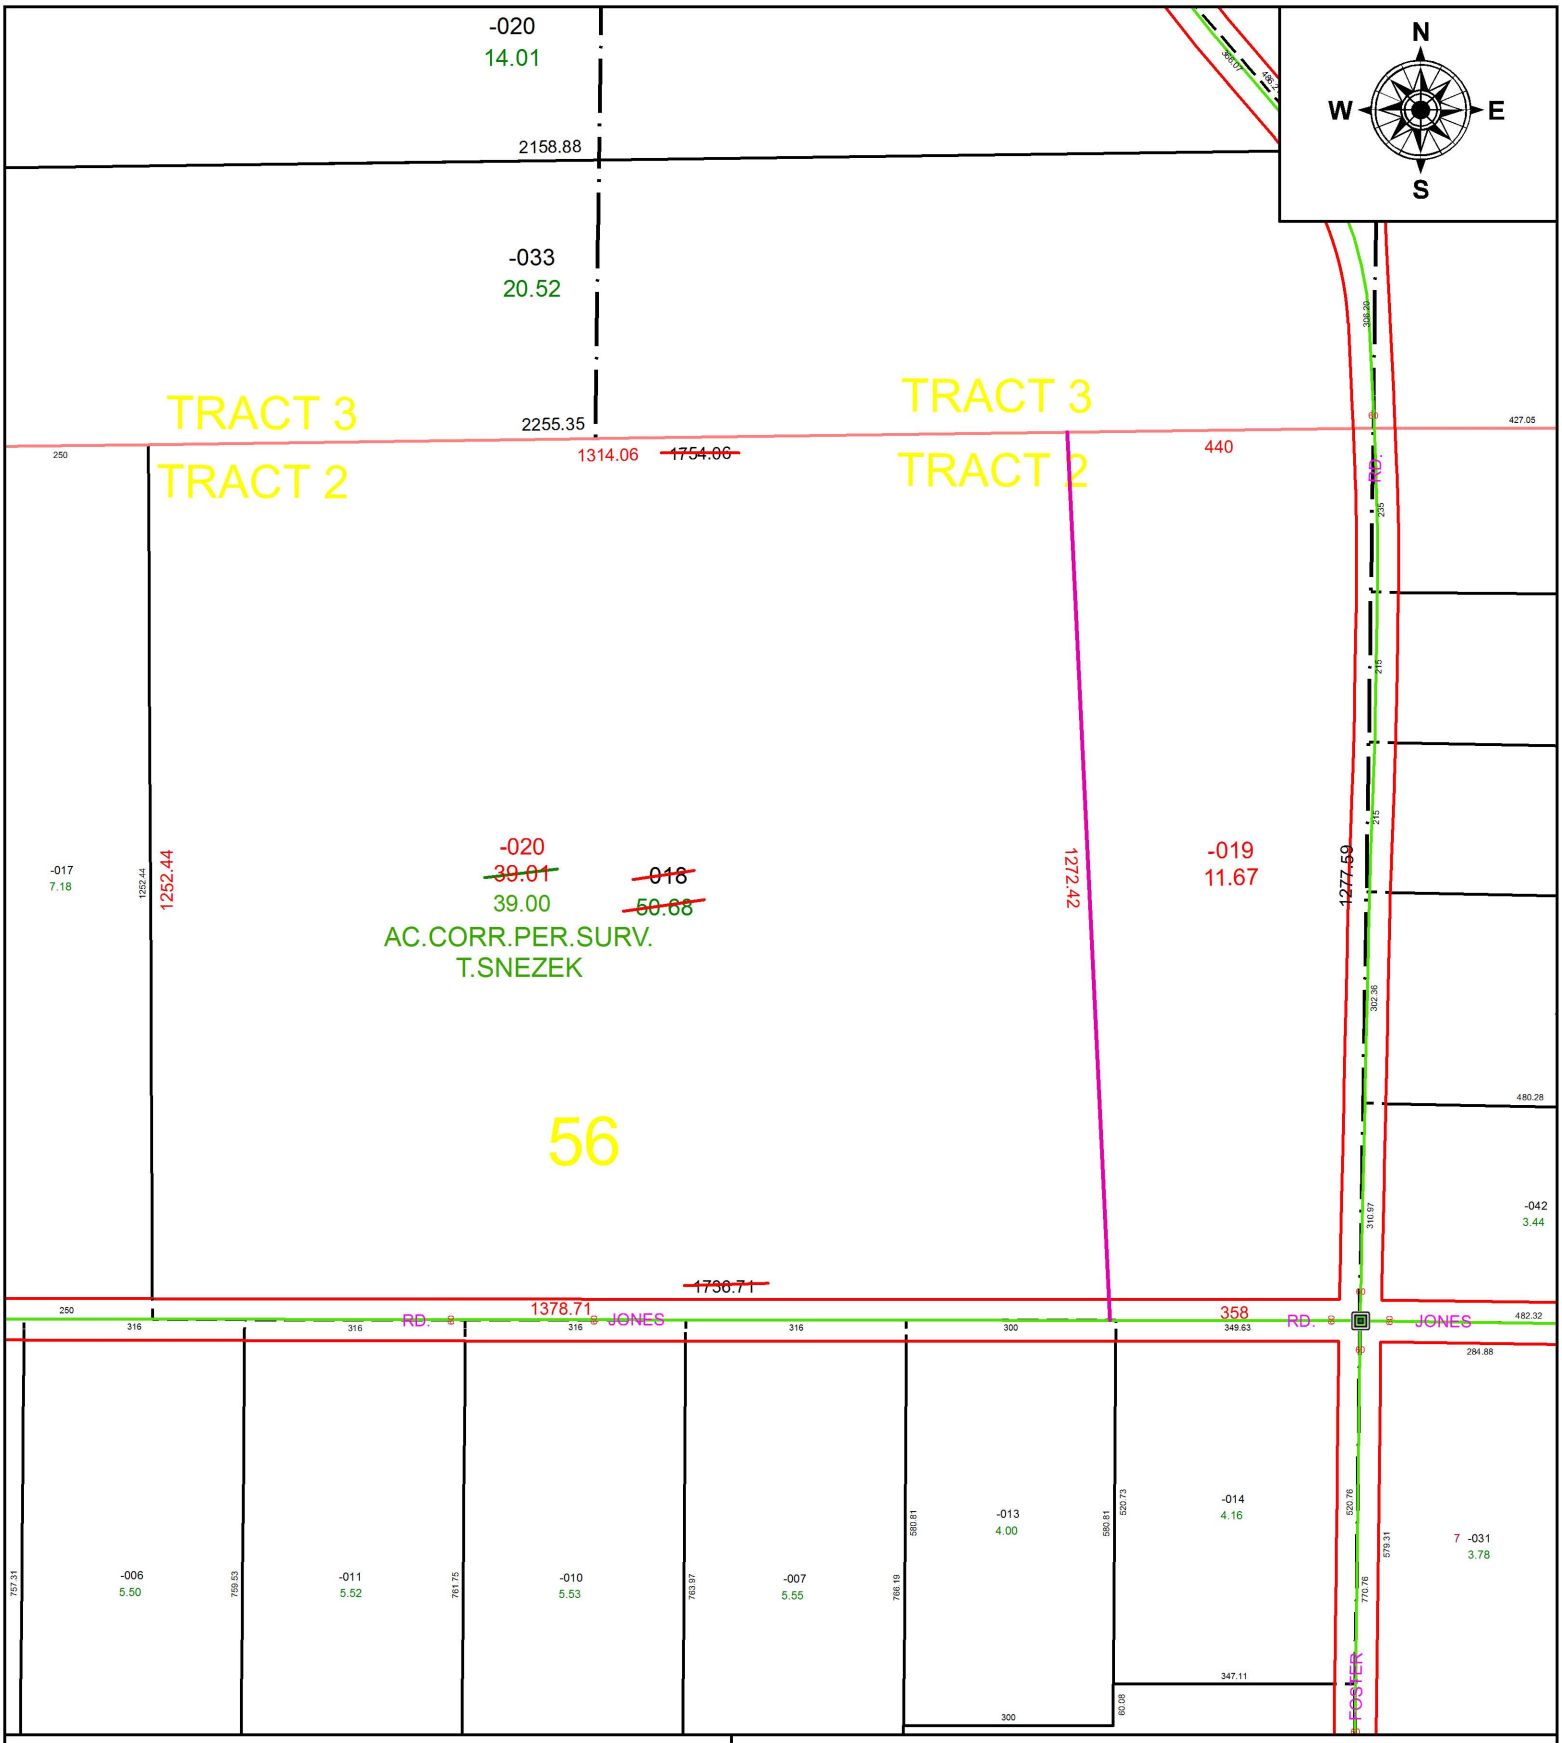

SPLITS/DEEDS PROCESSED

LORAIN COUNTY TAX MAP DEPARTMENT
226 MIDDLE AVE. ELYRIA, OH

SURVEYED BY: THOMAS M. SNEZEK
CLOSURE: 1: 9,427,619
MAP PAGE(S): 19-02-056
APPOVED BY: RRM **DATE:** 2-22-17
SCALE: 1" = 275 **PRIOR INSTRUMENT:** 20120418317