PARENT PARCEL: 03-00-050-109-020
CHILD PARCEL: 03-00-050-109-021, -022
STARTING POINT: S/L'S 50 AND 51 IN COLORADO PARK ALLOTMENT (VOL. 9 PG 12)

17-03644-U

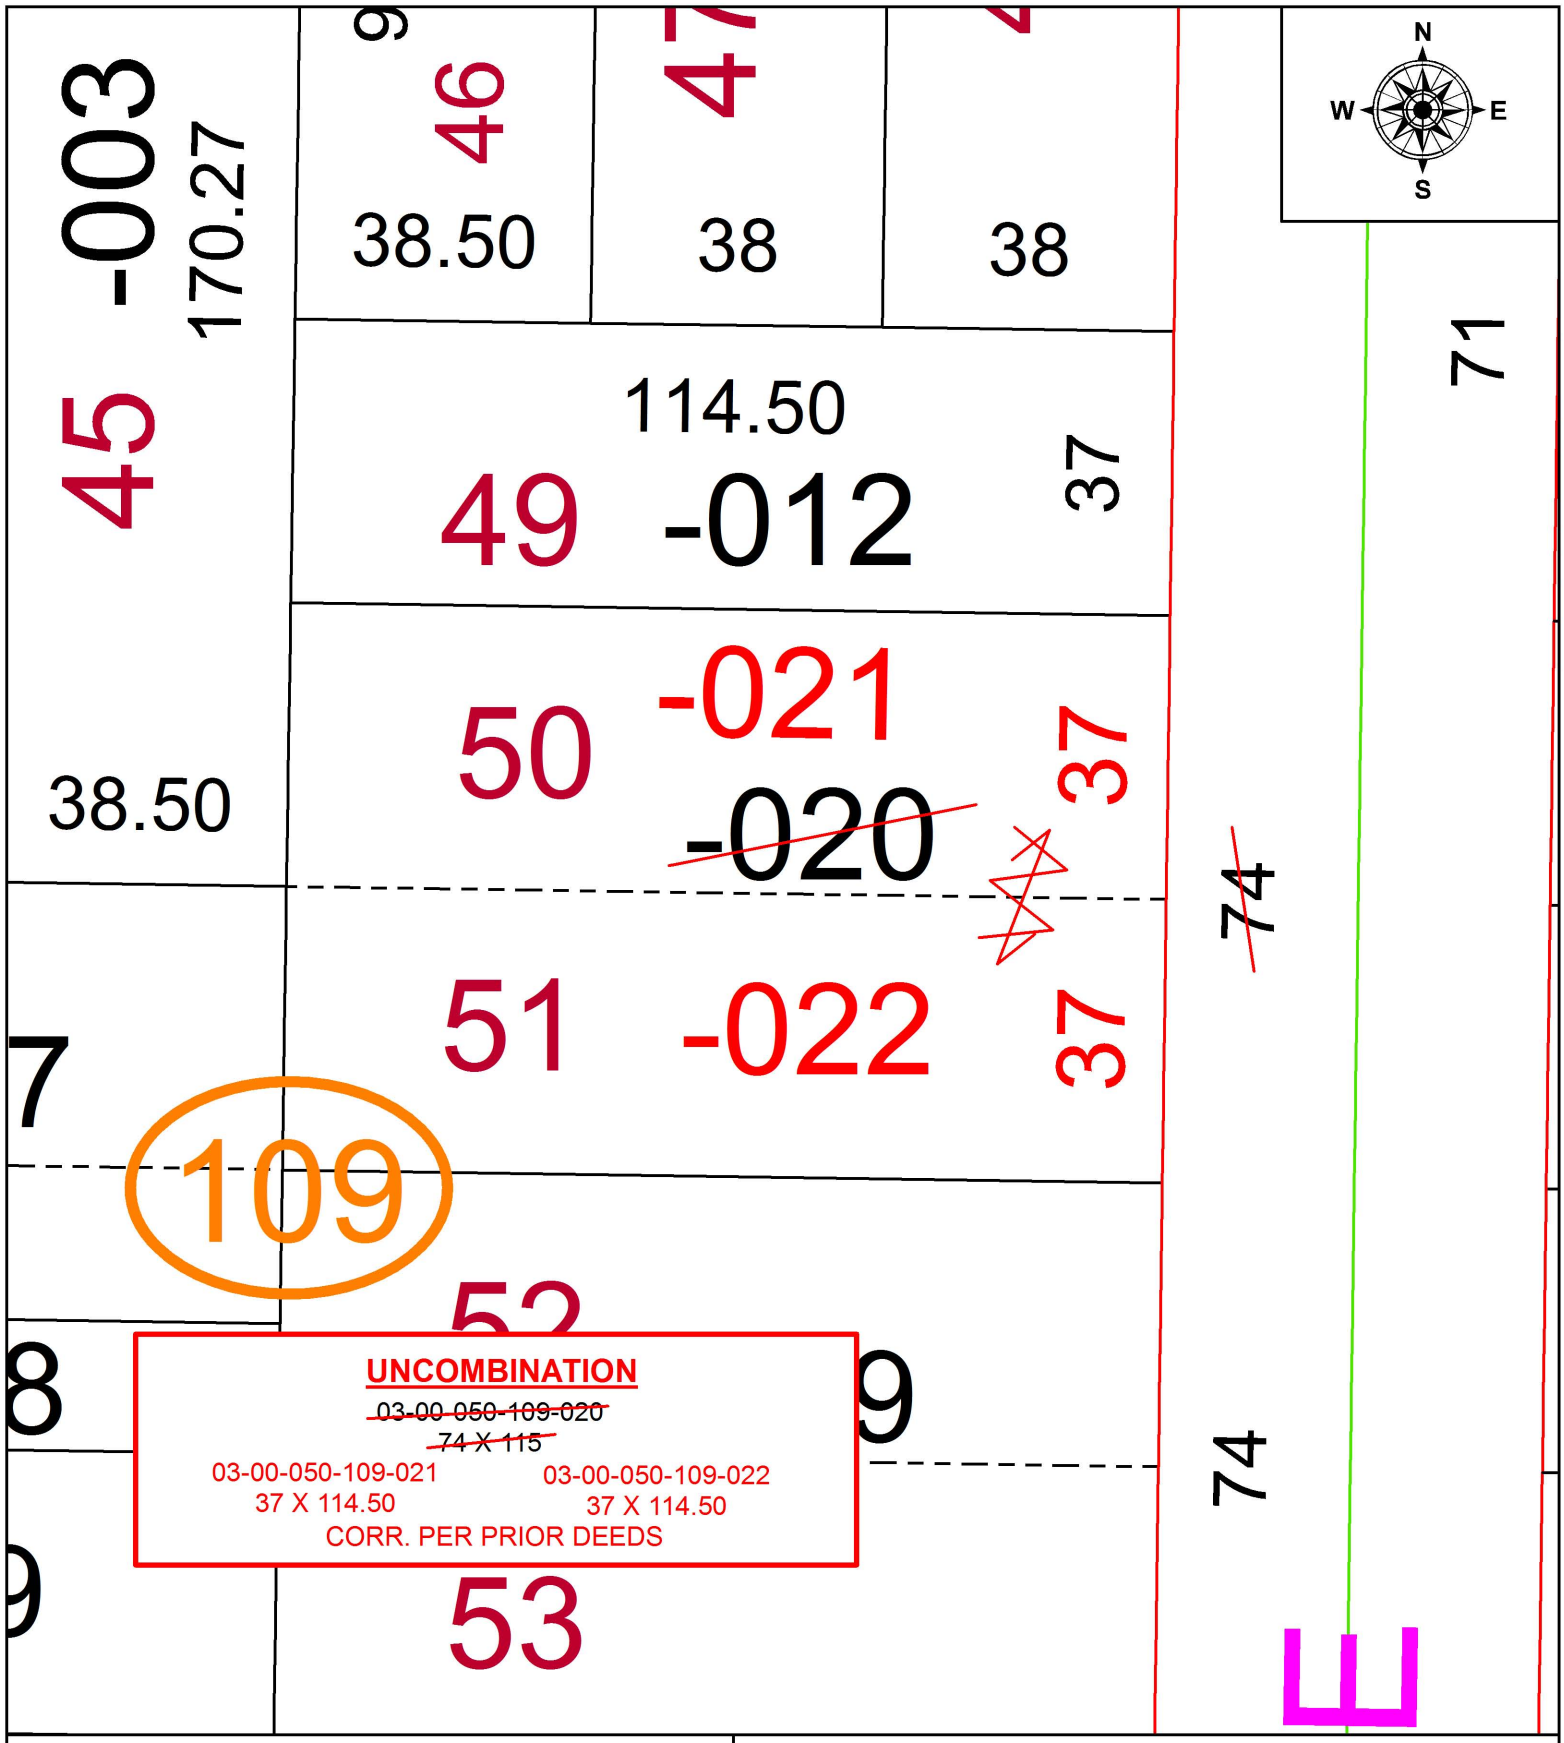

SPLITS/DEEDS PROCESSED
LORAIN COUNTY TAX MAP DEPARTMENT
226 MIDDLE AVE. ELYRIA, OH

SURVEYED BY: N/A
CLOSURE: N/A
MAP PAGE(S): 3-00-050
APPOVED BY: RRM **DATE:** 4-7-17
SCALE: 1" = 25 **PRIOR INSTRUMENT:** 20150548532