PARENT PARCEL: 16-00-087-000-003
CHILD PARCEL: 16-00-087-000-018, -019
STARTING POINT: CENTERLINE OF NEFF RD & O.L. 87

17-03646

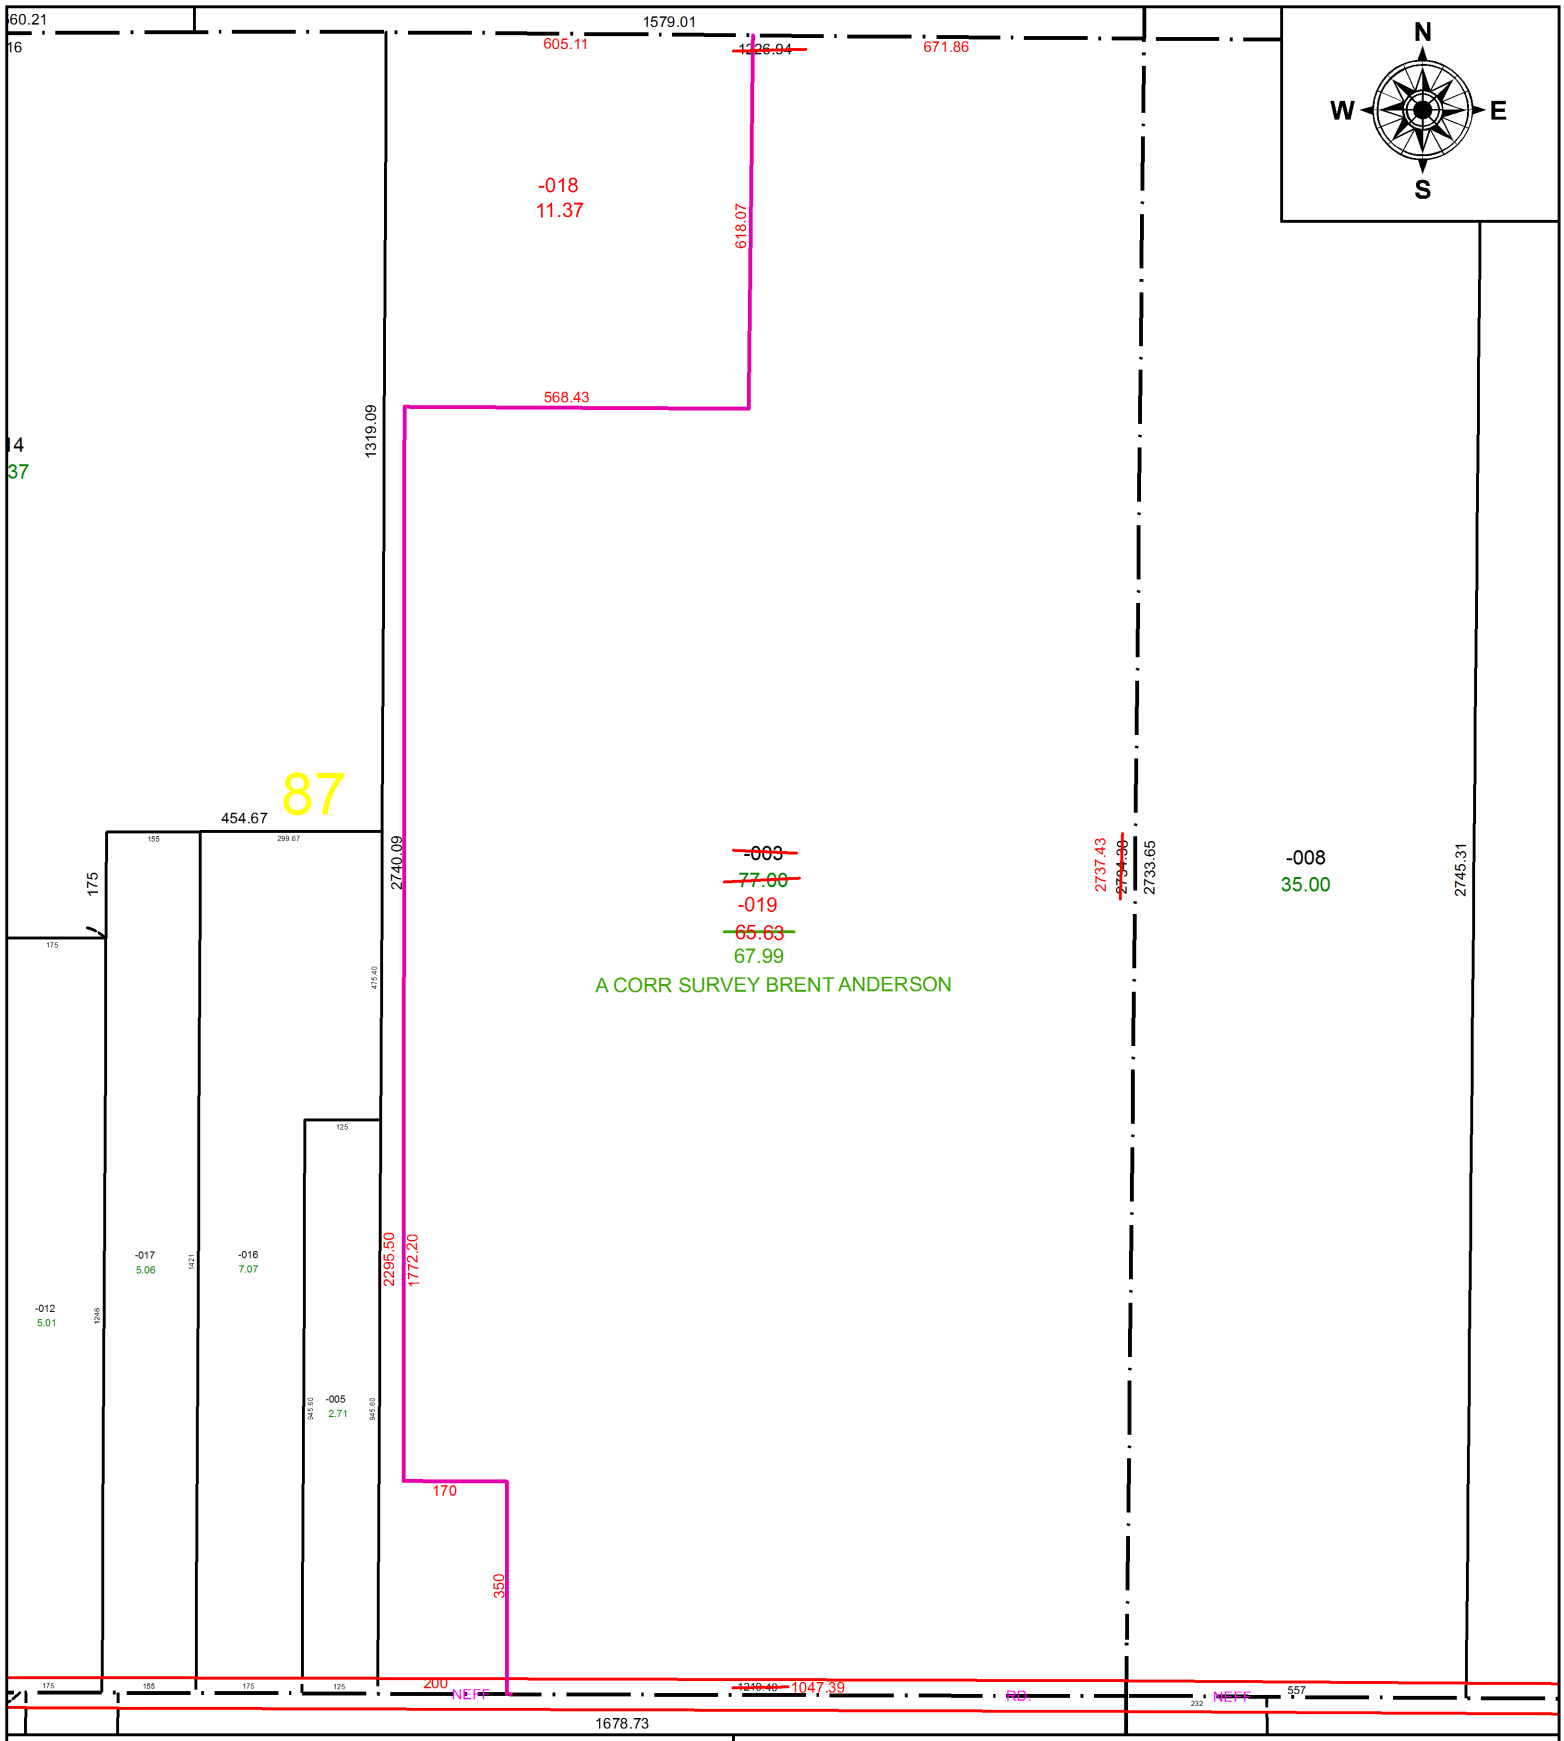

SPLITS/DEEDS PROCESSED

LORAIN COUNTY TAX MAP DEPARTMENT
226 MIDDLE AVE. ELYRIA, OH

SURVEYED BY: BRENT ANDERSON
CLOSURE: 1: 3800
MAP PAGE(S): 16-00-087
APPOVED BY: JAH **DATE:** 3/3/17
SCALE: 1 in = 317 ft **PRIOR INSTRUMENT:** OR 1431/70