PARENT PARCEL: 03-00-104-101-045, -046
CHILD PARCEL: 03-00-104-101-052 THRU -054
STARTING POINT: INTERSECTION OF C/L OF CLINTON AVE AND SOUTH LINE OF O.L.105

17-03649

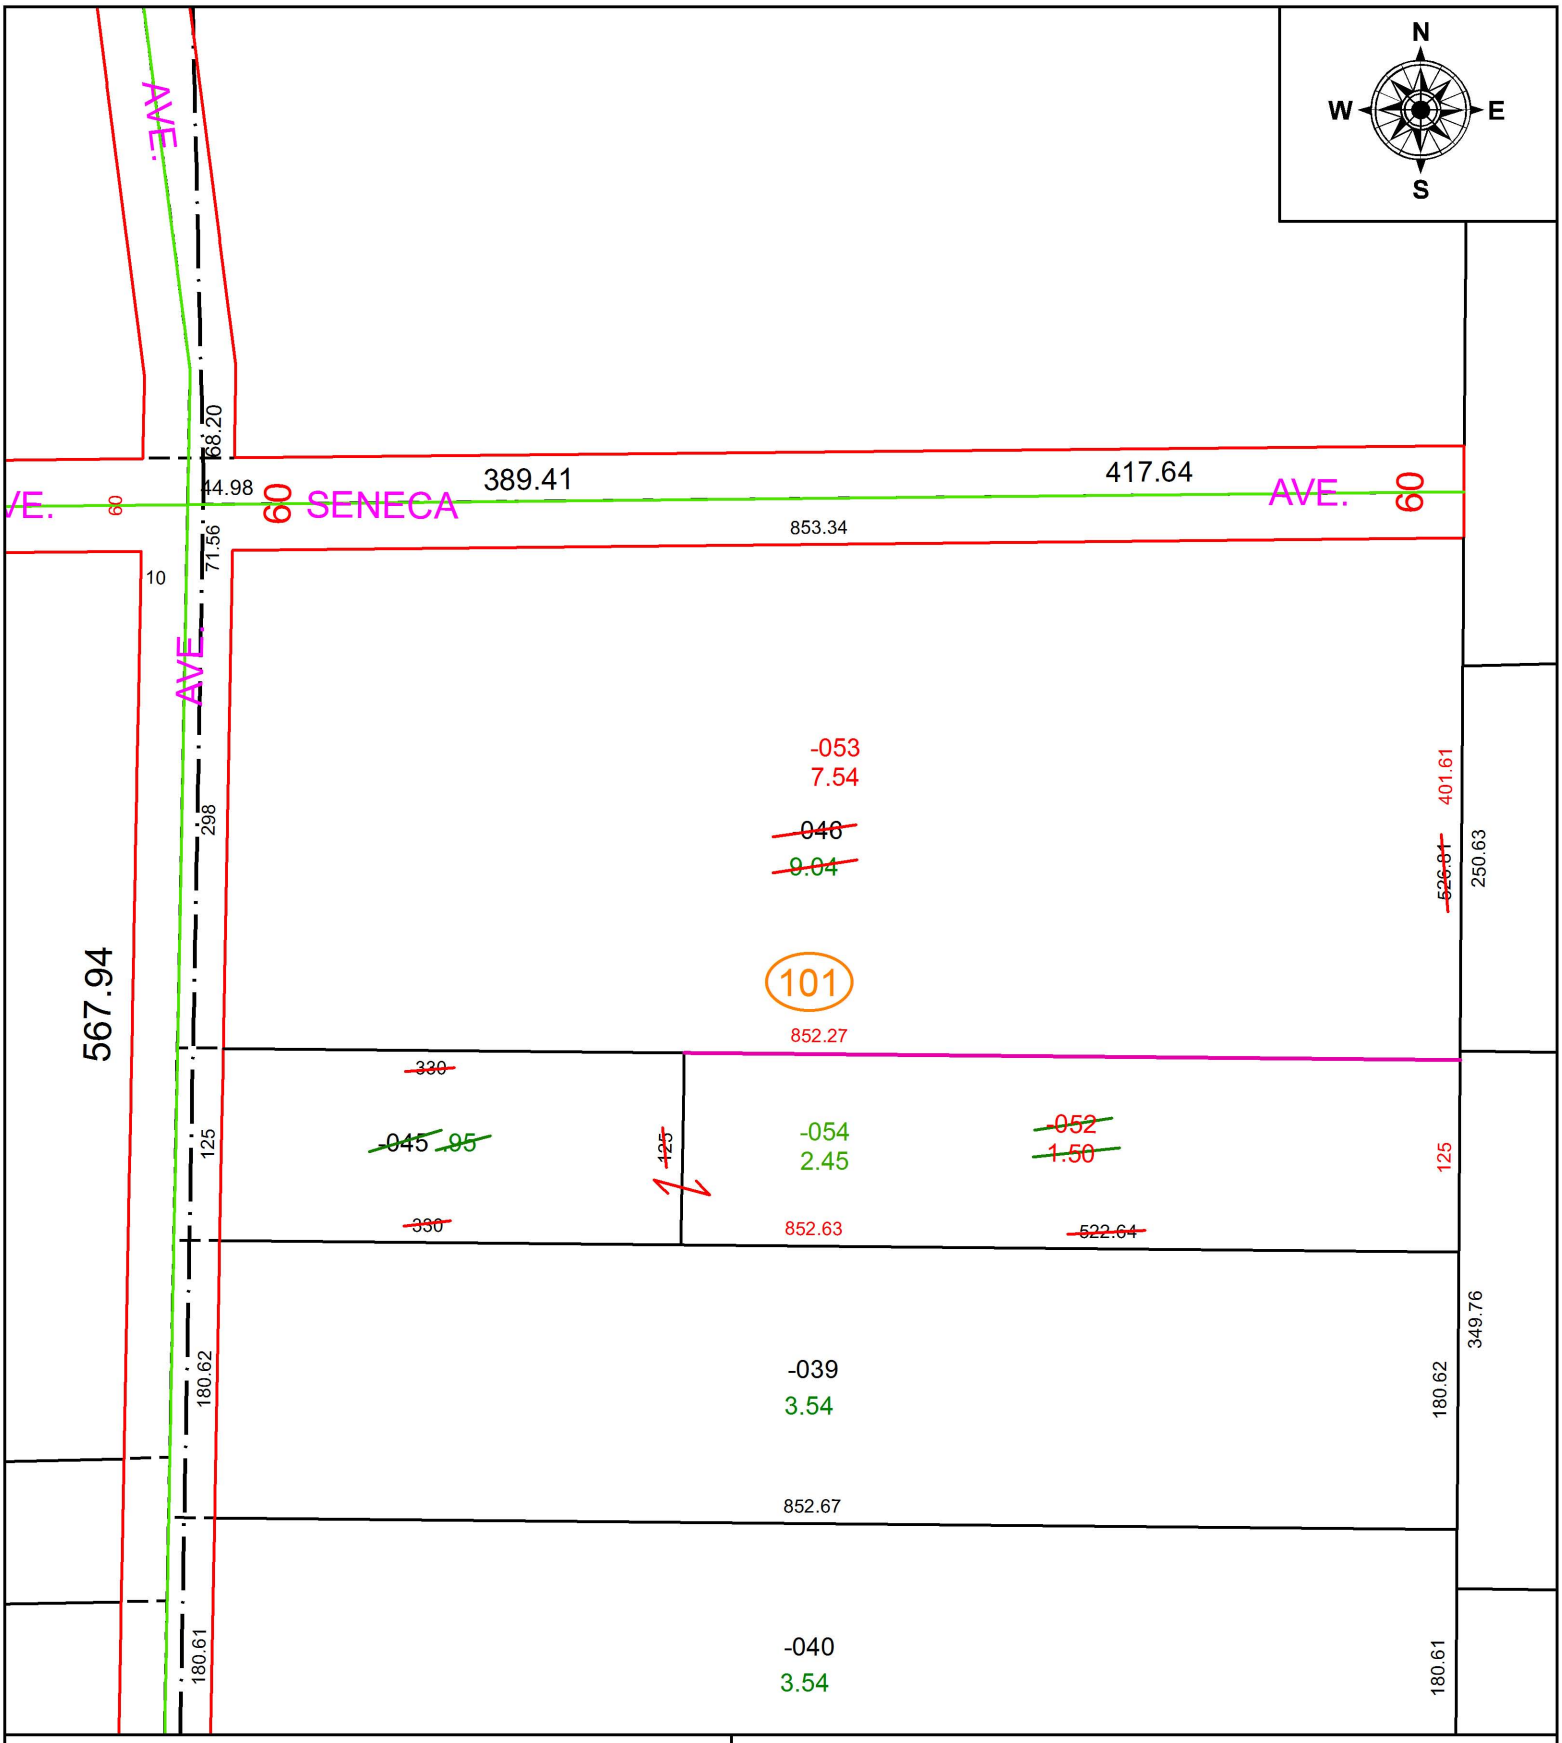

SPLITS/DEEDS PROCESSED
LORAIN COUNTY TAX MAP DEPARTMENT
226 MIDDLE AVE. ELYRIA, OH

SURVEYED BY: PATRICK A. MCGANNON
CLOSURE: 1: 105,077
MAP PAGE(S): 3-00-104
APPOVED BY: RRM **DATE:** 3-16-17
SCALE: 1" = 125 **PRIOR INSTRUMENT:** 20120423654