PARENT PARCEL: 04-00-014-104-031, 080
CHILD PARCEL: 04-00-014-104-085 THRU -089
STARTING POINT: INTERSECTION OF C/L OF KINZEL RD. AND C/L OF CREEKVIEW LN

17-03653

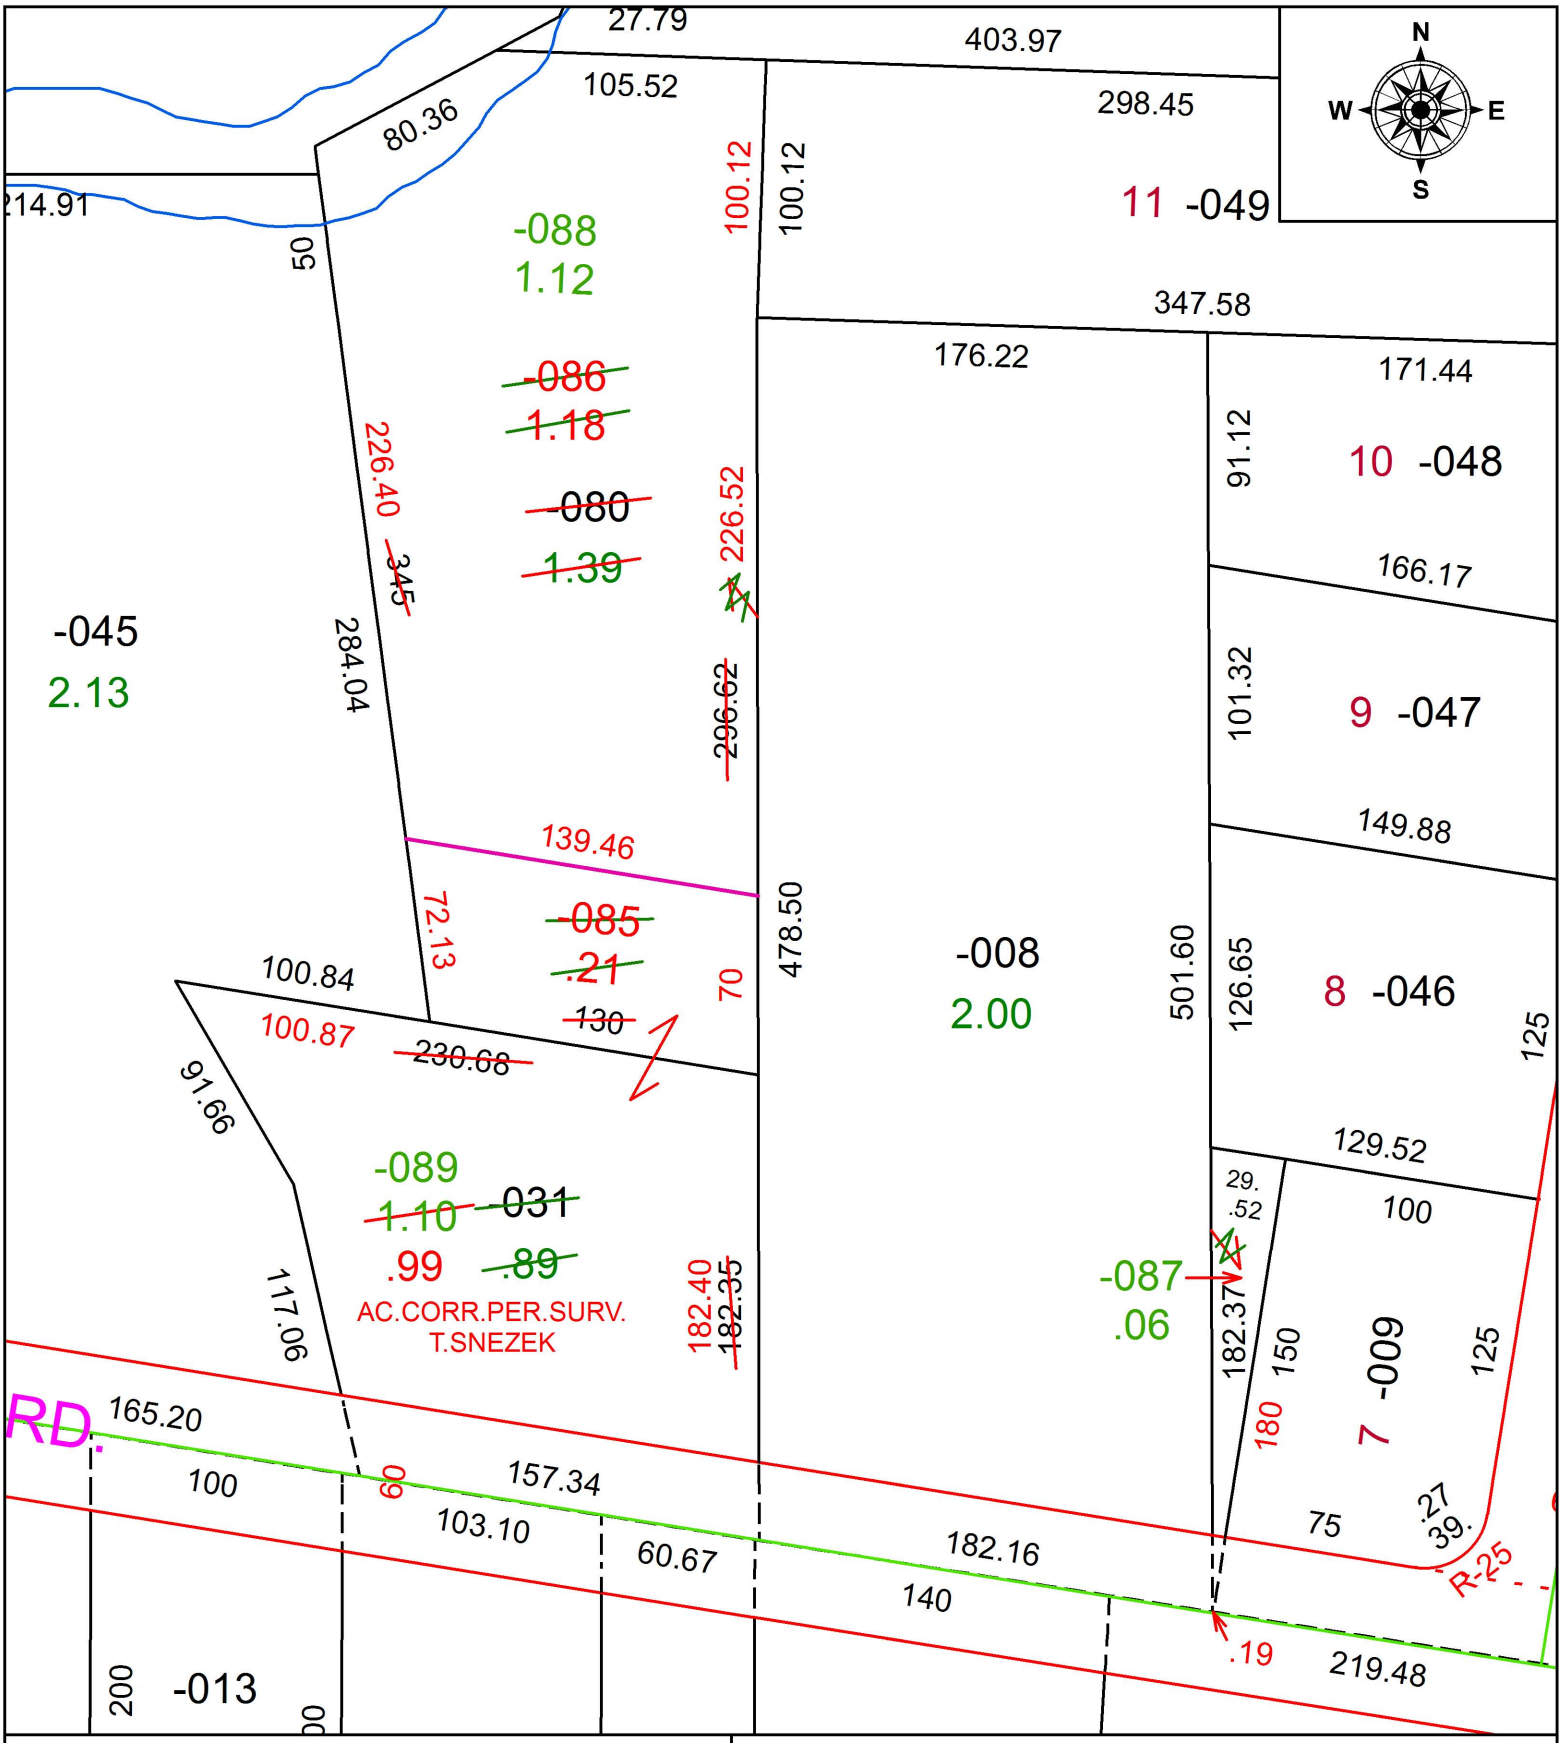

SPLITS/DEEDS PROCESSED
LORAIN COUNTY TAX MAP DEPARTMENT
226 MIDDLE AVE. ELYRIA, OH

SURVEYED BY: THOMAS M. SNEZEK
CLOSURE: 1: 164,385
MAP PAGE(S): 04-00-014
APPOVED BY: RRM **DATE:** 3-27-17
SCALE: 1" = 75 **PRIOR INSTRUMENT:** OR 1384/82