PARENT PARCEL: 05-00-006-000-219
CHILD PARCEL: XX-XX-XXX-XXX-XXX
STARTING POINT: INTERSECTION OF C/L MIDDLE RIDGE RD. AND C/L OF S. LAKE ST.

17-03658-X

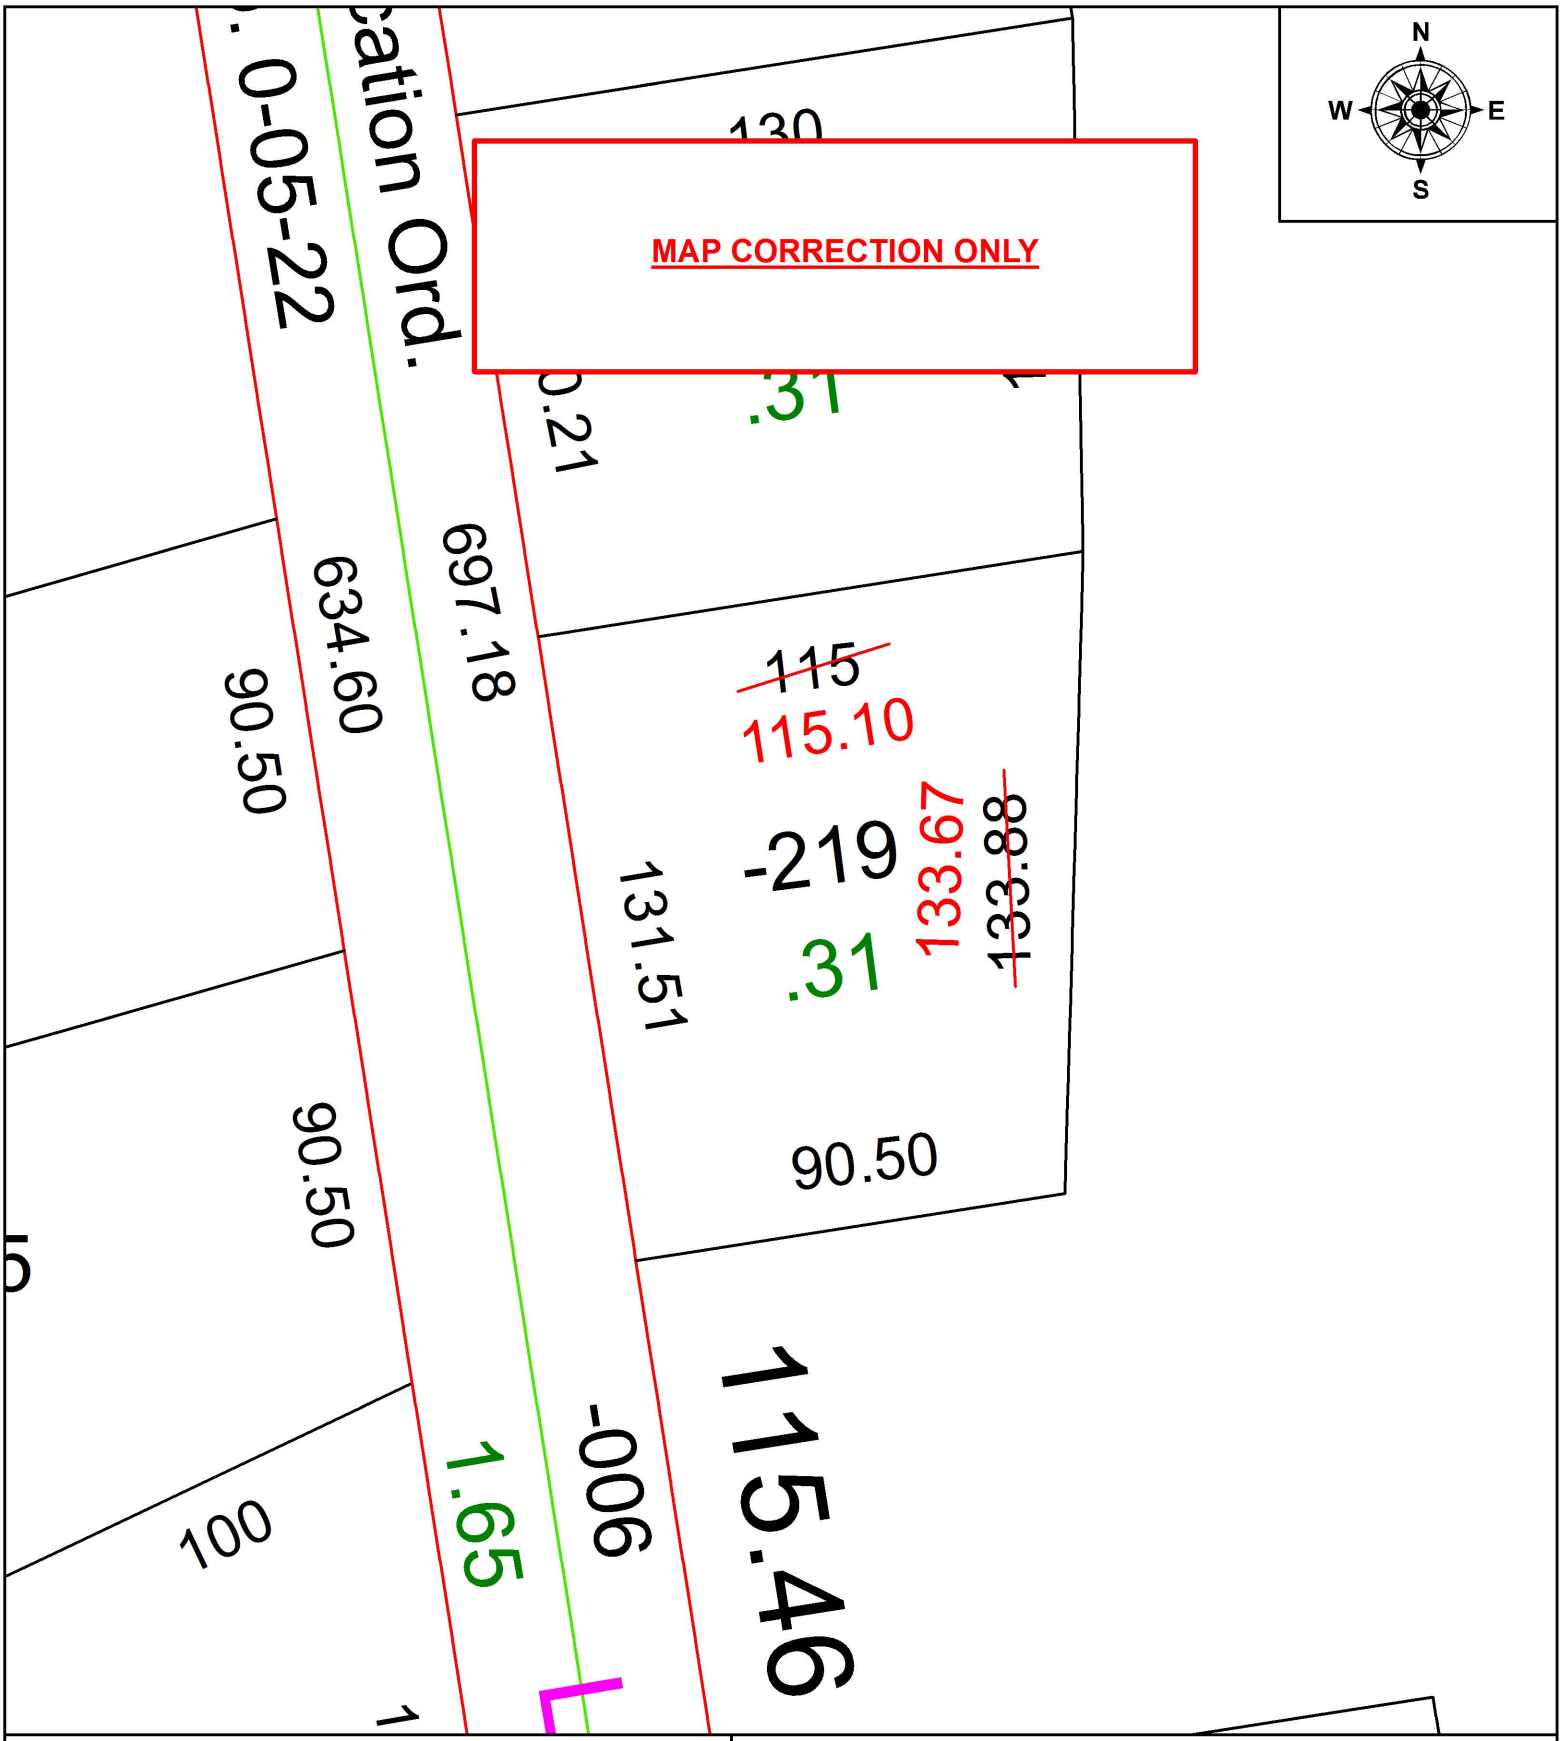

SPLITS/DEEDS PROCESSED
LORAIN COUNTY TAX MAP DEPARTMENT
226 MIDDLE AVE. ELYRIA, OH

SURVEYED BY: TIMOTHY D. HOZALSKI
CLOSURE: 1: 104,884
MAP PAGE(S): 5-00-006
APPOVED BY: RRM **DATE:** 4-21-17
SCALE: 1" = 40 **PRIOR INSTRUMENT:** 20050067758