PARENT PARCEL: 17-20-016-000-011
CHILD PARCEL: 17-20-016-000-033, -034
STARTING POINT: CENTERLINE OF GORE ORPHANGE RD & O.L. 6

17-03660

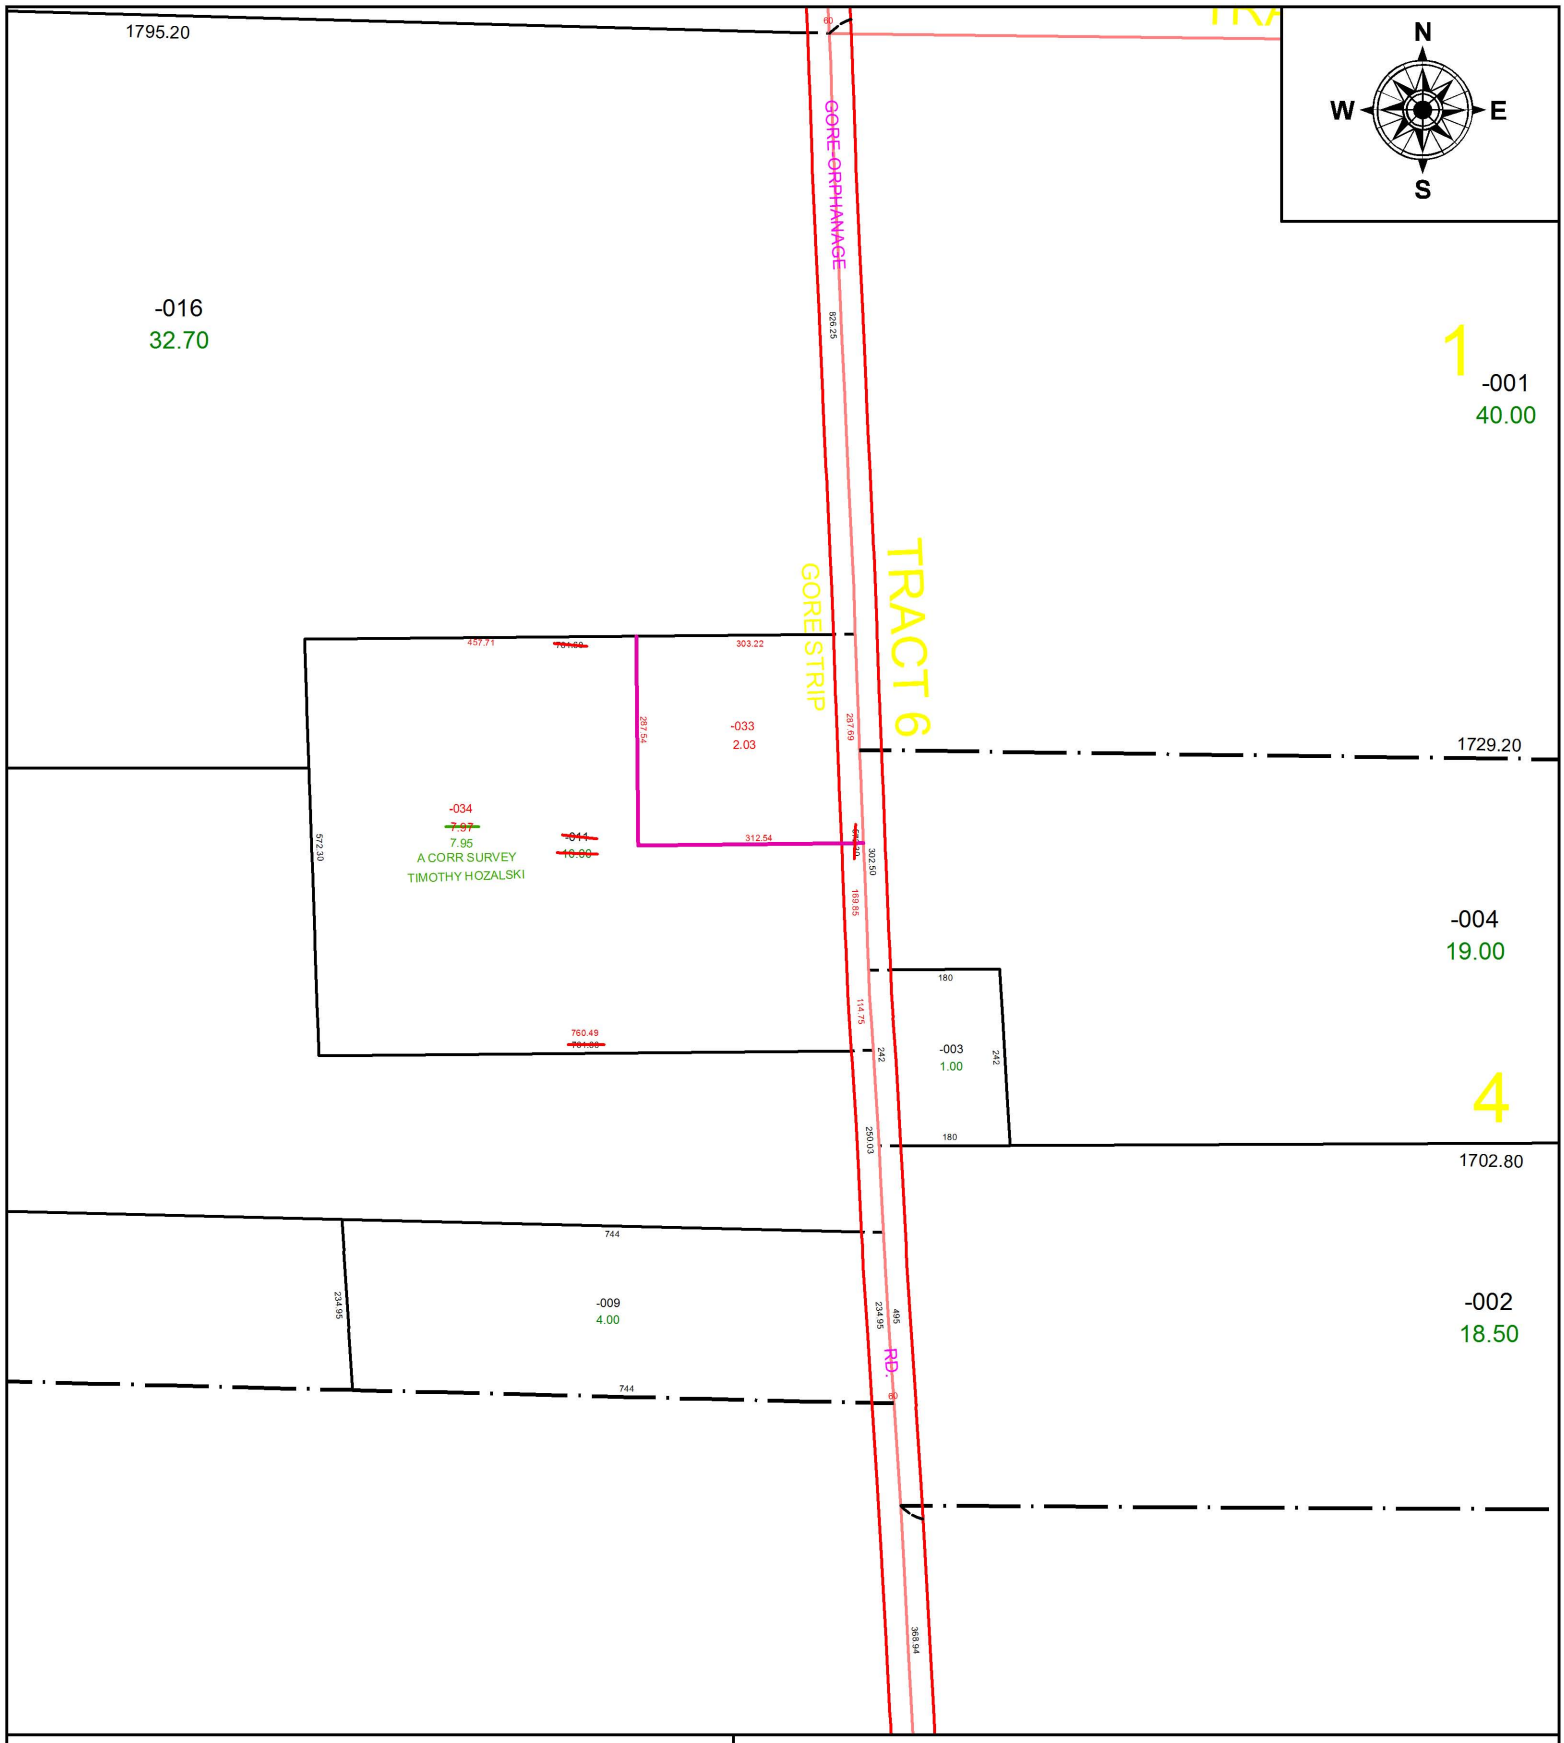

SPLITS/DEEDS PROCESSED

LORAIN COUNTY TAX MAP DEPARTMENT
226 MIDDLE AVE. ELYRIA, OH

SURVEYED BY: TIMONTHY HOZALSKI
CLOSURE: 1: 33,000
MAP PAGE(S): 17-20-016
APPOVED BY: JAH **DATE:** 4/18/2017
SCALE: 1 in = 264 ft **PRIOR INSTRUMENT:** 20160583767