PARENT PARCEL: 05-00-016-101-184
CHILD PARCEL: 05-00-016-101-187, -188
STARTING POINT: SOUTHEAST CORNER OF S/L 46 IN KEMPTON WOODS SUB NO 3

17-03661

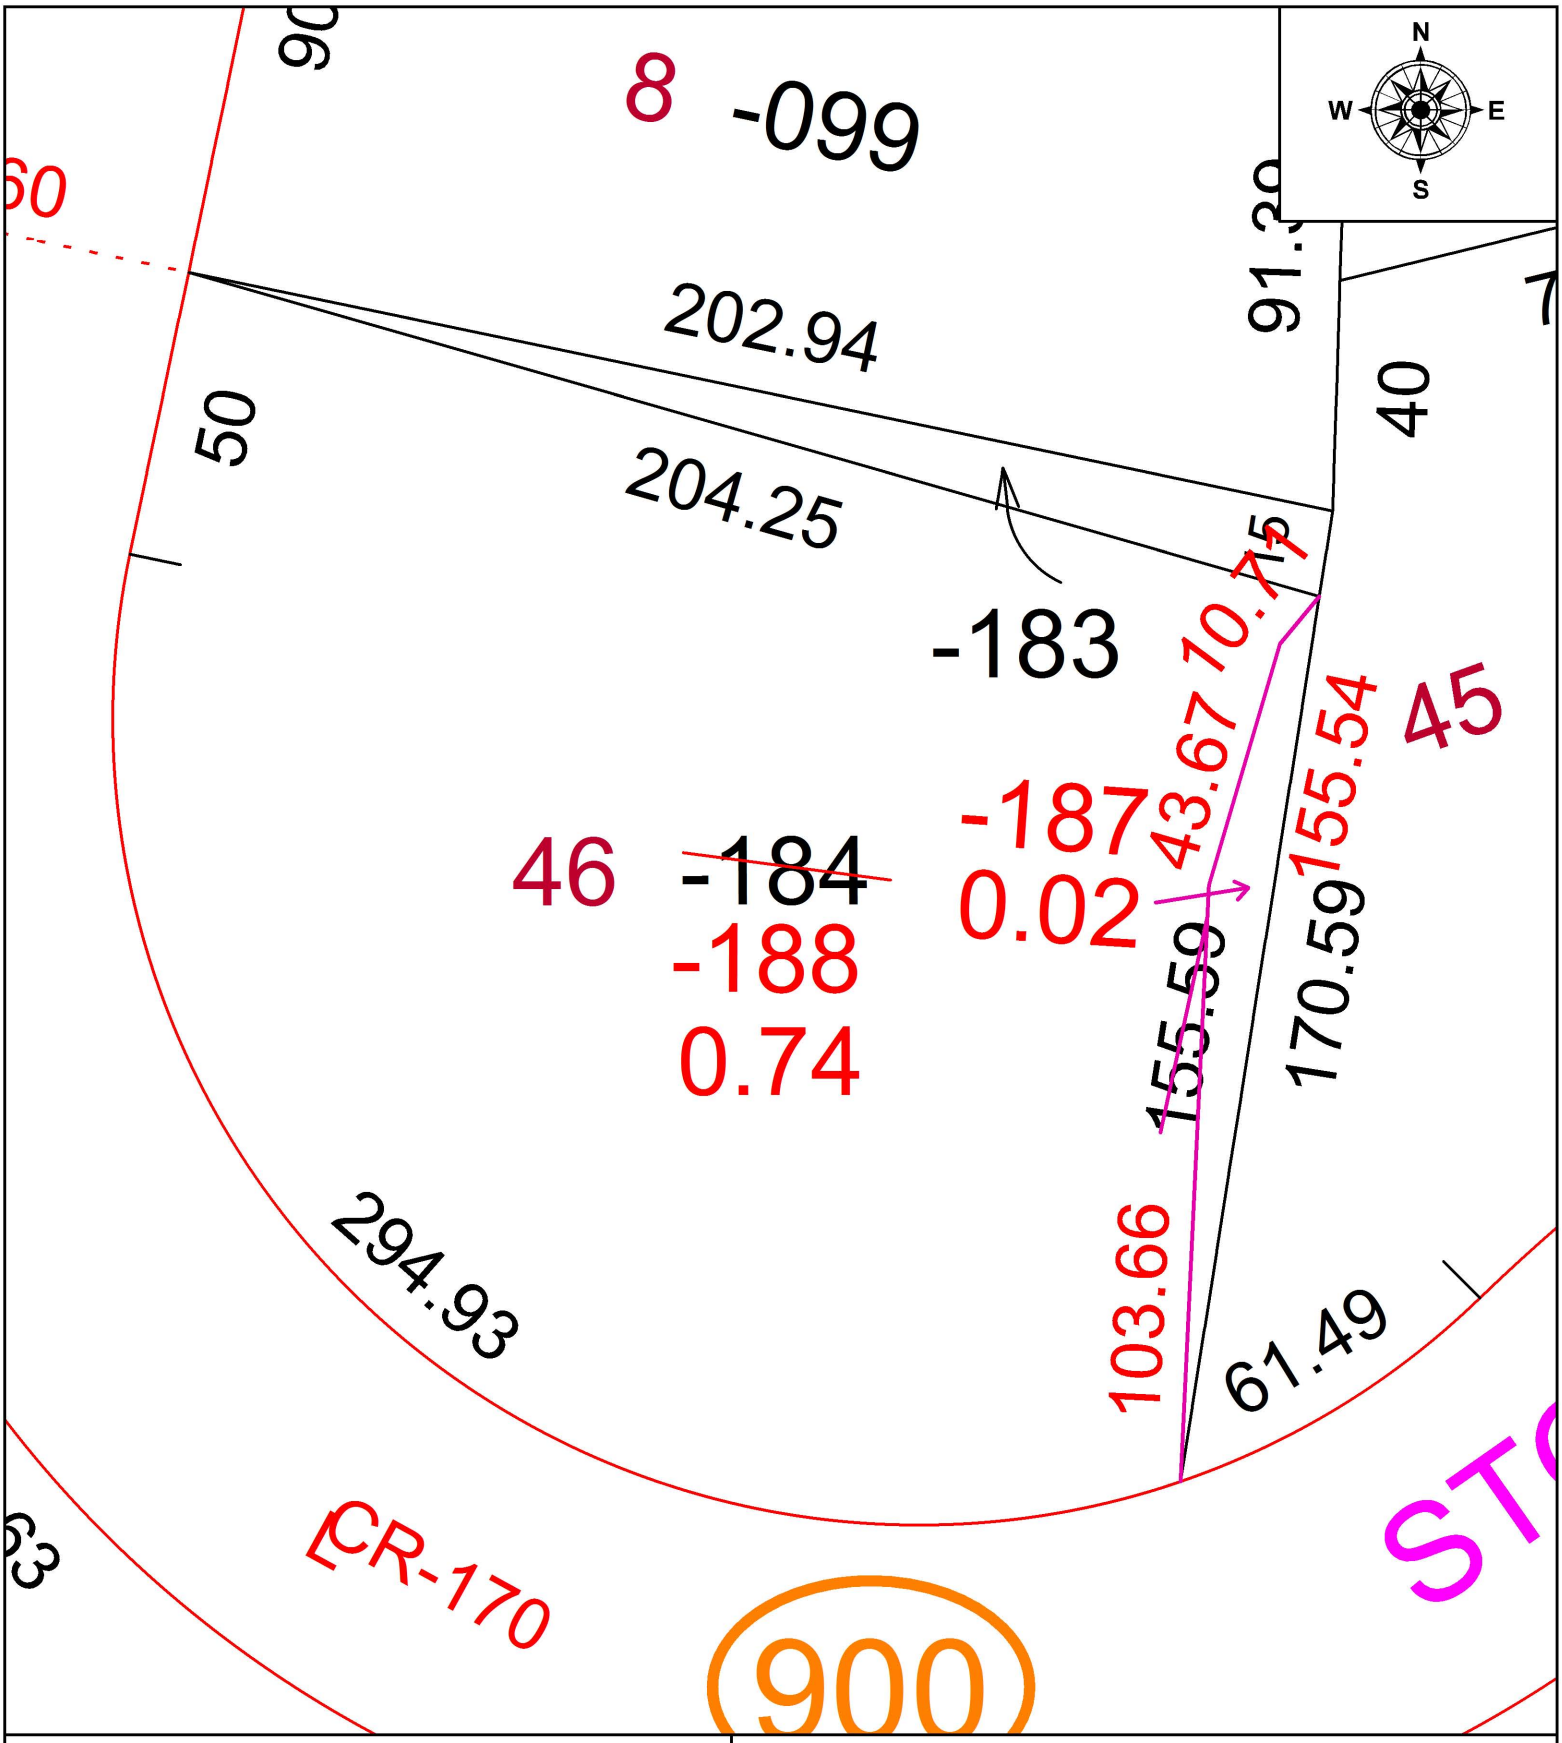

SPLITS/DEEDS PROCESSED
LORAIN COUNTY TAX MAP DEPARTMENT
226 MIDDLE AVE. ELYRIA, OH

SURVEYED BY: PATRICK MCGANNON
CLOSURE: 1: 33,000
MAP PAGE(S): 05-00-016
APPOVED BY: JAH **DATE:** 4/19/2017
SCALE: 1 in = 33 ft **PRIOR INSTRUMENT:** 20130489993