PARENT PARCEL: 12-00-068-000-011

CHILD PARCEL: 12-00-068-000-018, -019

STARTING POINT: SOUTHEAST CORNER OF O.L.68

17-03664

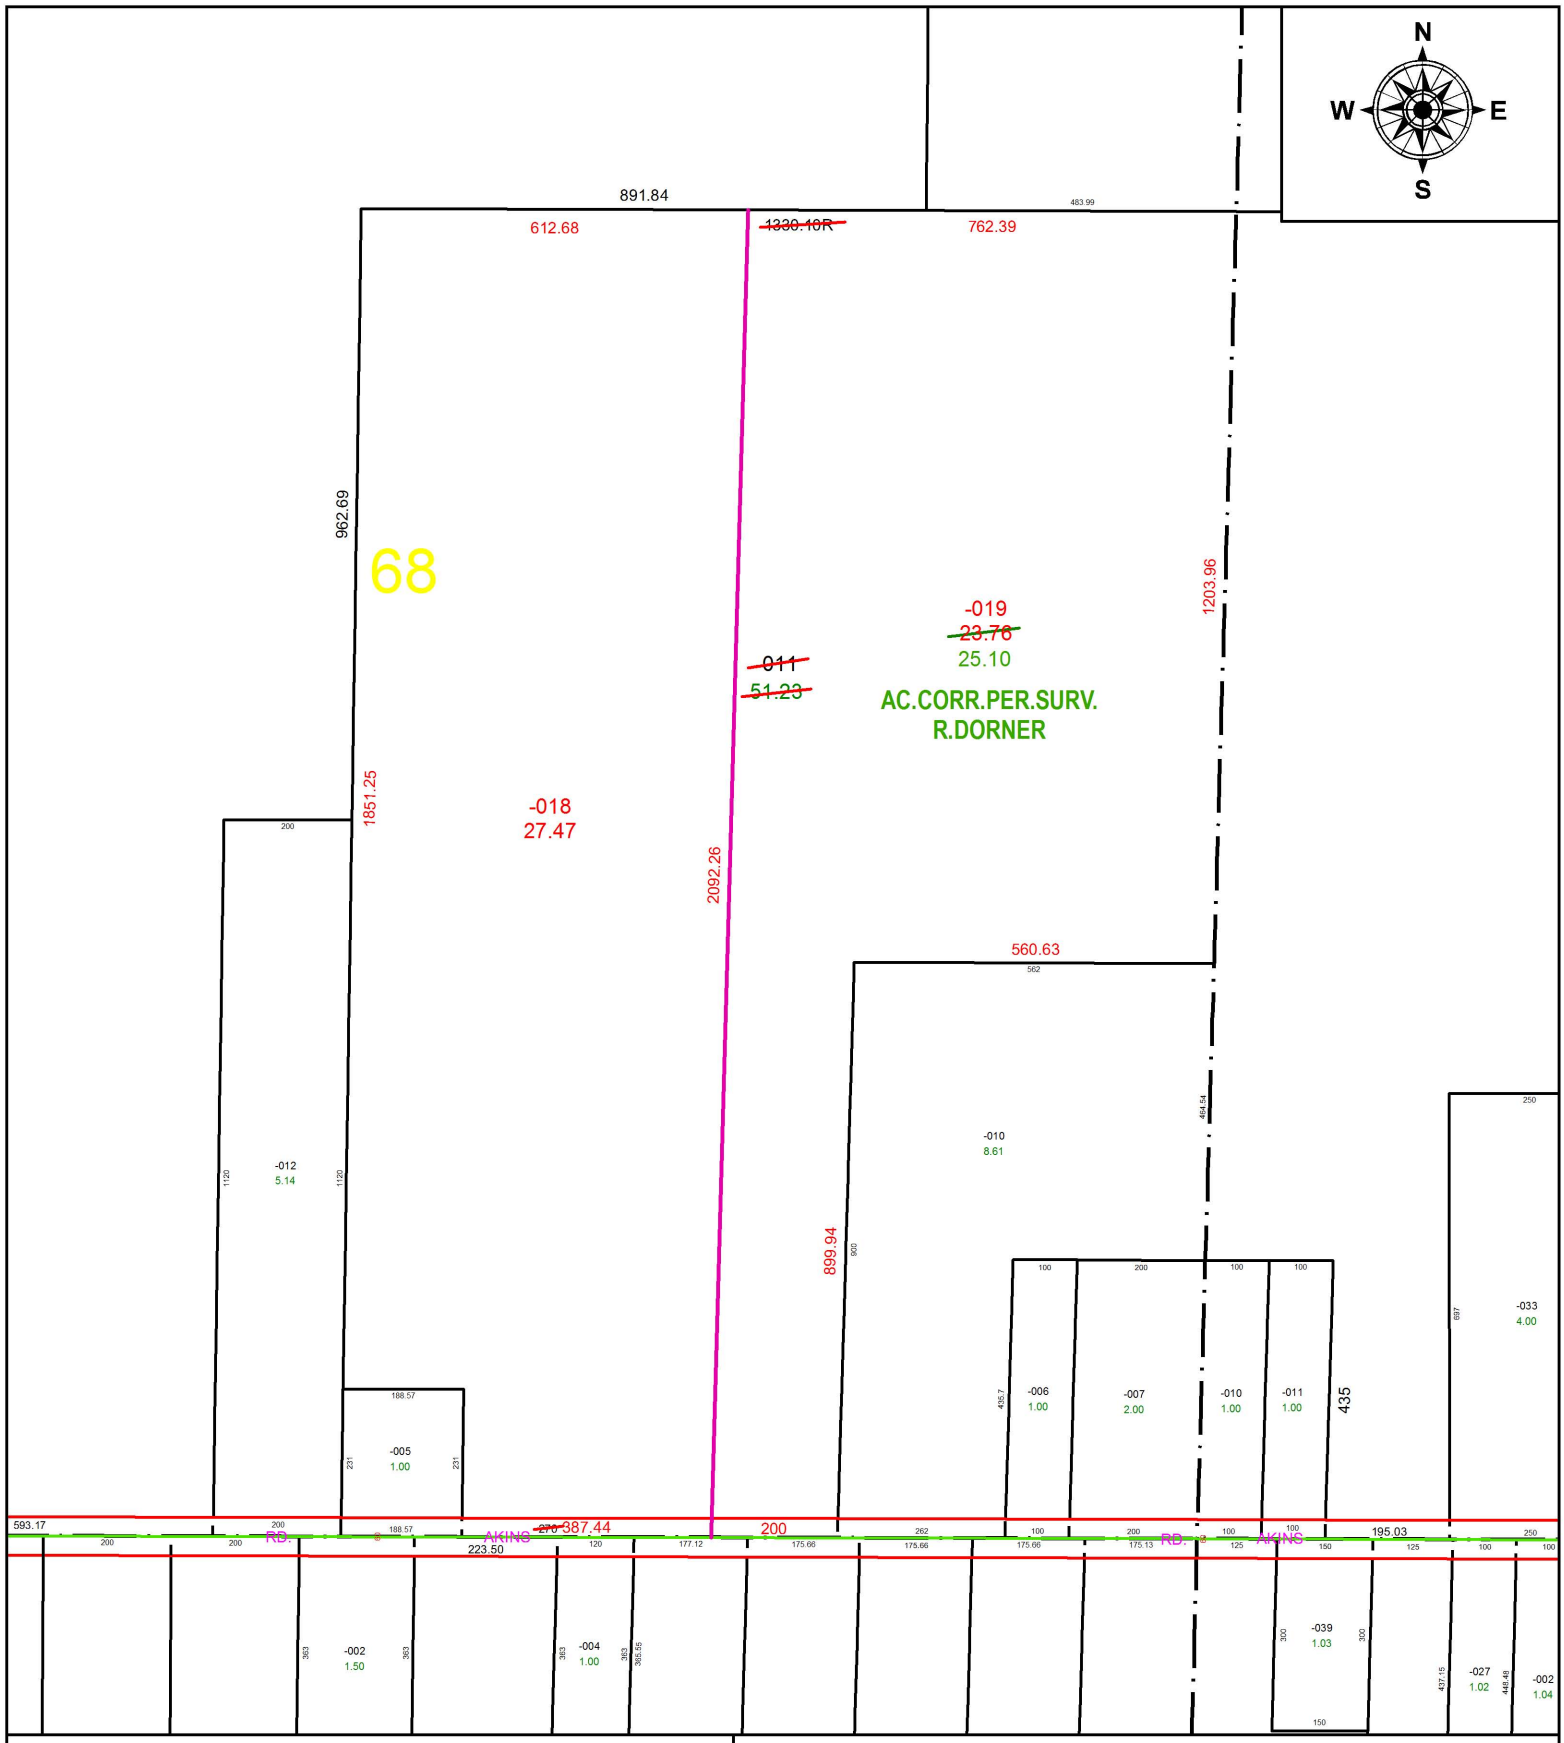

SPLITS/DEEDS PROCESSED

LORAIN COUNTY TAX MAP DEPARTMENT
226 MIDDLE AVE. ELYRIA, OH

SURVEYED BY: ROBERT A. DORNER

CLOSURE: 1: 1,790,331

MAP PAGE(S): 12-00-068

APPOVED BY: RRM **DATE:** 5-1-17

SCALE: 1" = 300 **PRIOR INSTRUMENT:** DV 1263/752