PARENT PARCEL: 04-00-015-101-136 THRU -139

CHILD PARCEL: 04-00-015-101-145 THRU -148

STARTING POINT: INTERSECTION OF C/L OF DETROIT RD. AND C/L OF HEALTHWAY DR.

17-03665

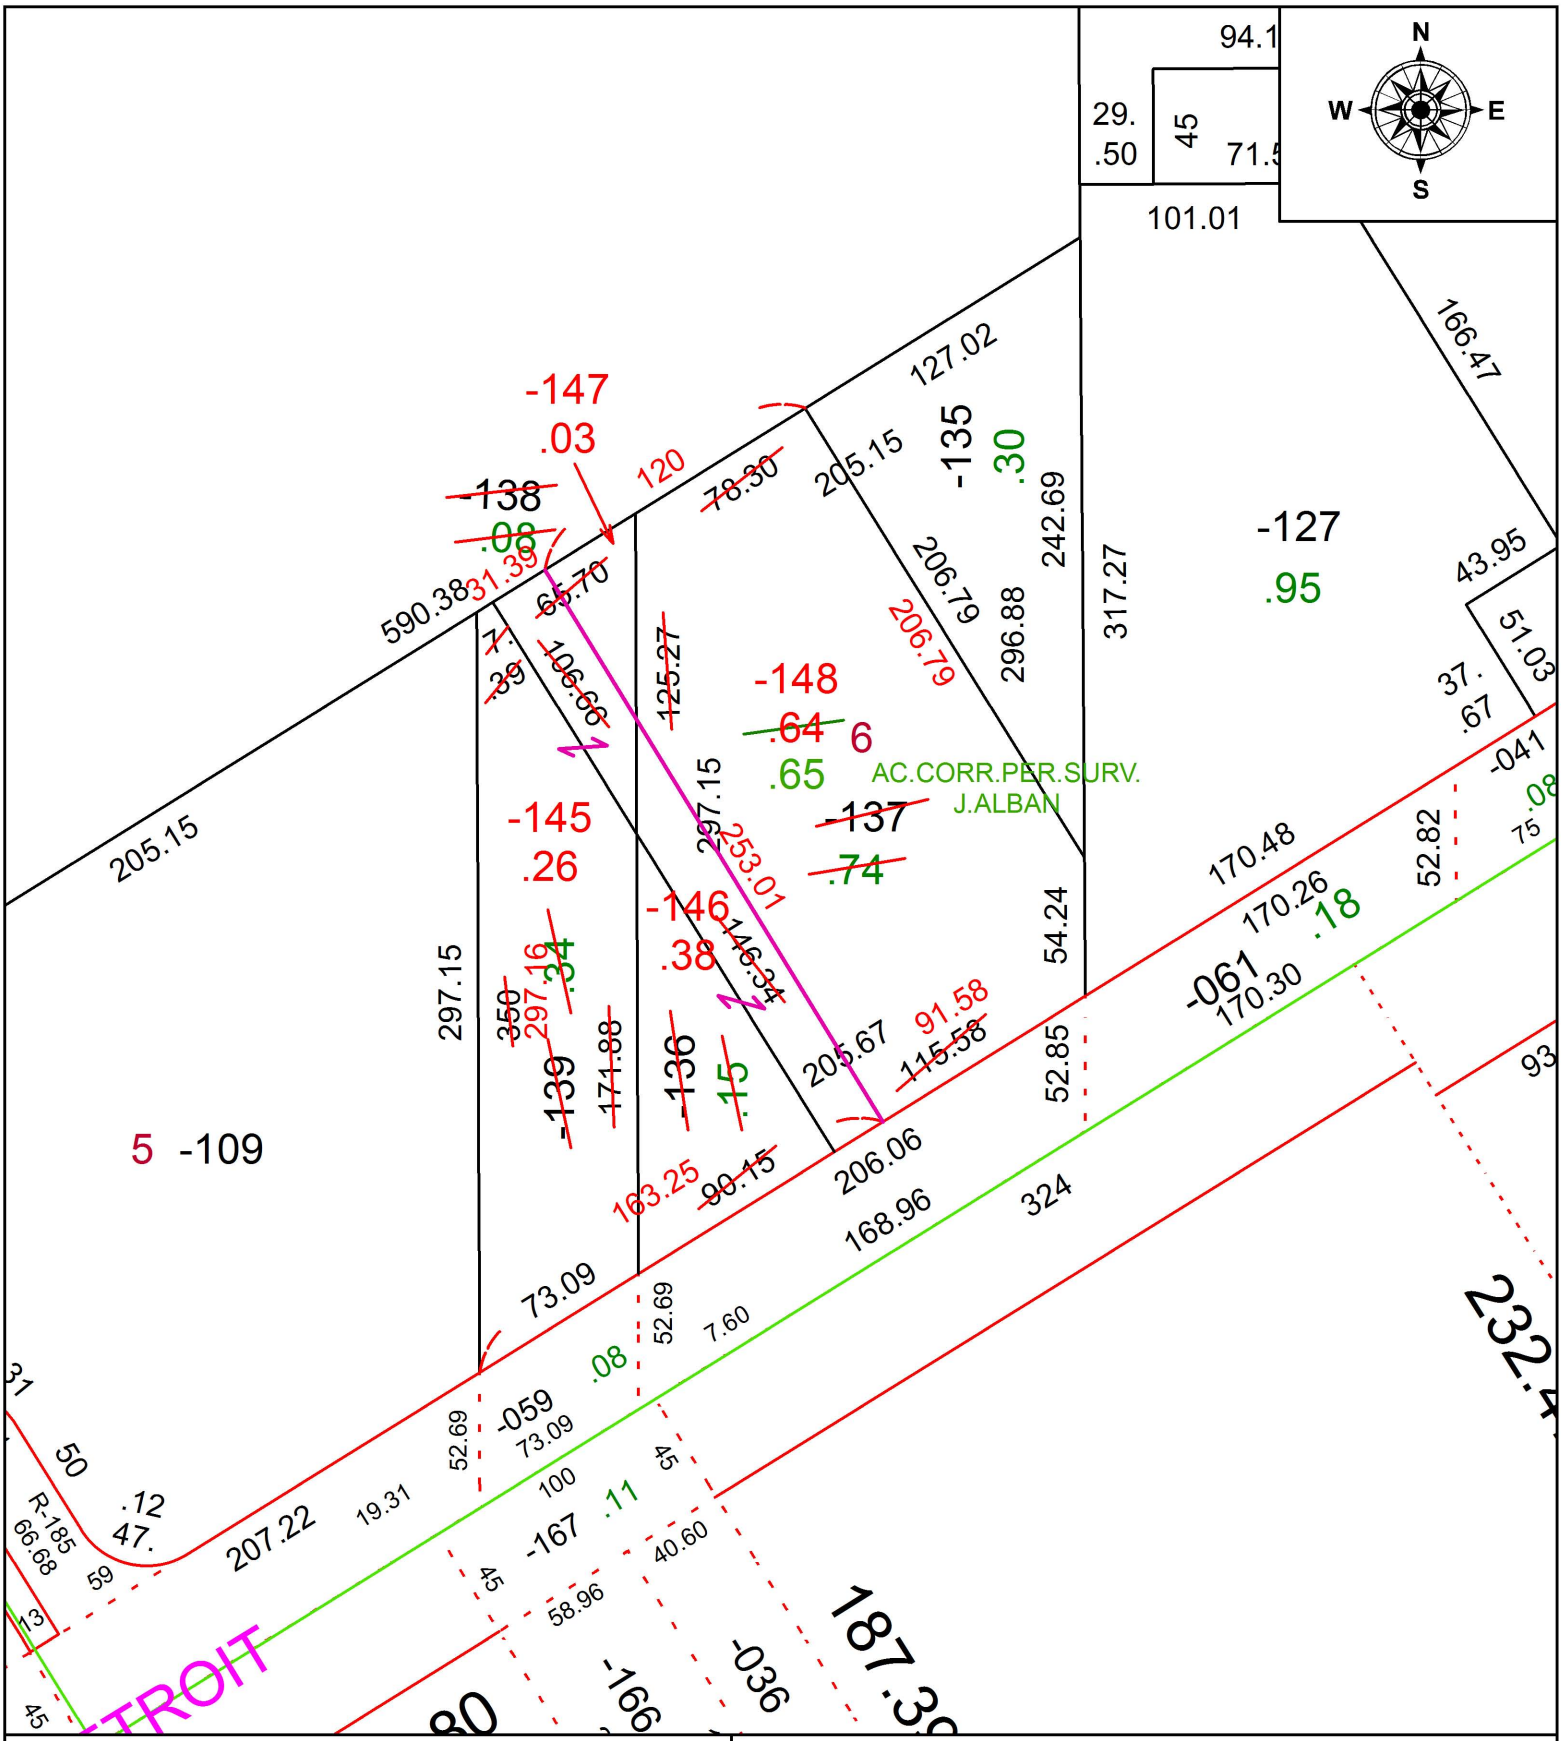

SPLITS/DEEDS PROCESSED

LORAIN COUNTY TAX MAP DEPARTMENT
226 MIDDLE AVE. ELYRIA, OH

SURVEYED BY: JOHN R. ALBAN
CLOSURE: 1: 144252.48
MAP PAGE(S): 4-00-015
APPOVED BY: RRM **DATE:** 5-8-17
SCALE: 1" = 75 **PRIOR INSTRUMENT:** 20170623174